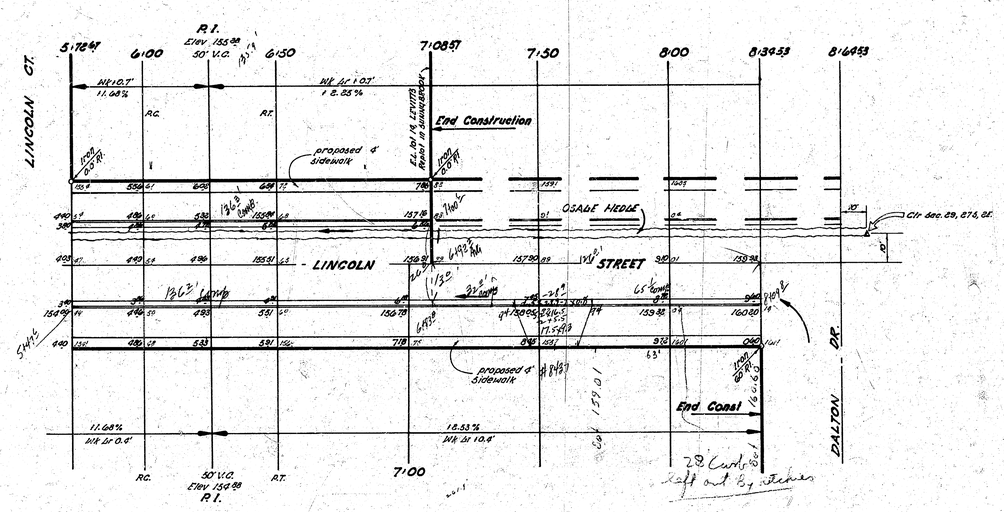
LINCOLN CT.
P.I.
Elev. 155.98
50' V.C.
5+76.47
6+00
6+50
7+08.57
7+50
8+00
8+34.53
8+64.53
End Construction
proposed 4' Sidewalk
OSAGE HEDGE
Clr. Sec. 29, 27S, 2E.
LINCOLN
STREET
DALTON
DR.
End Const.
28' Curb
left out by Pitcher
7+00
50' V.C.
Elev. 154.98
P.I.

B.M.: 151.48 S.W. Cor conc porch N.S. LEVITT 15' W. of E.L. Blackwill Ho. # 8808 LEVITT.
B.M.: 143.28 S.E. Cor conc slab @ S.E. Cor House # 8324 LEVITT.
B.M.: 147.68 Ft. in Ribbie W. Cb. WICKER LANE - S.L. LEVITT Drive.

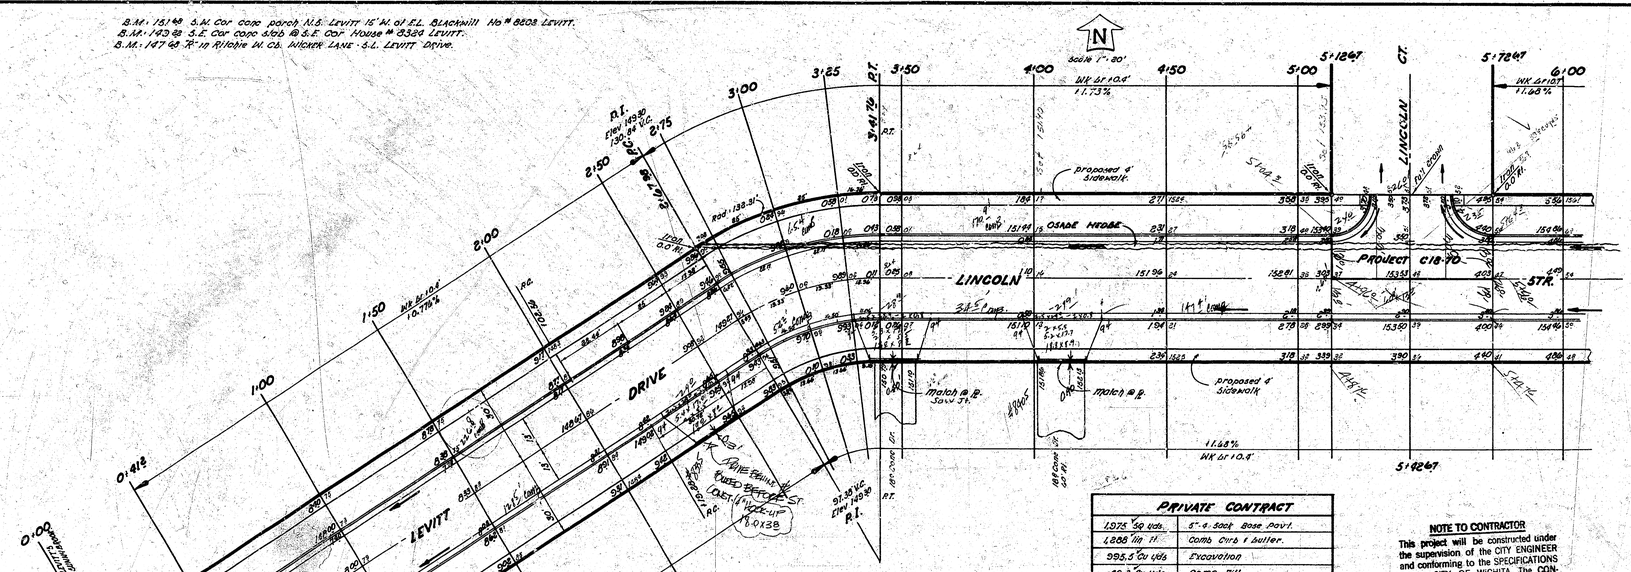

Station	Def	Total Def	8' O.S. Ft. N. Cb.	Chord	8' O.S. Ft. So. Cb.	Chord
P.C. 2+67.98	0° 00' 00"	0° 00' 00"				
2+75.0	1° 31' 0"	1° 31' 0"	6.65'	6.65'	4.80'	4.80'
3+00	5° 24' 30"	6° 55' 30"	23.48'	23.42'	14.99'	14.95'
3+85	5° 24' 30"	12° 20' 00"	23.48'	23.42'	14.99'	14.95'
P.T. 3+41.76	3° 37' 25"	15° 57' 25"	15.87'	15.84'	10.05'	10.02'

PRIVATE CONTRACT	
1,075 Sq yds.	5"-6" Sack Base Pavt.
1,885 lin ft.	Comb. Curb & Gutter.
395.5 Cu yds	Excavation
40.2 Cu yds	Comp. Fill
410 lin ft.	Osage Hedge Removed
202 Sq ft	Separate Gutter
6,080 lbs	Rein. Steel
1,430 lin ft	Key Joint
20 Sq ft	Drive Removed
86 lin ft	Saw Joint

NOTE TO CONTRACTOR

This project will be constructed under the supervision of the CITY ENGINEER and conforming to the SPECIFICATIONS of the CITY OF WICHITA. The CONTRACTOR will reimburse the City of Wichita for all cost of Engineering, Plans, and Inspection.

Intersection LINCOLN STR and LINCOLN COURT. PROJECT No. C18-70

LEVITT DRIVE. E.L. CASTLE DRIVE to LINCOLN ST. LINCOLN ST. LEVITT DRIVE. to DALTON DRIVE.

26'-2"-30' ASPH. CONC.

City of Wichita, Kansas

B.E. SMITH City Engineer.

DATE: July 1968 Private Project.

Survey Plans
Plat
Exc.
Checked