




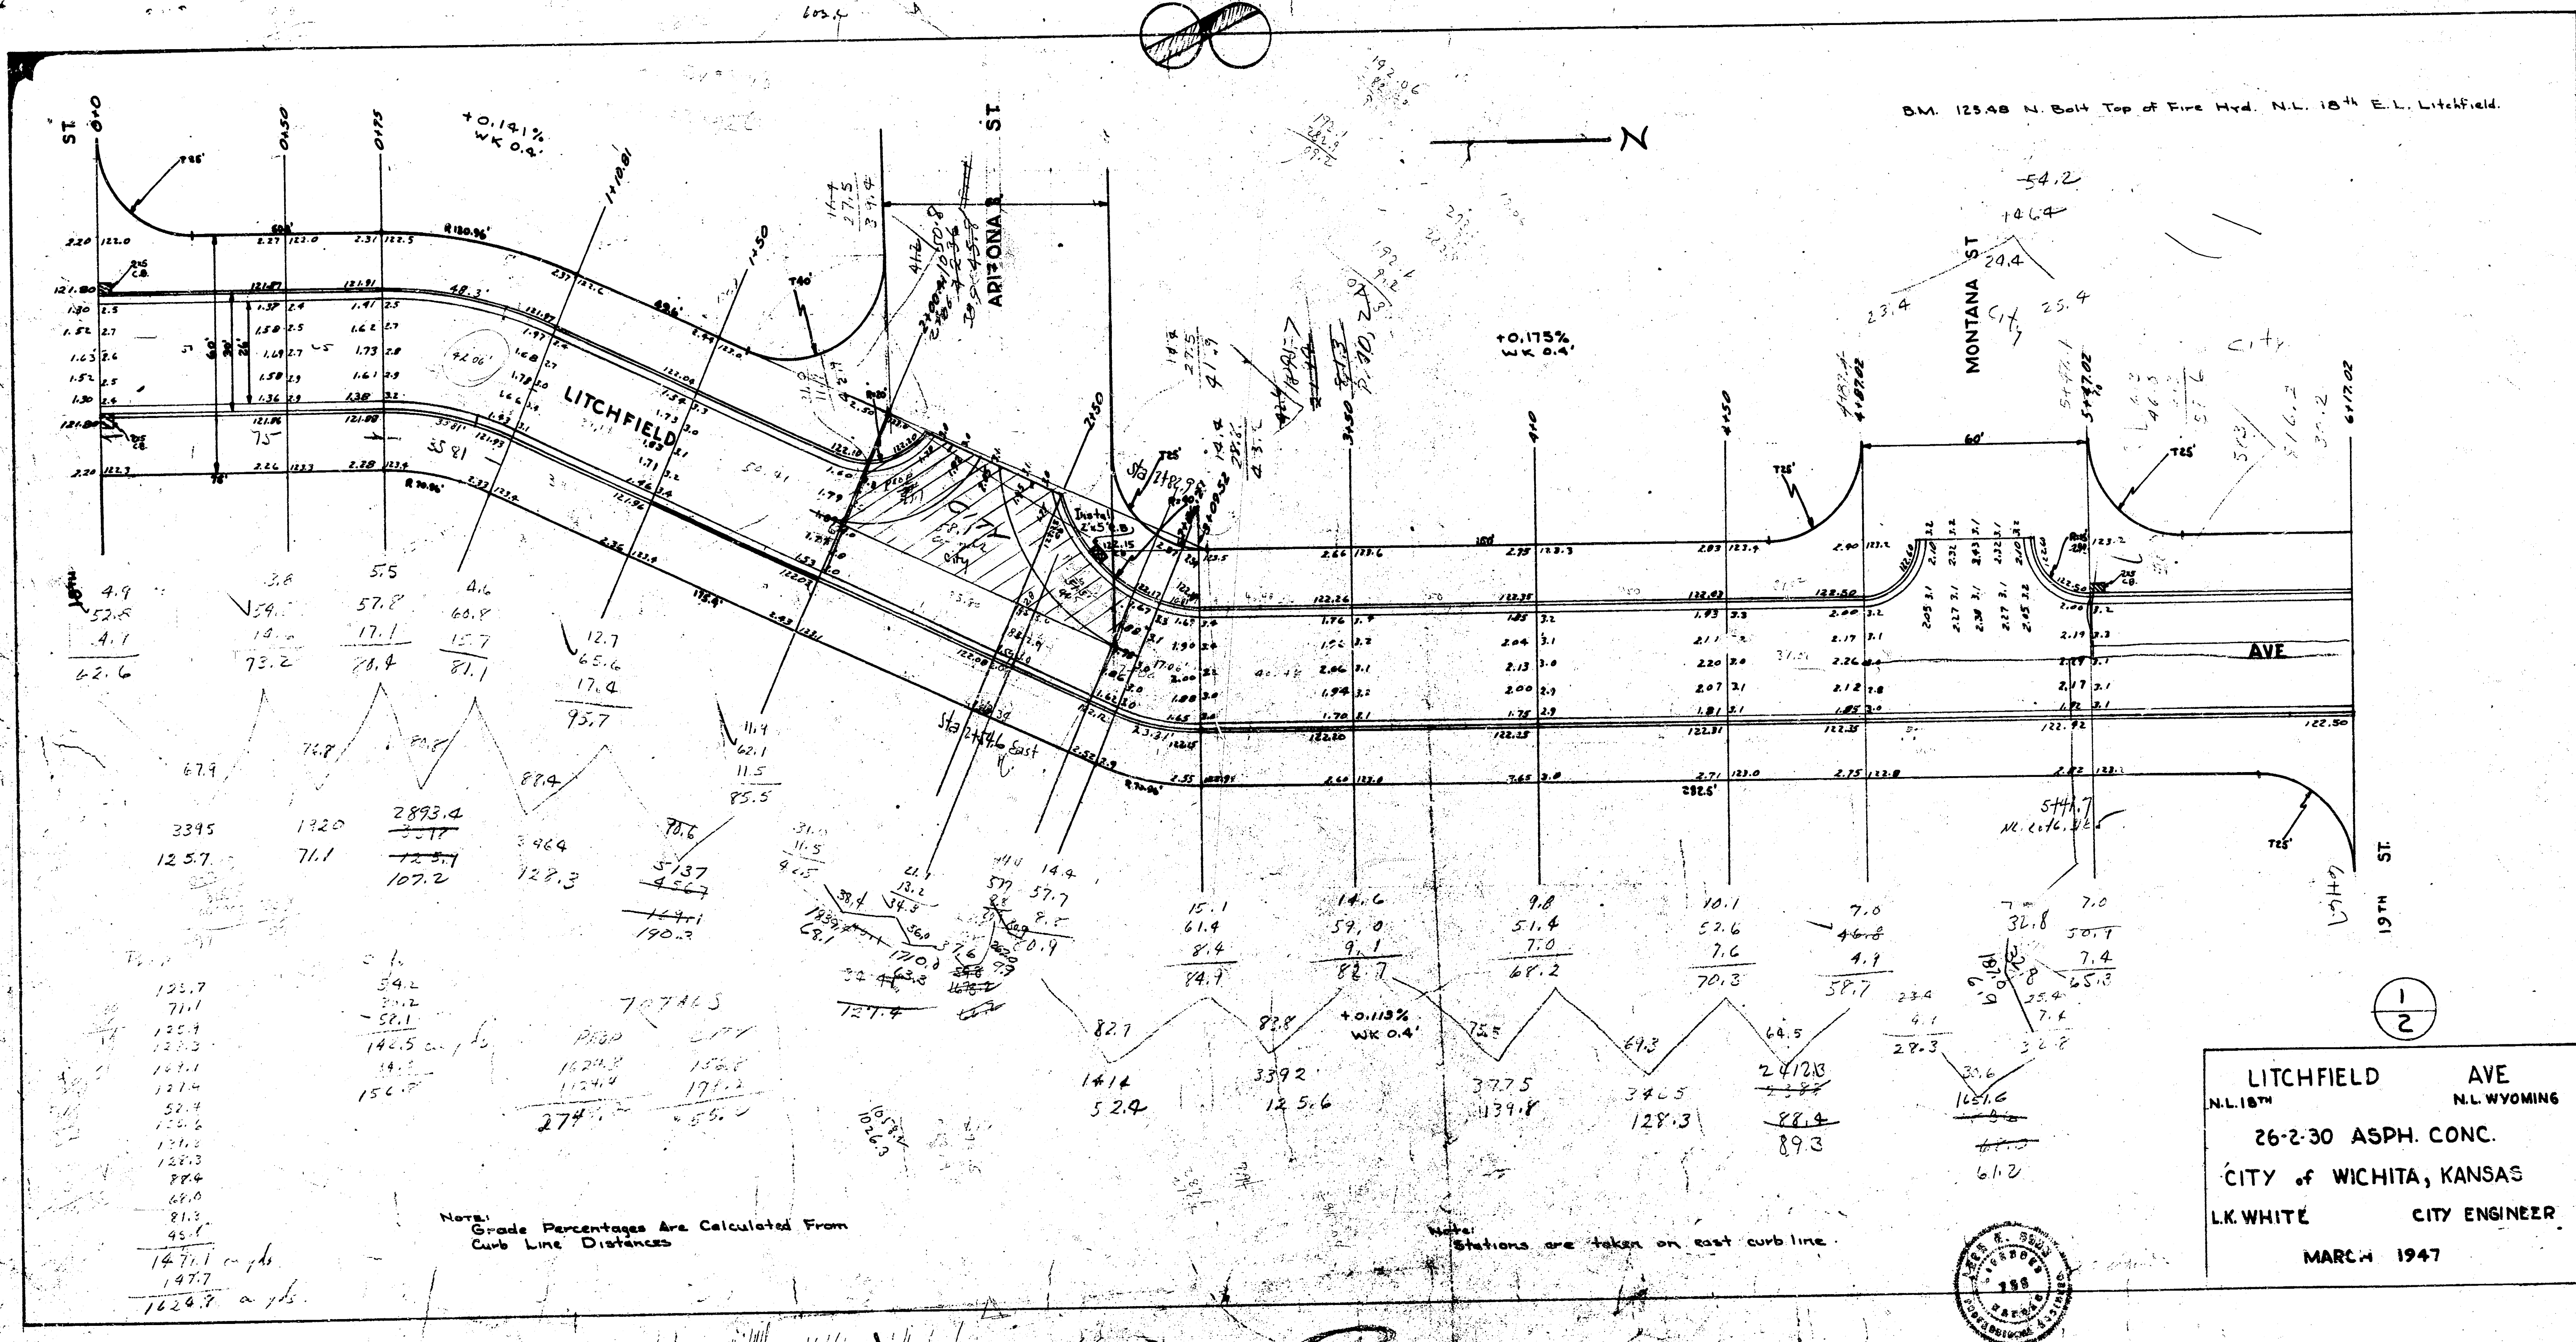

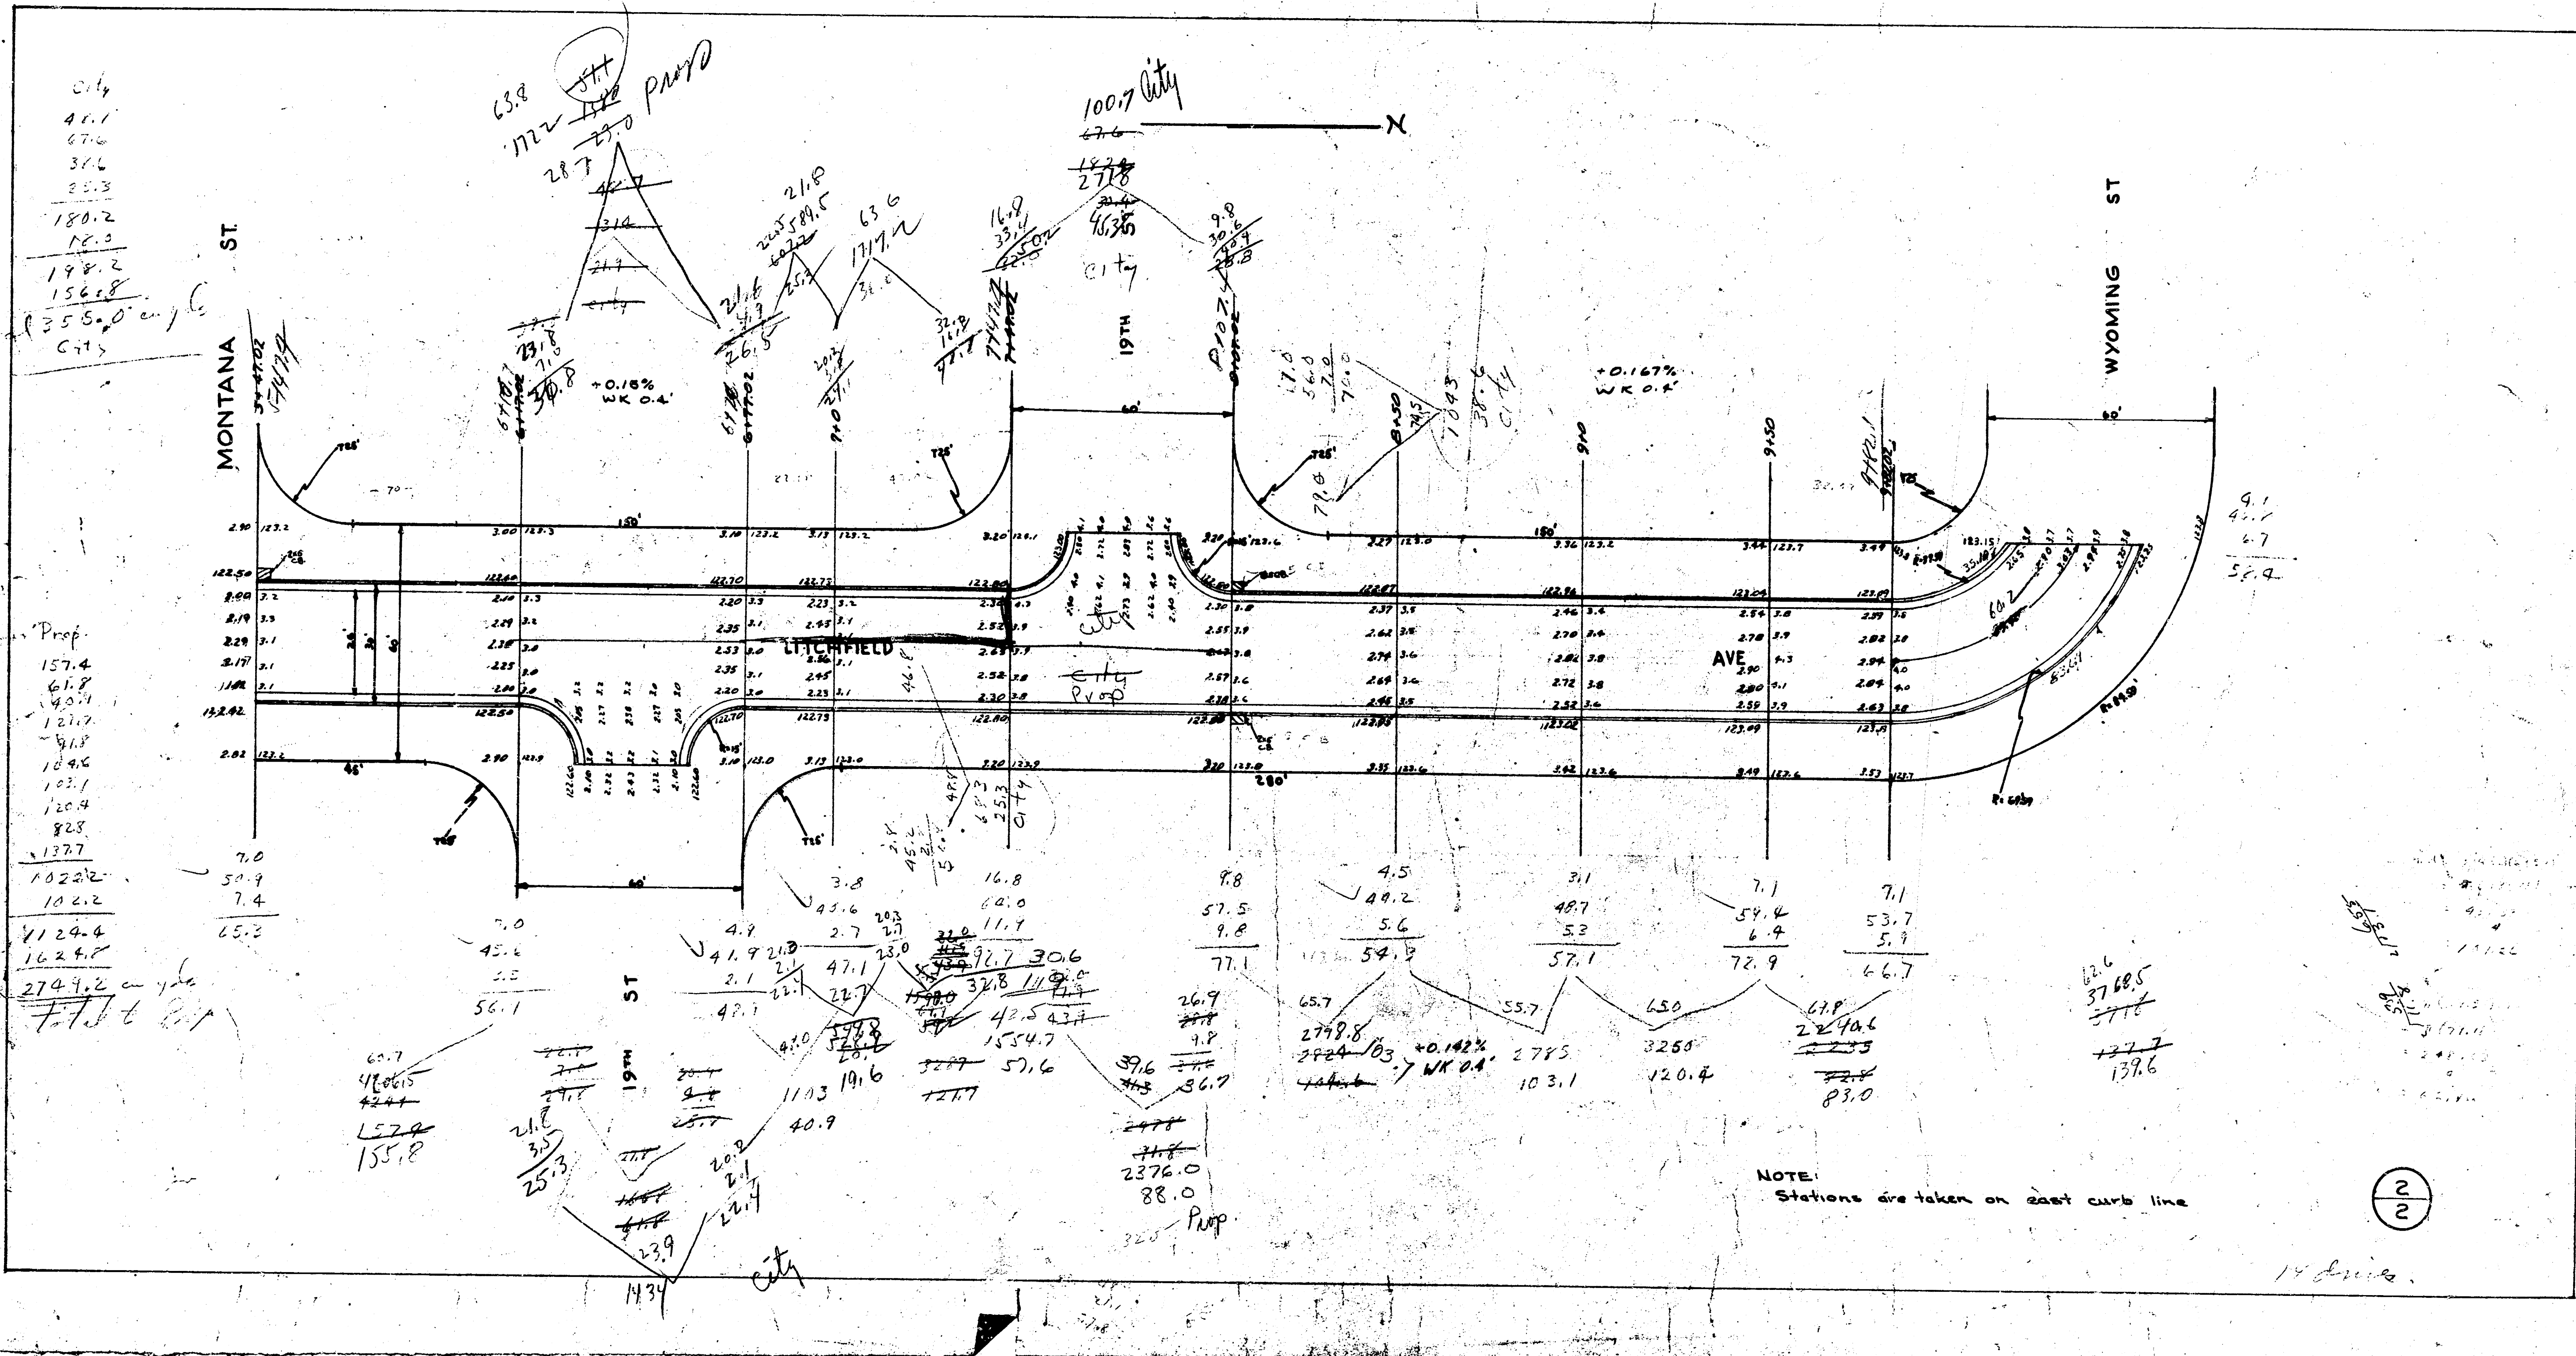

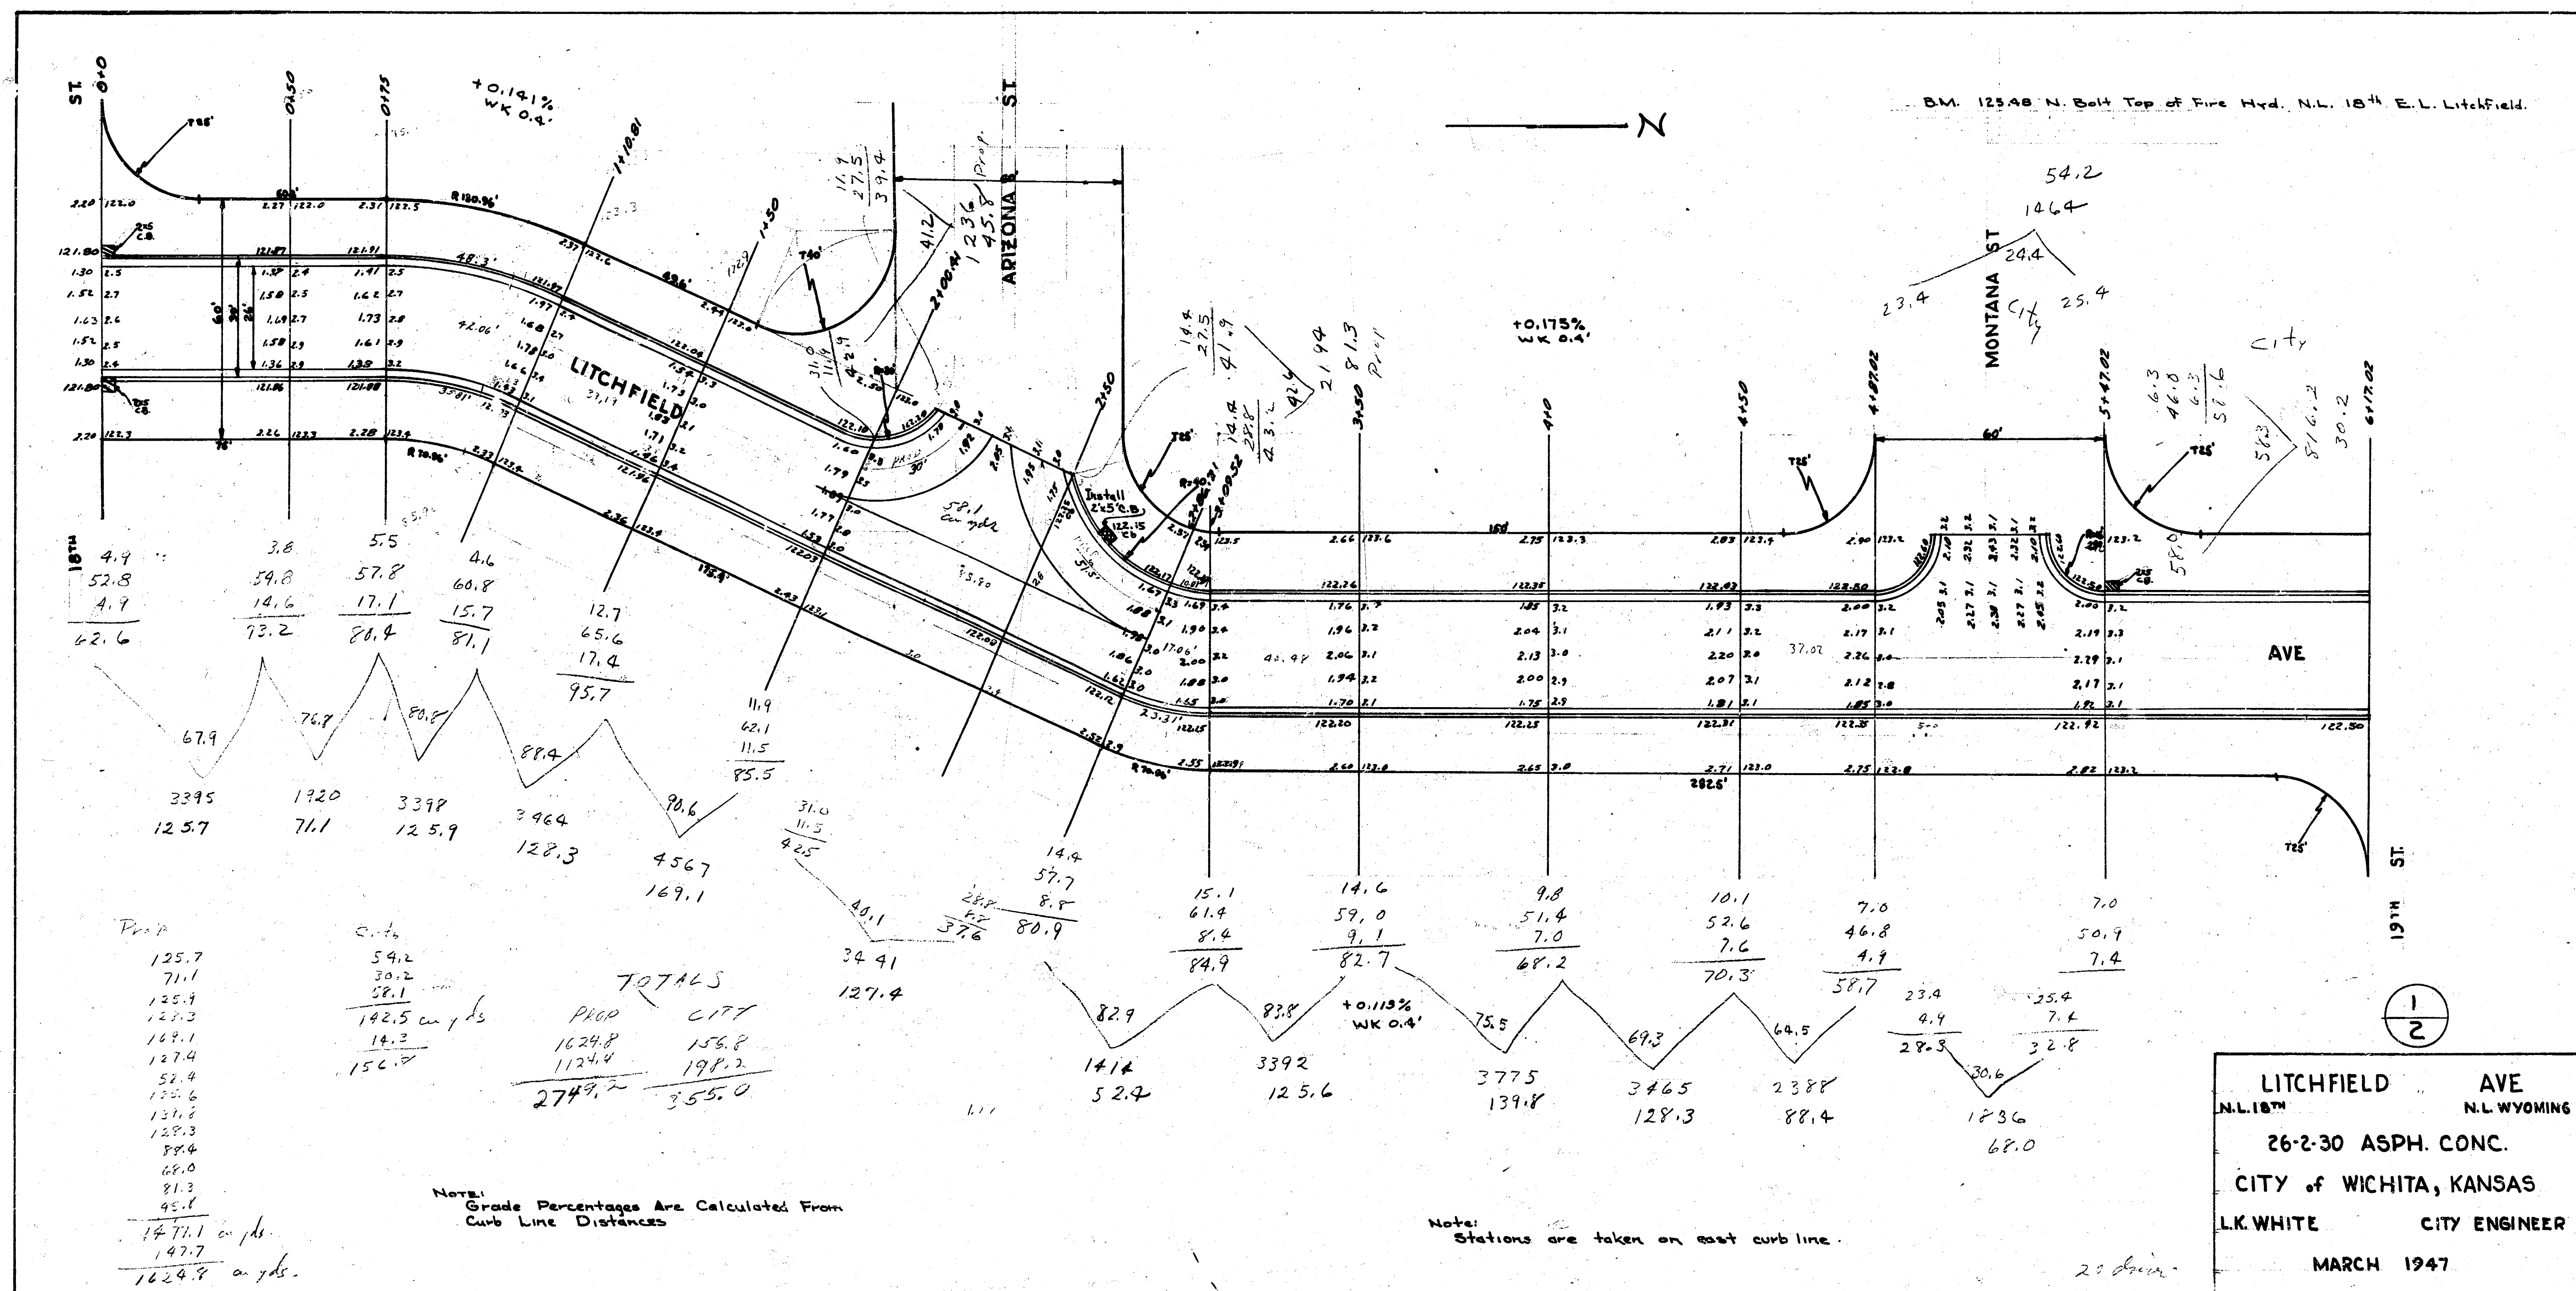

Prop

125.7
71.1
125.9
127.2
127.1
127.4
52.4
131.6
129.3
88.4
81.3
95.1
147.1
147.7
1624.8

as f/s.

CITY

54.2
30.2
38.1
192.5
14.2
156.8

TOTALS

PROG	CITY
1624.8	156.8
1124.4	198.2
2749.2	355.0


Note: Grade Percentages Are Calculated From Curb Line Distances

Note: Stations are taken on east curb line.

LITCHFIELD AVE
N.L. WYOMING
26-2-30 ASPH. CONC.
CITY OF WICHITA, KANSAS
L.K. WHITE CITY ENGINEER
MARCH 1947

City
 48.7
 67.6
 37.6
 25.3
 180.2
 18.0
 198.2
 156.8
 Total 355.0 encls
 City

Prop.
 157.4
 61.8
 40.9
 121.7
 91.8
 104.6
 103.1
 120.4
 82.8
 137.7
 102.2
 102.2
 112.4
 162.8
 274.2 encls
 Total to Prop

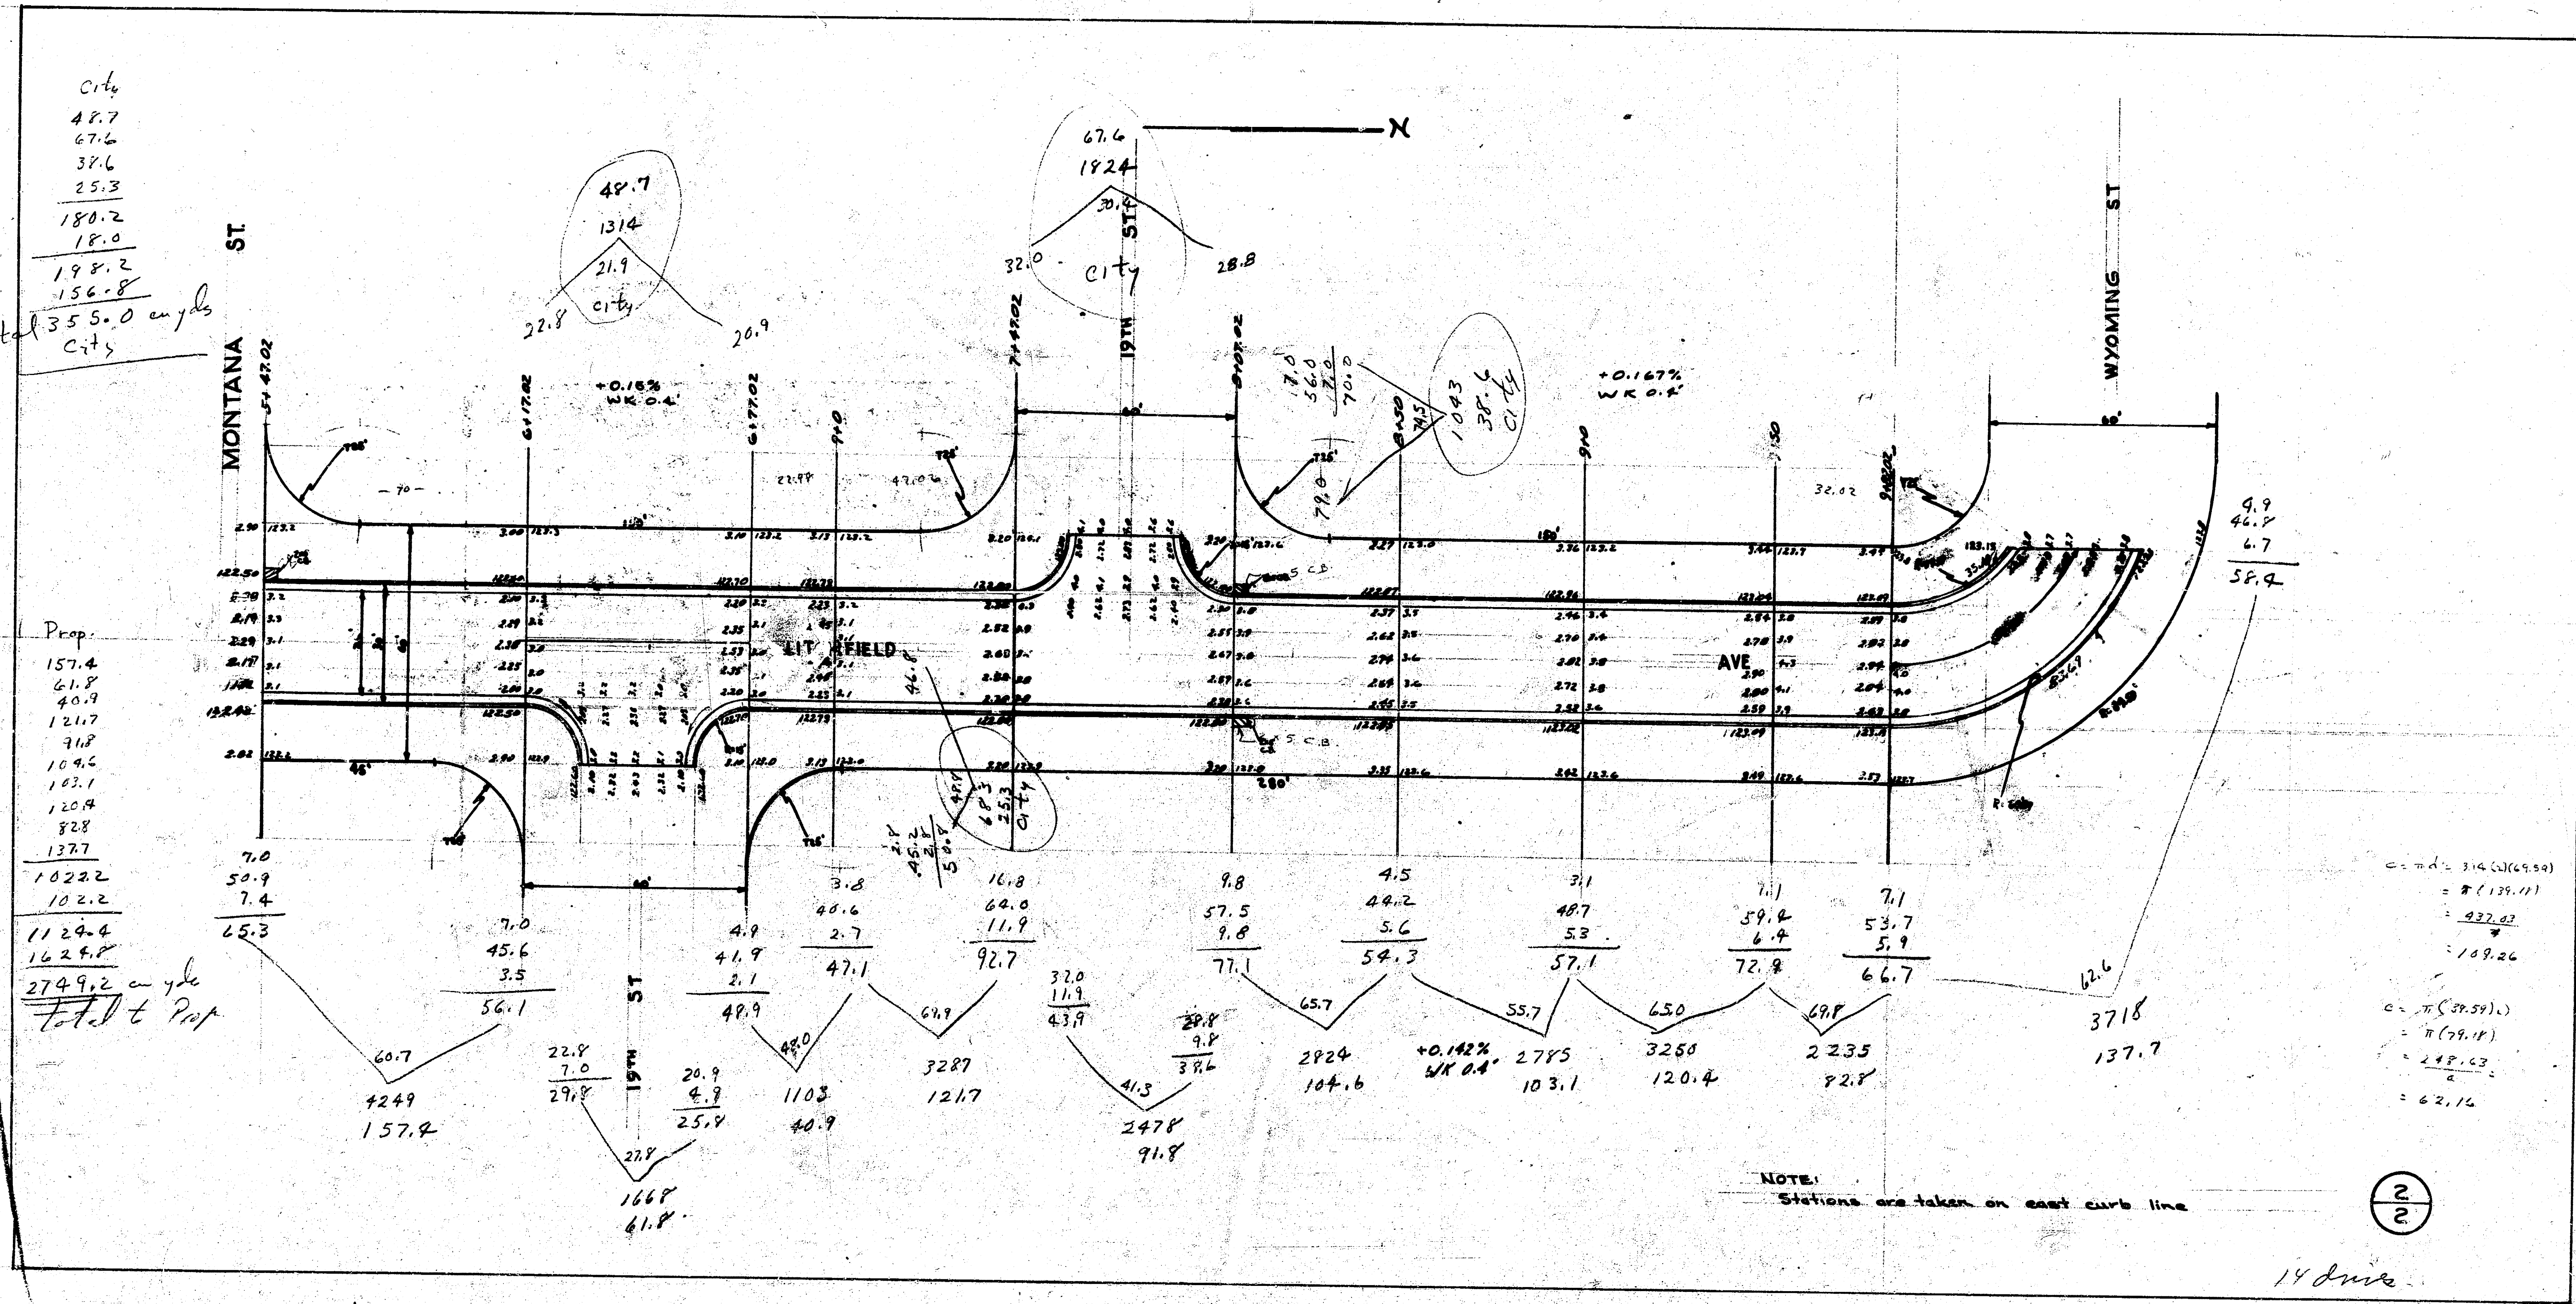

$C = \pi \cdot d = 3.14 \cdot (49.59)$
 $= 155.71$
 $= 155.71$
 $= 155.71$
 $C = \pi \cdot (29.59)$
 $= 93.71$

NOTE:
 Stations are taken on east curb line

2
2

18 drive