B.M.: 1518 S.W. Cor conc porch N.S. LEVITT 15' W. of E.L. BLACKHILL No.# 8608 LEVITT.
B.M.: 1489 @ S.E. Cor conc slab @ S.E. Cor House # 8329 LEVITT.
B.M.: 1477 @ "P" in Ritchie W. Cb. WICKER LANE - S.L. LEVITT Drive.

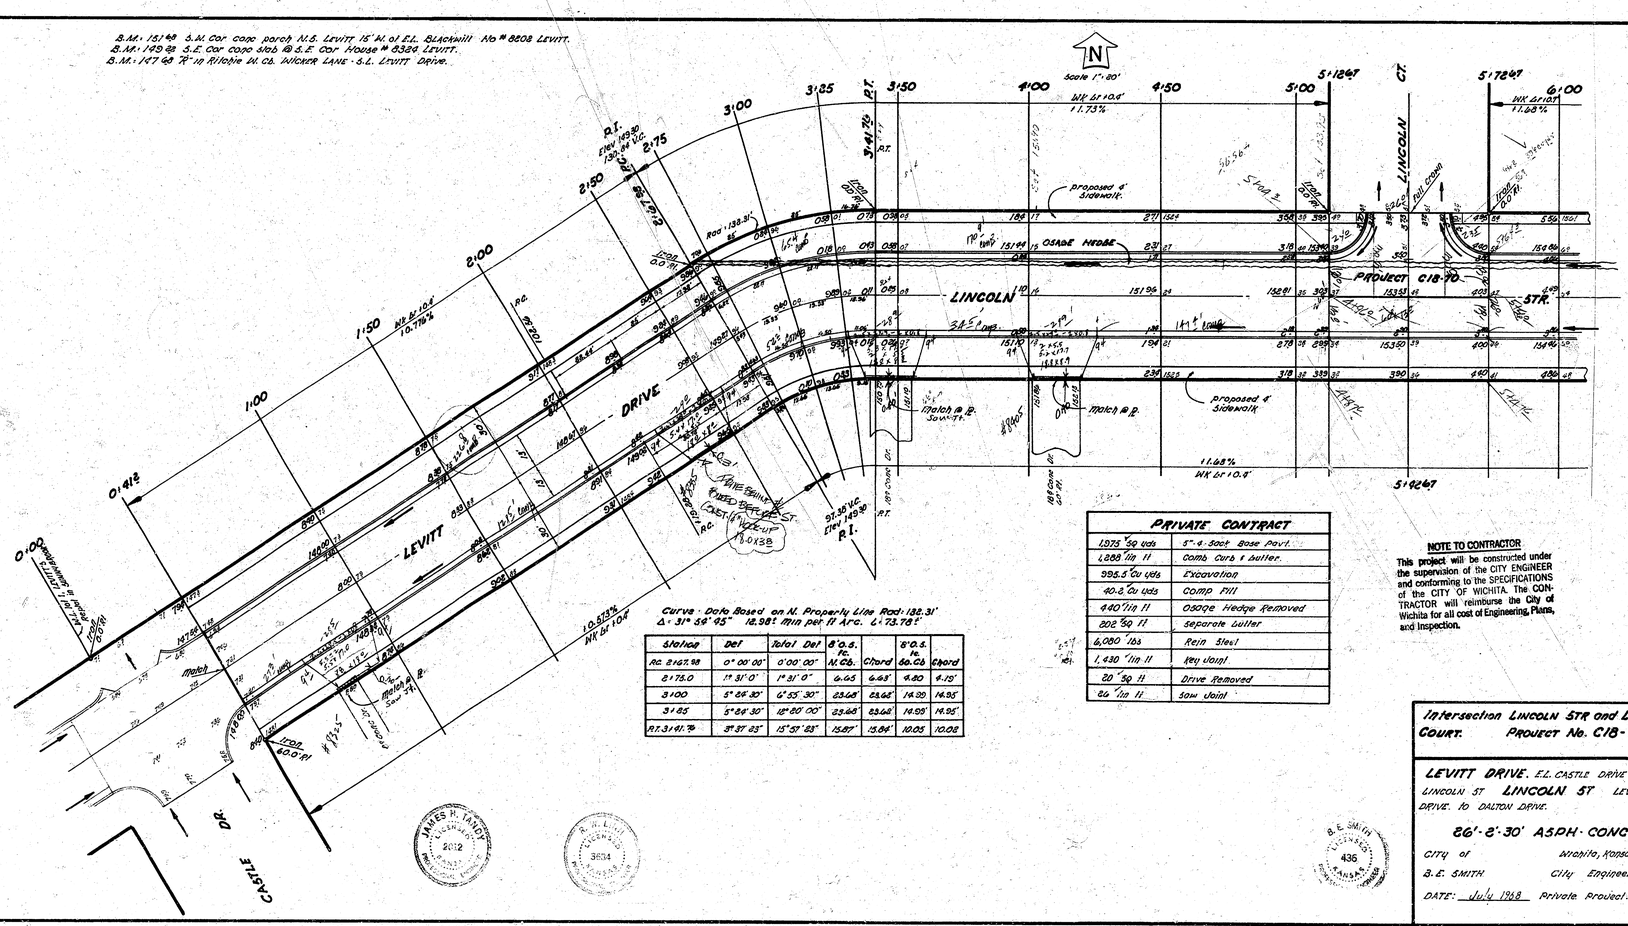

Station	Def	Total Def	8" O.S. to N. Cb.	Chord	8" O.S. to So. Cb.	Chord
Rc 2147.98	0° 00' 00"	0° 00' 00"				
2 175.0	1° 31' 0"	1° 31' 0"	6.45'	6.45'	4.80'	4.79'

Intersection LINCOLN STR and LINCOLN COURT. PROJECT No. C18-70

LEVITT DRIVE. E.L. CASTLE DRIVE to LINCOLN ST. LINCOLN ST. LEVITT DRIVE. to DALTON DRIVE.

86'-2'-30' ASPH-CONC.

City of Wichita, Kansas
B.E. SMITH City Engineer.
DATE: July 1968 Private Project.

Survey Book
Plan
Est.
Checked

-6-