1942

LULU AVE - N.L. OSIE TO S.L. HARRY

CB + GTR ONLY
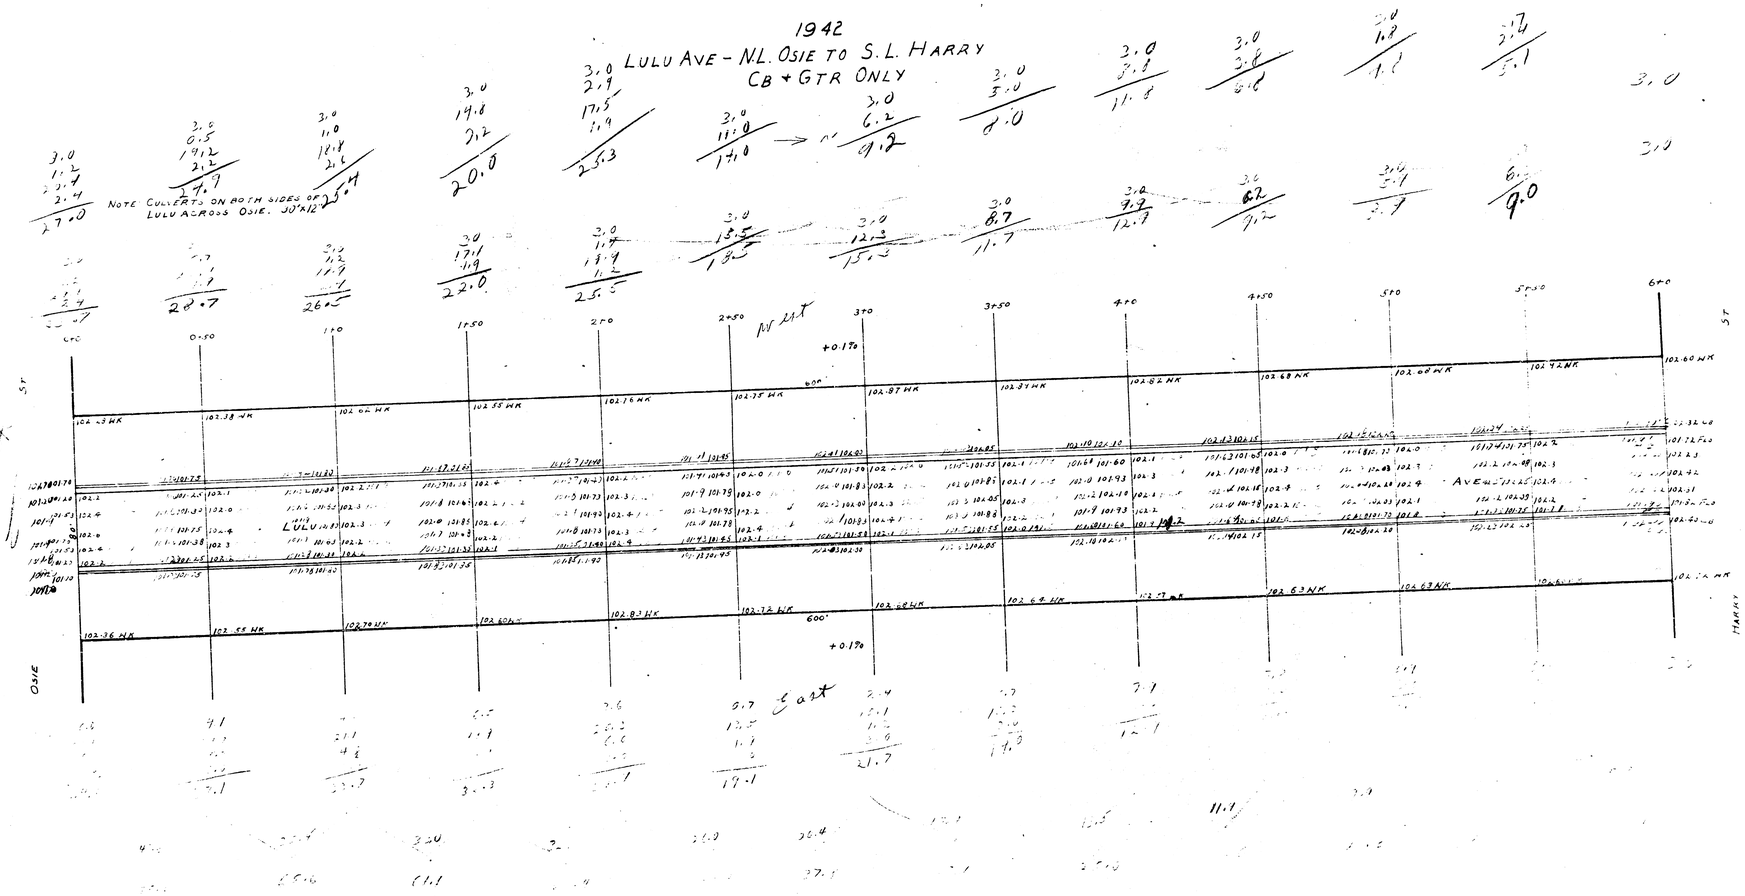
NOTE CULLERTS ON BOTH SIDES OF LULU ACROSS OSIE. 30"x12