



1942
MADISON AVE - N.L. 9TH TO S.L. 10TH
26-2-30-S.A.-B.B.

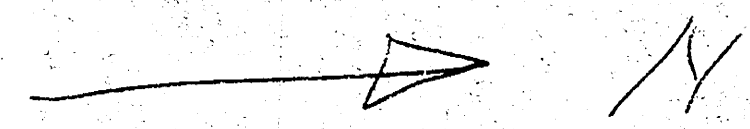

*Finalize cross-sections
to meet future Madison
B.B.*

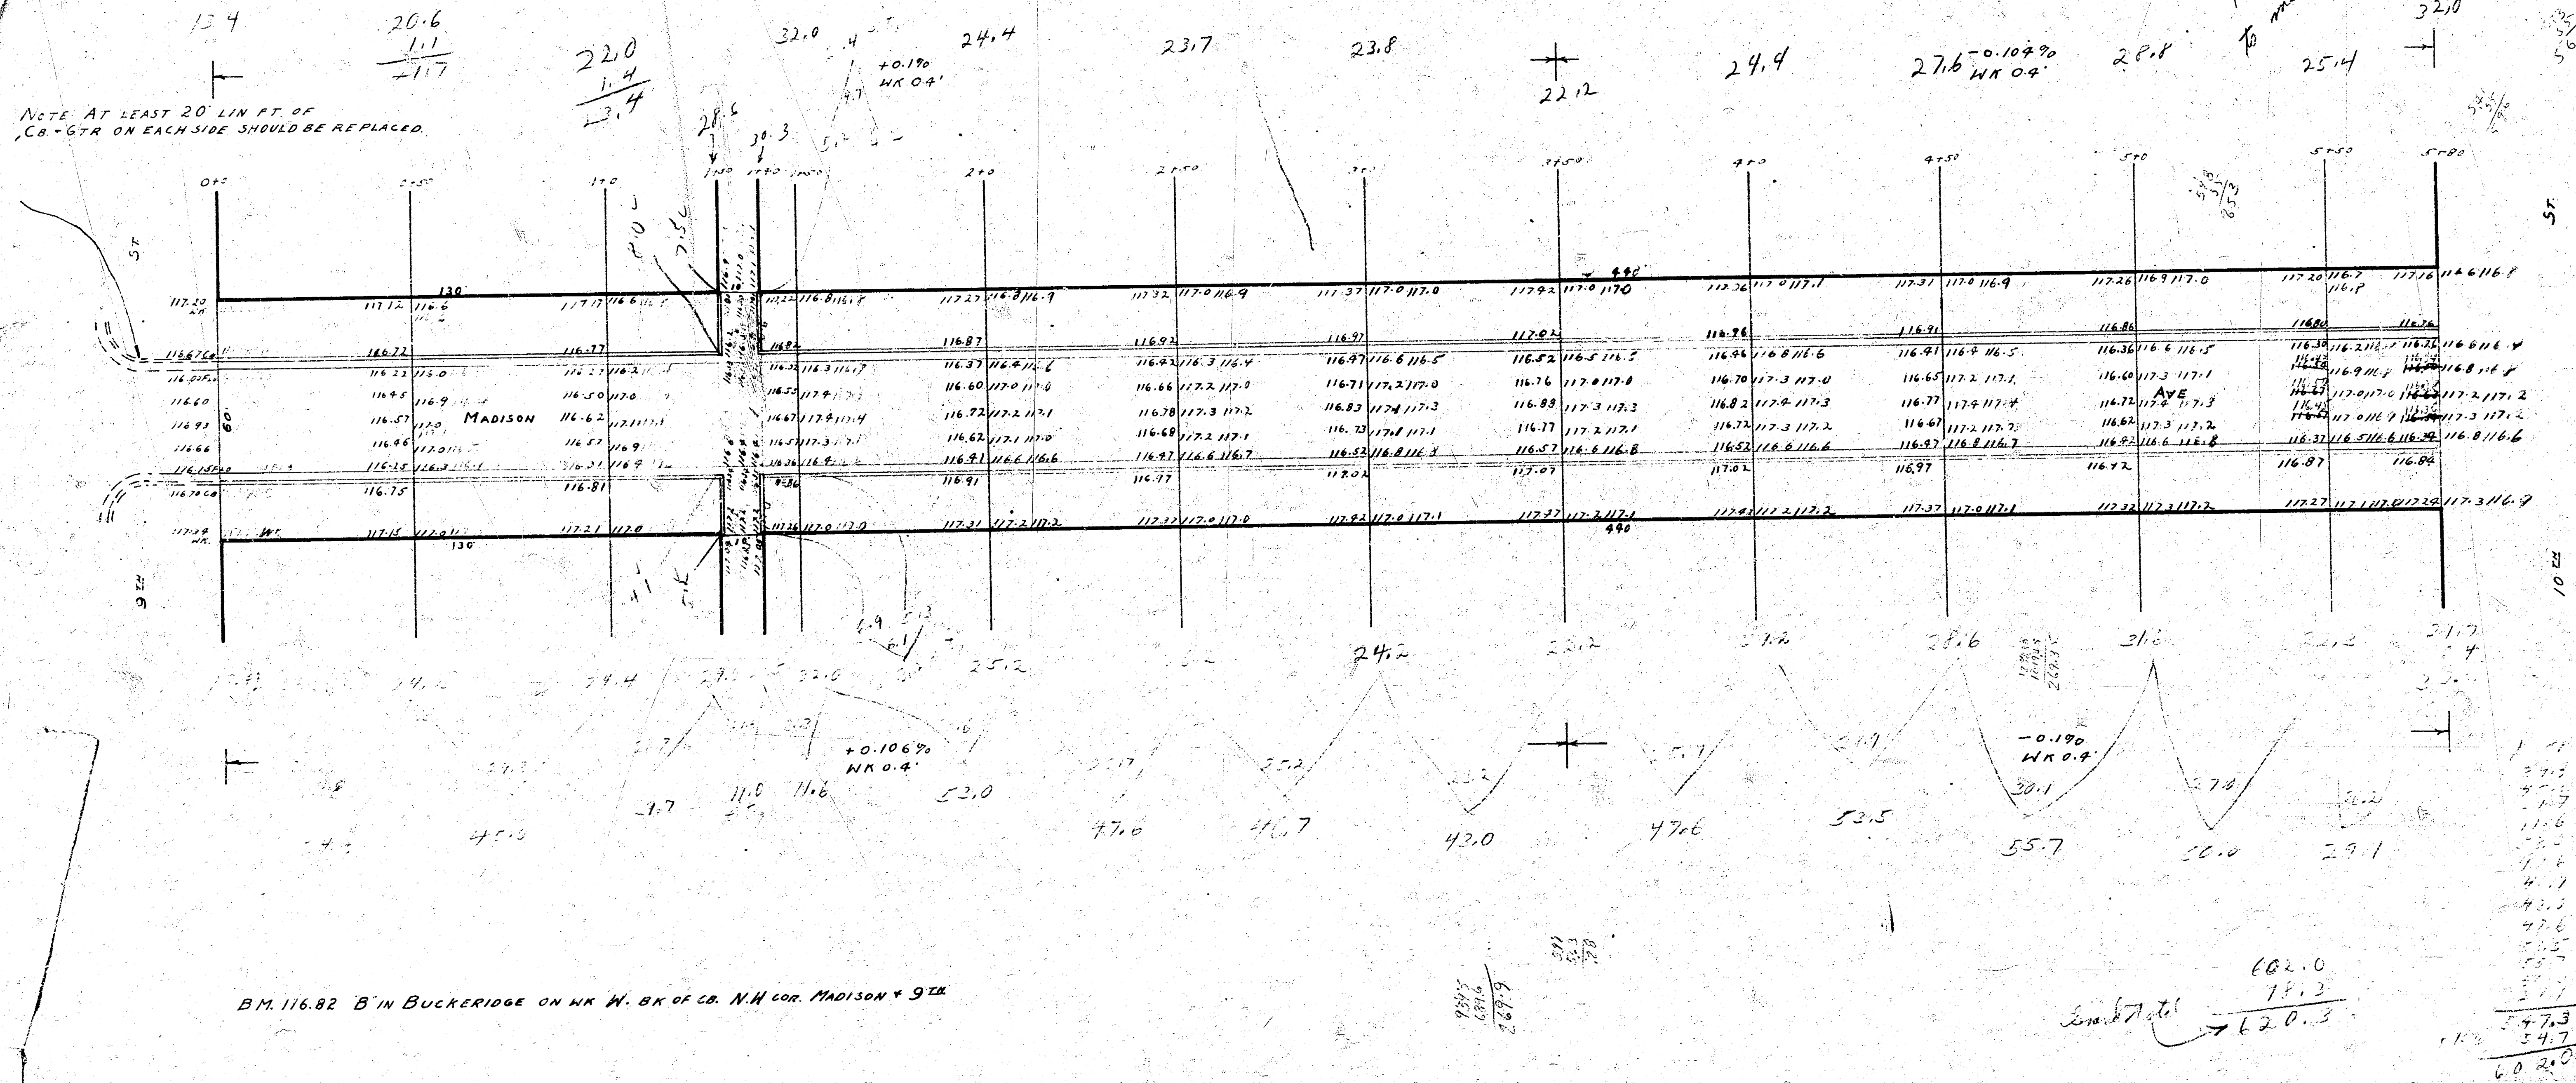

B.M. 116.82 B'N BUCKERIDGE ON W. BK. OF C.B. N.H. COR. MADISON & 9TH