


Madison Ave. - S.L. Massman to N.L. Remond Rd.

26-2-30 AS.

1941 Elev. 11531 "B" in Road level of  
 Mt. H. NW on Plat # 98  
 11531 11531 718 on center line.  
 DW for Massman to Remond

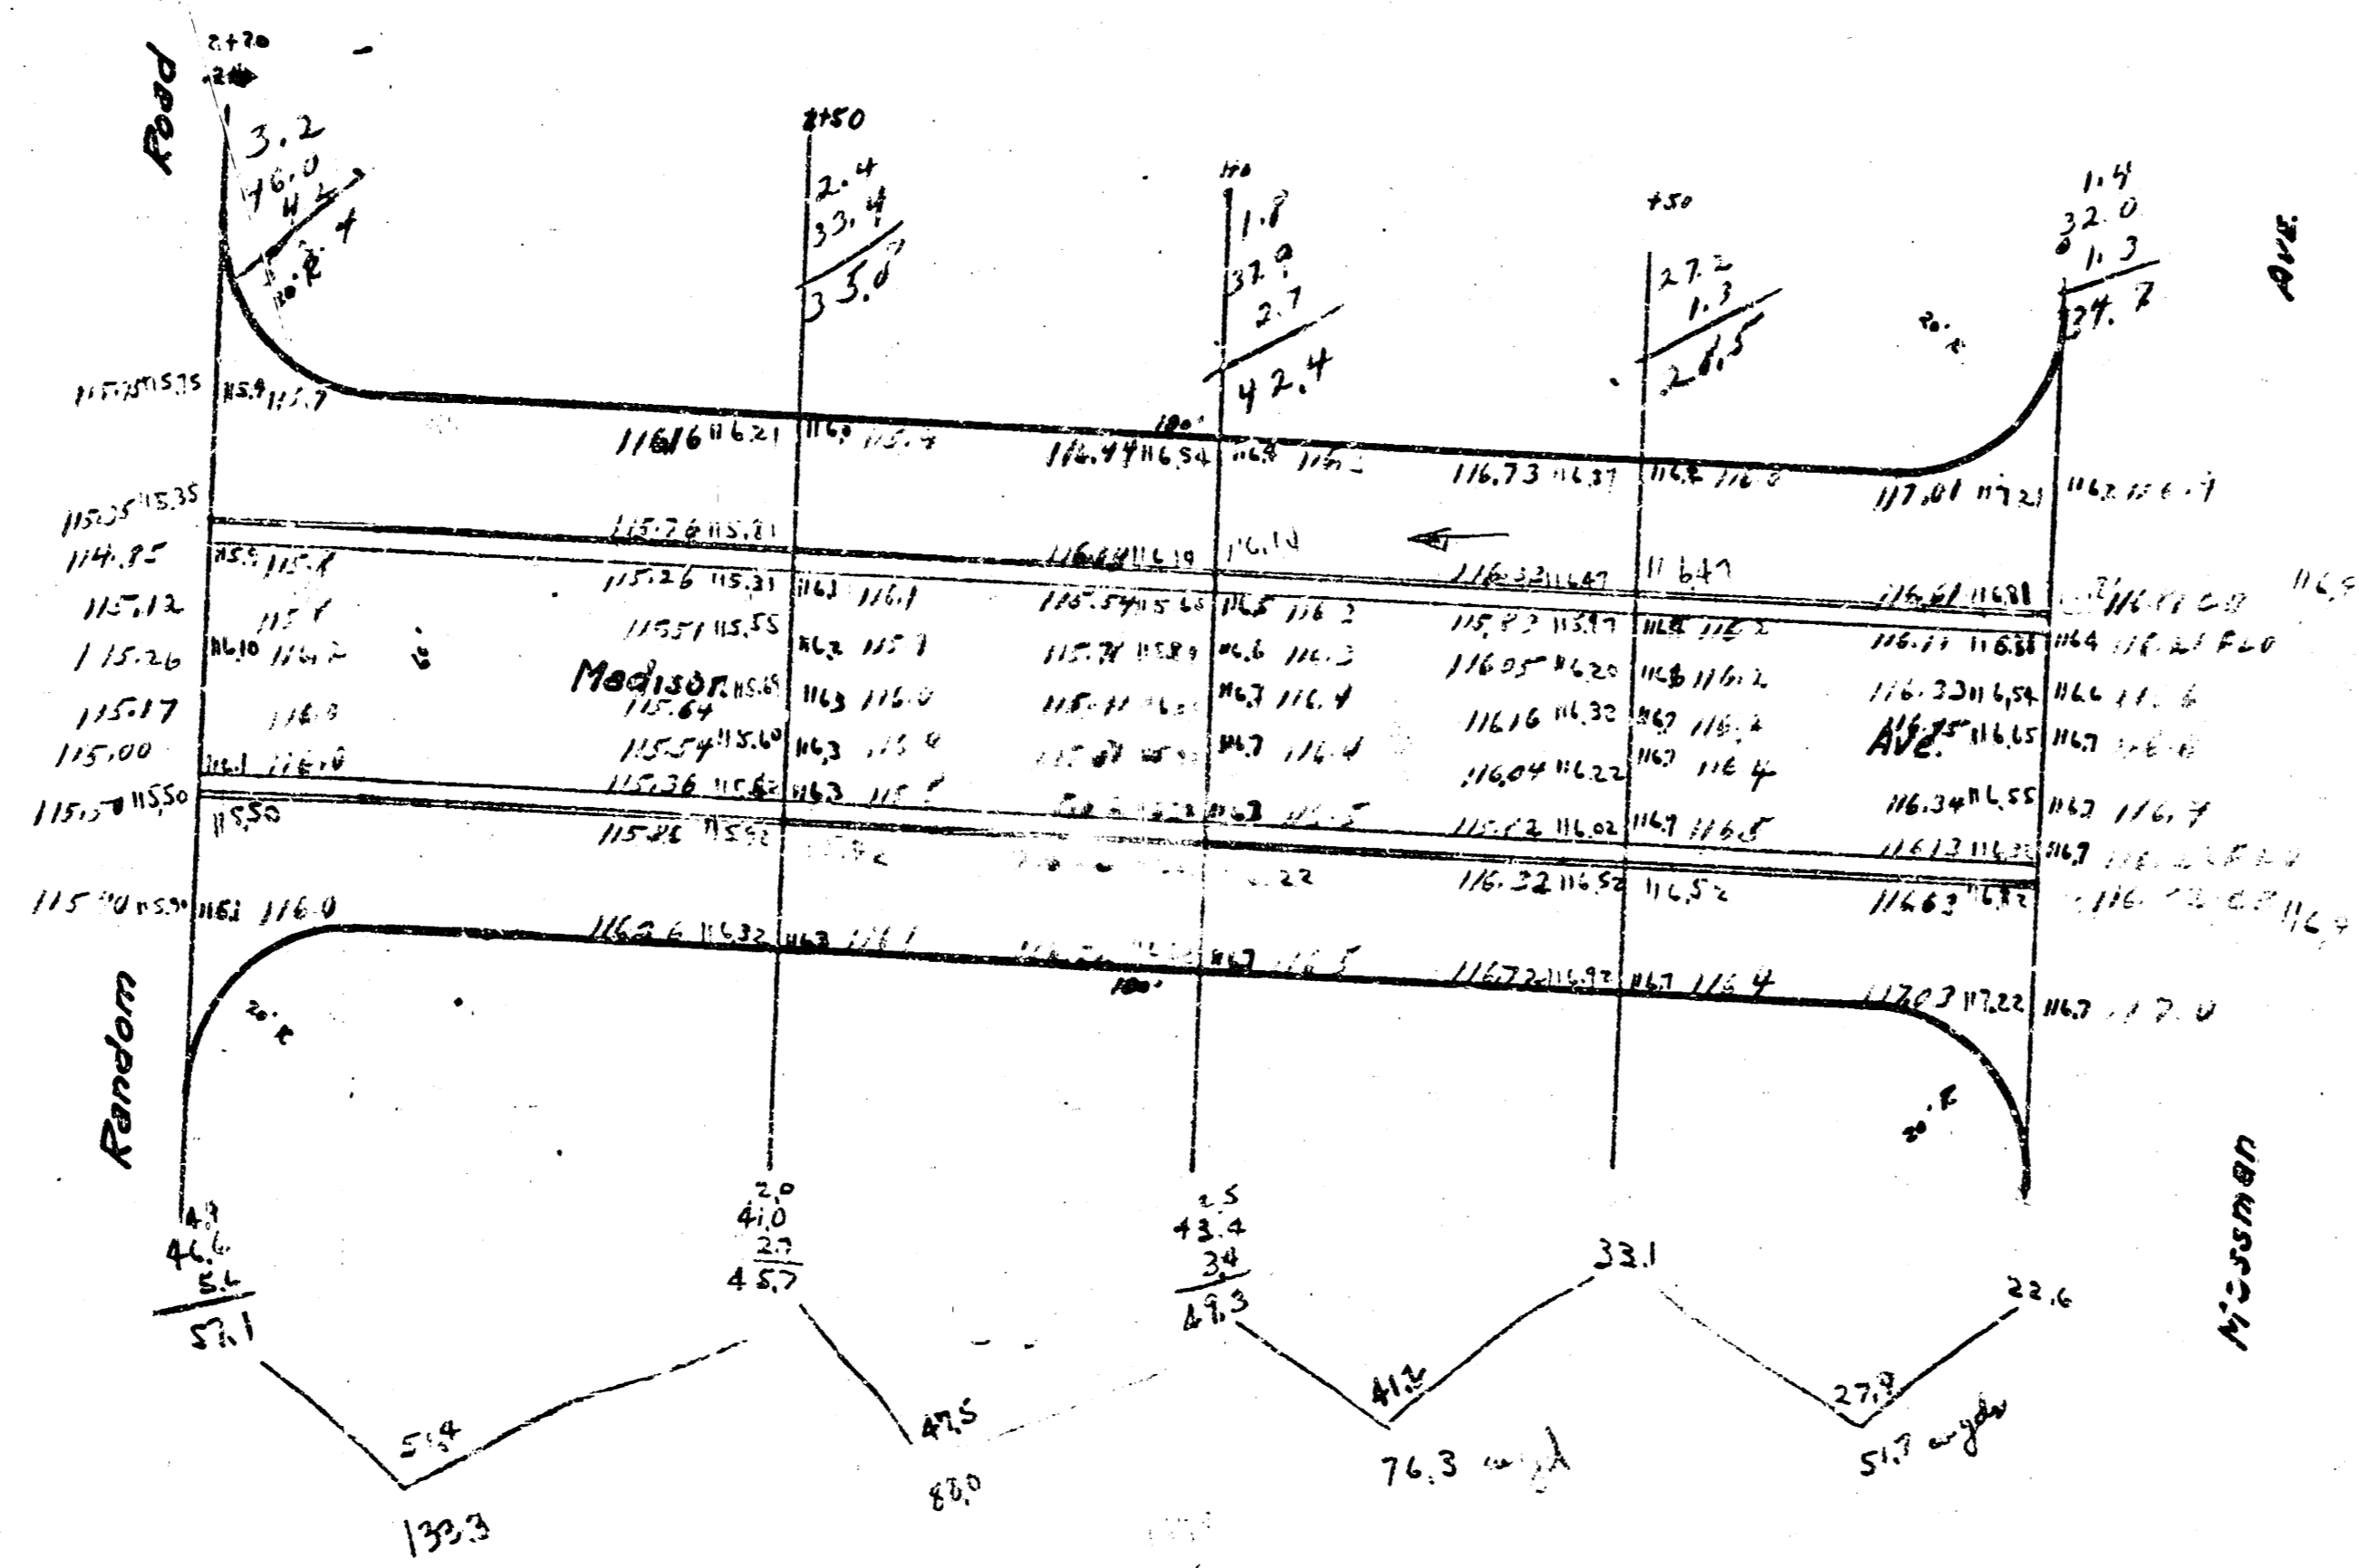

Length 349.3 m  
 31.1  
 320.2 m