



33.00	30.00
3.50	2.75
.16	0.25

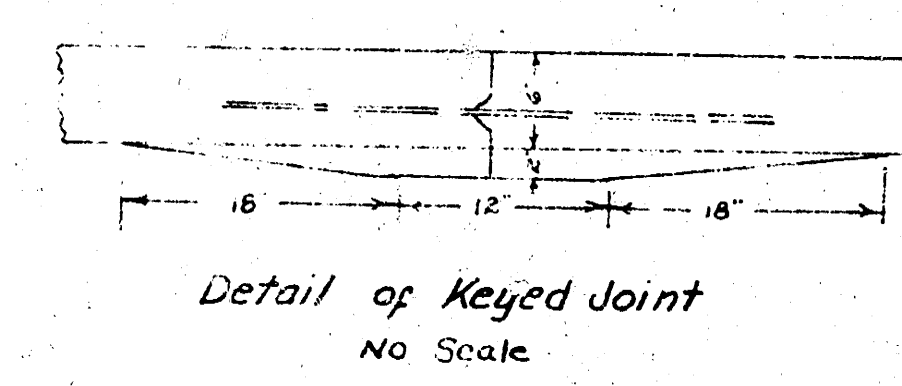

Detail of Keyed Joint
No Scale

Scale $\frac{1}{2}'' = 1'$


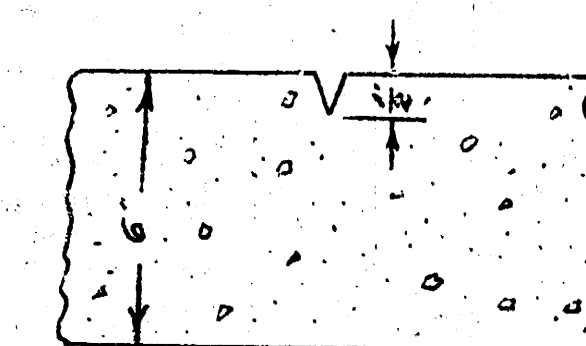


*Detail Plane of Weakness
Plane of Weakness to be Cut With
Double-Edge Groover to Depth As
Shown in a Straight Line From
Curb to Curb 26' Ctr to Ctr.*

Scale $\frac{1}{4}'' = 1'$

Scale $\frac{1}{4}'' = 1'$

BM. 95.07 60' SPIKE W.S. RR/RW FENCE POST E WASSALL E W.S. ATSF RR/RW

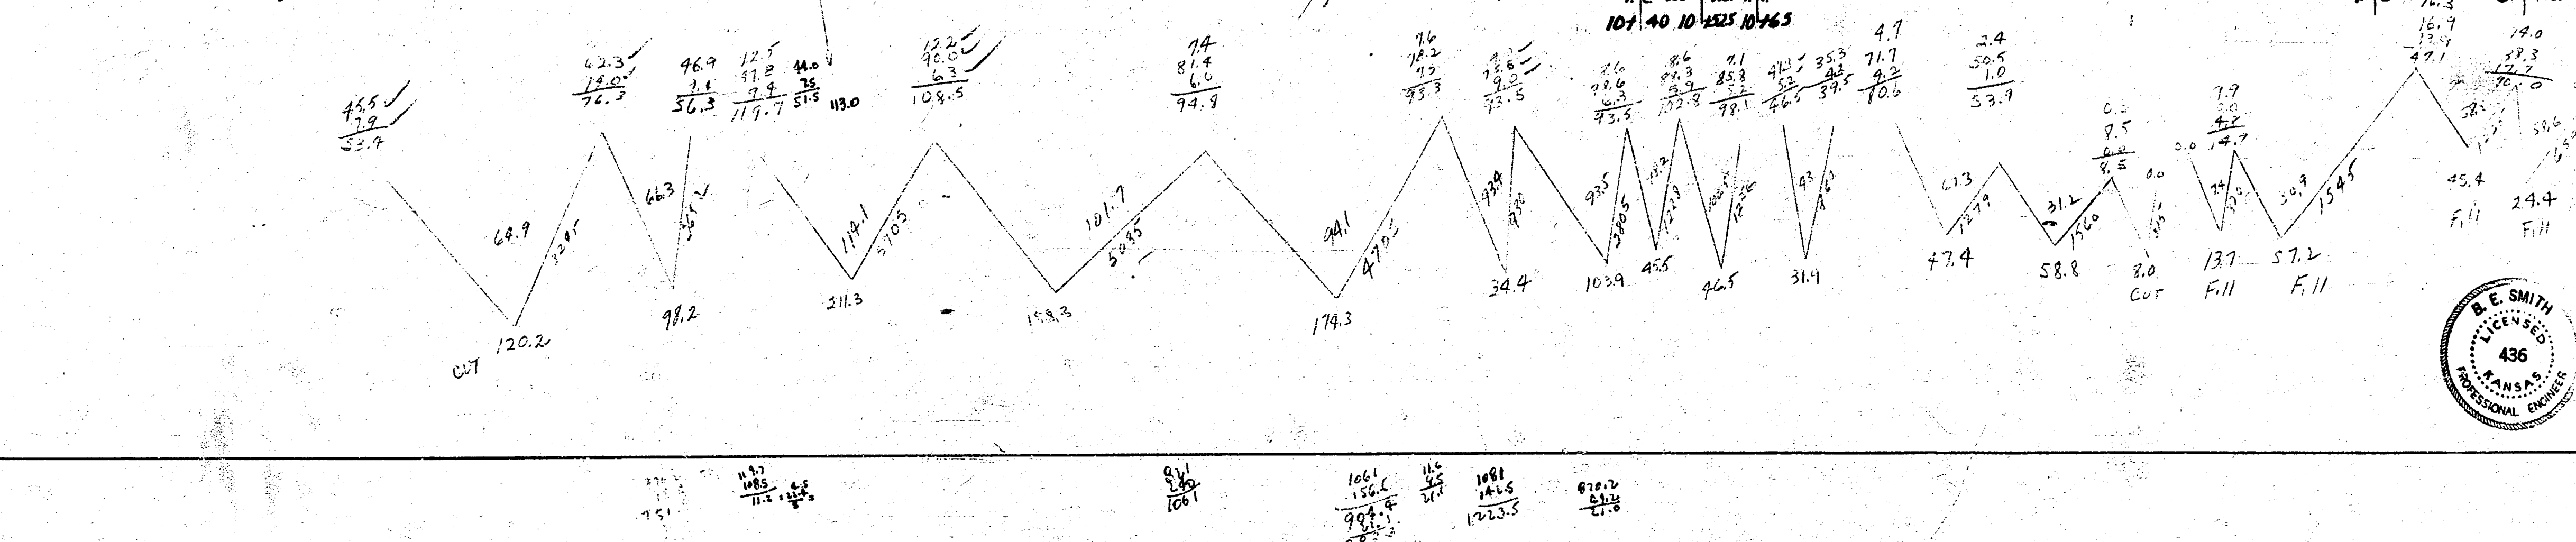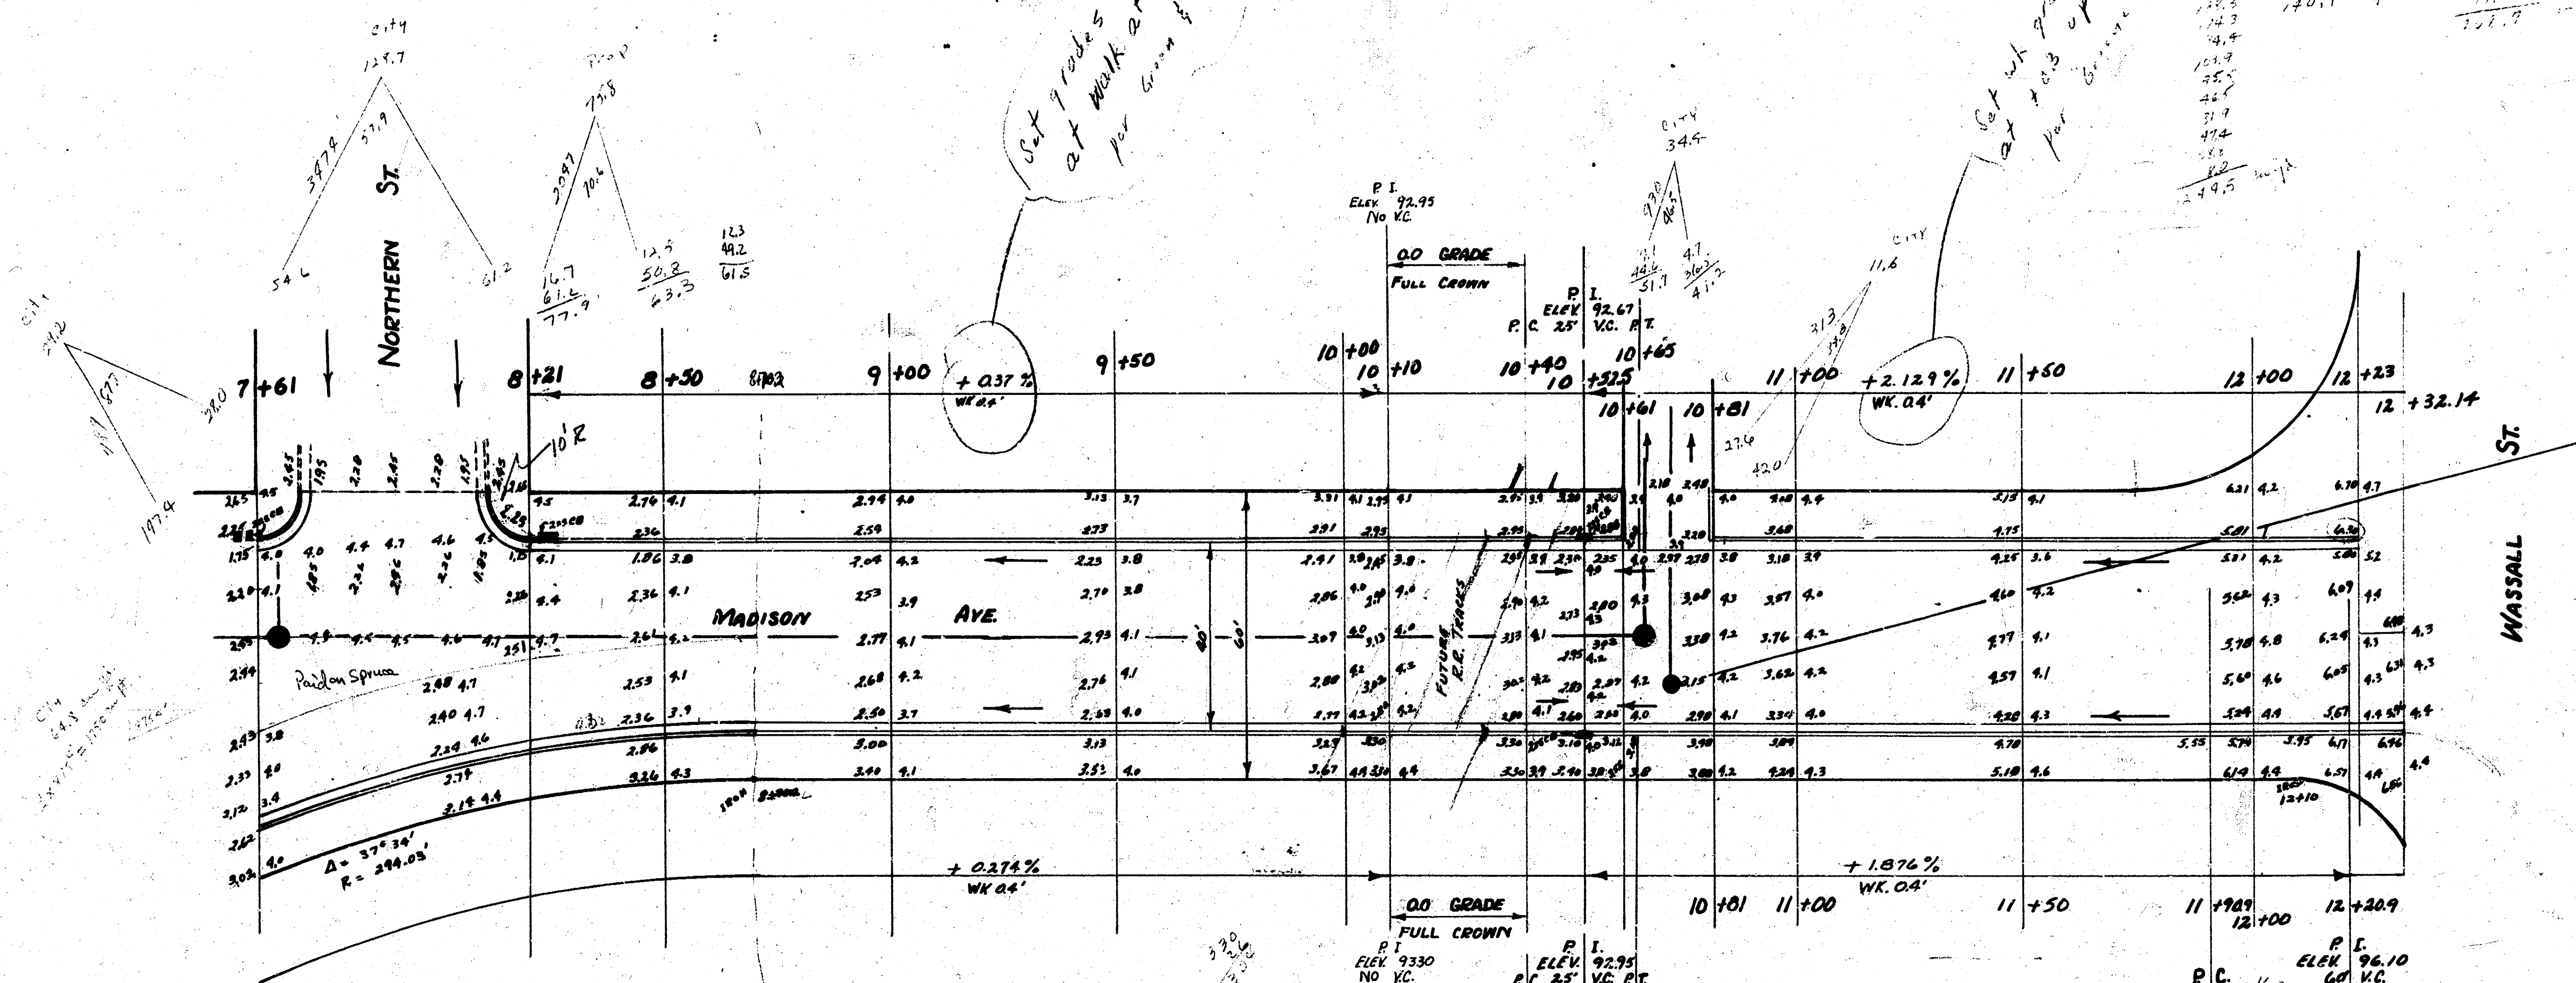

MADISON AVE
 SL NORTHERN TO SL WASSALL
 36-2-40 A.C.
 6" CONC. BASE
 CITY OF WICHITA KANSAS
 L.K. WHITE CITY ENGINEER
 JULY 1952 PROJ. NO. C-11-101

