BM: 1002.1 "M" in Mueller Fire Hyd. NW cor Levy & Madison.

SCALE 1"=20'

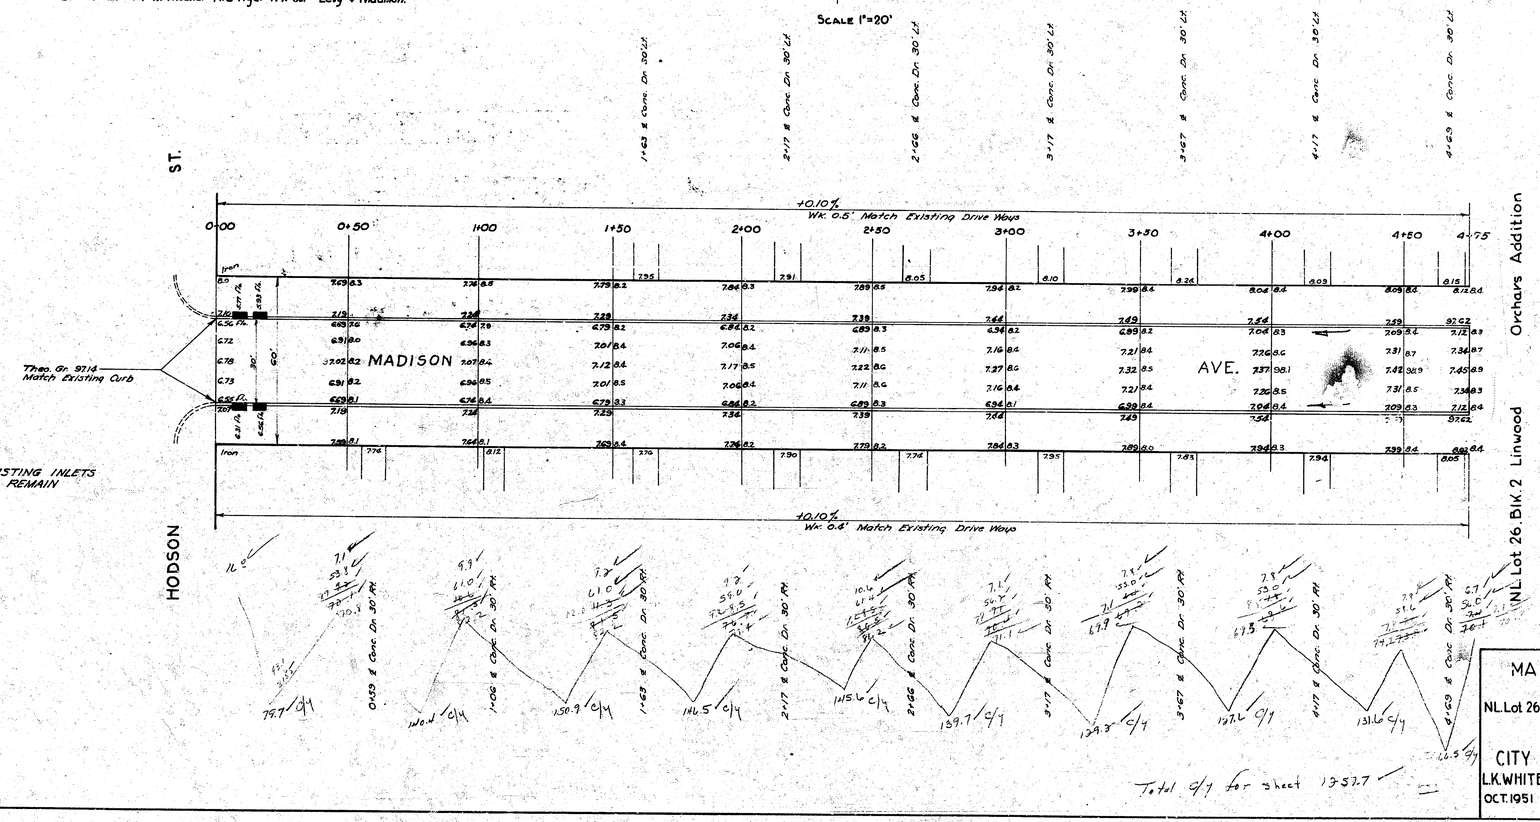

MADISON AVE.
NL HODSON ST. to
NL Lot 26, Blk. 2 Linwood Orchards Addn.
30' Conc. & Cb.

CITY OF WICHITA, KANSAS
L.K. WHITE CITY ENGINEER
OCT. 1951 PROJ. NO. C 11-148

S-4

BM: 100.21 "M" in Mueller Fire Hyd. NW cor. Levy & Madison.

Prop.	City
1198.2	117.9
+10%	23.9
1318.0 cu. yds.	22.8
	166.6
	+10%
	183.3 cu. yds.

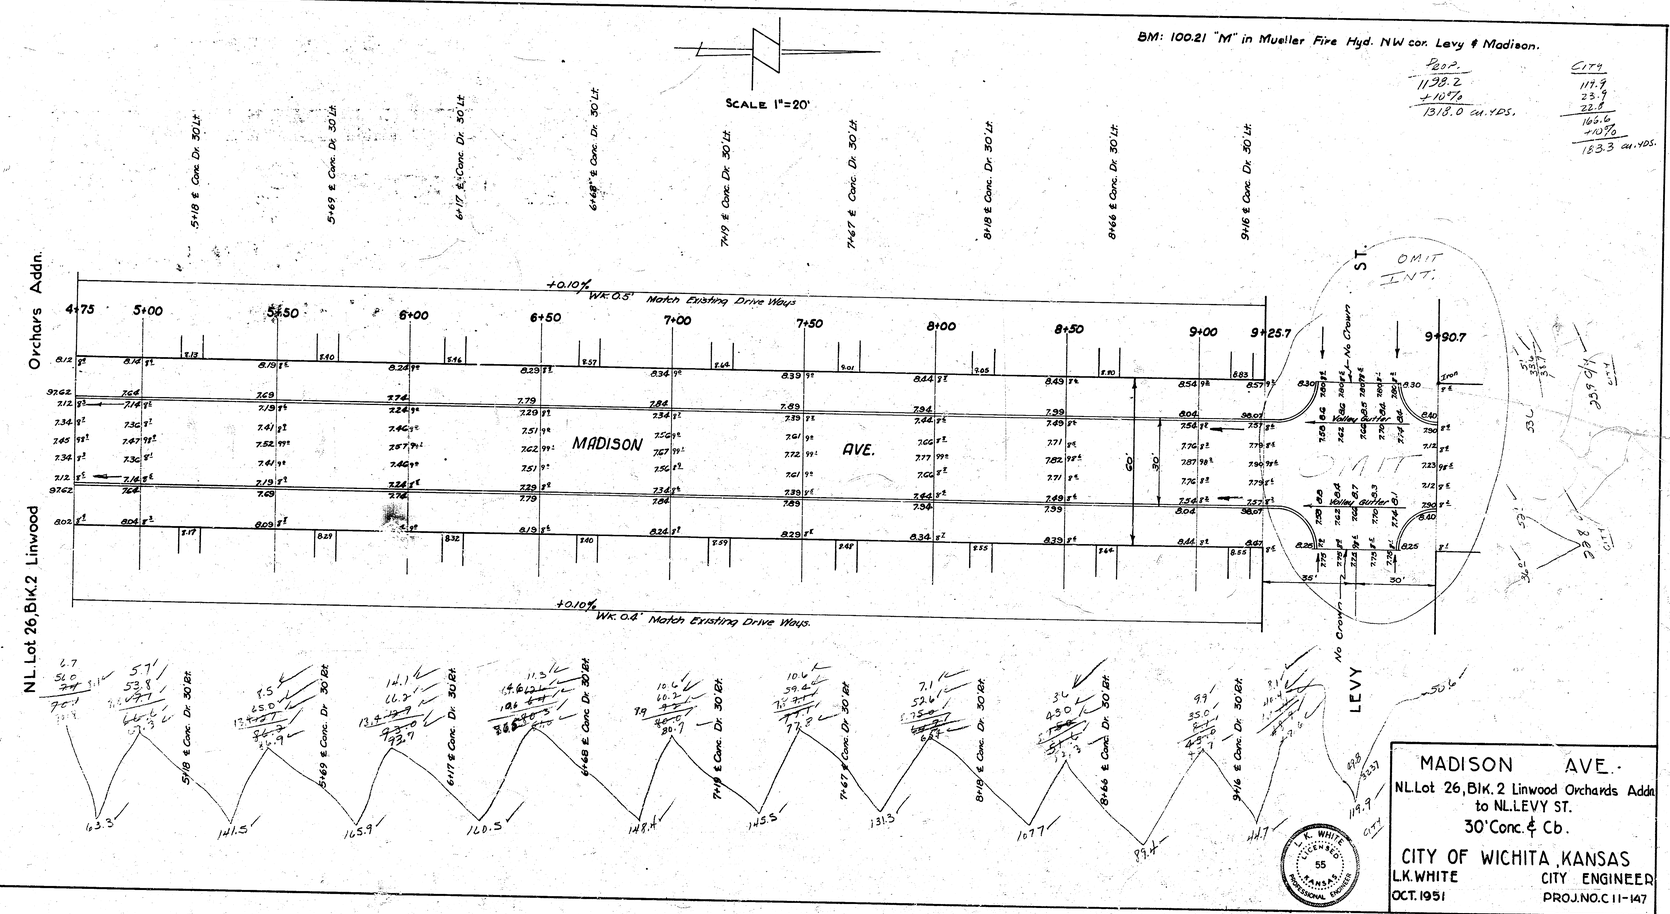

Preliminary Survey - 8-4-5 - 5-23 - 11-13-51
Final Survey - 10-29-51 - 11-13-51
Grade & Sec. Computed by J.L.H. 7-24-52
J.H.E.

MADISON AVE.
N.L. Lot 26, Blk. 2 Linwood Orchards Addn
to N.L. LEVY ST.
30' Conc. & Cb.

CITY OF WICHITA, KANSAS
L.K. WHITE CITY ENGINEER
OCT. 1951 PROJ. NO. C 11-147

4 13 1 (56)