


BM 128.74 N.E. COR. COPING COR. W.S. CANAL BRIDGE ON MARKET

Prop
32.0
28.9
27.8
88.7
+10%
97.6 w/c


Cy
33.0
10.1
6.1
99.2
+10%
54.1 w/c

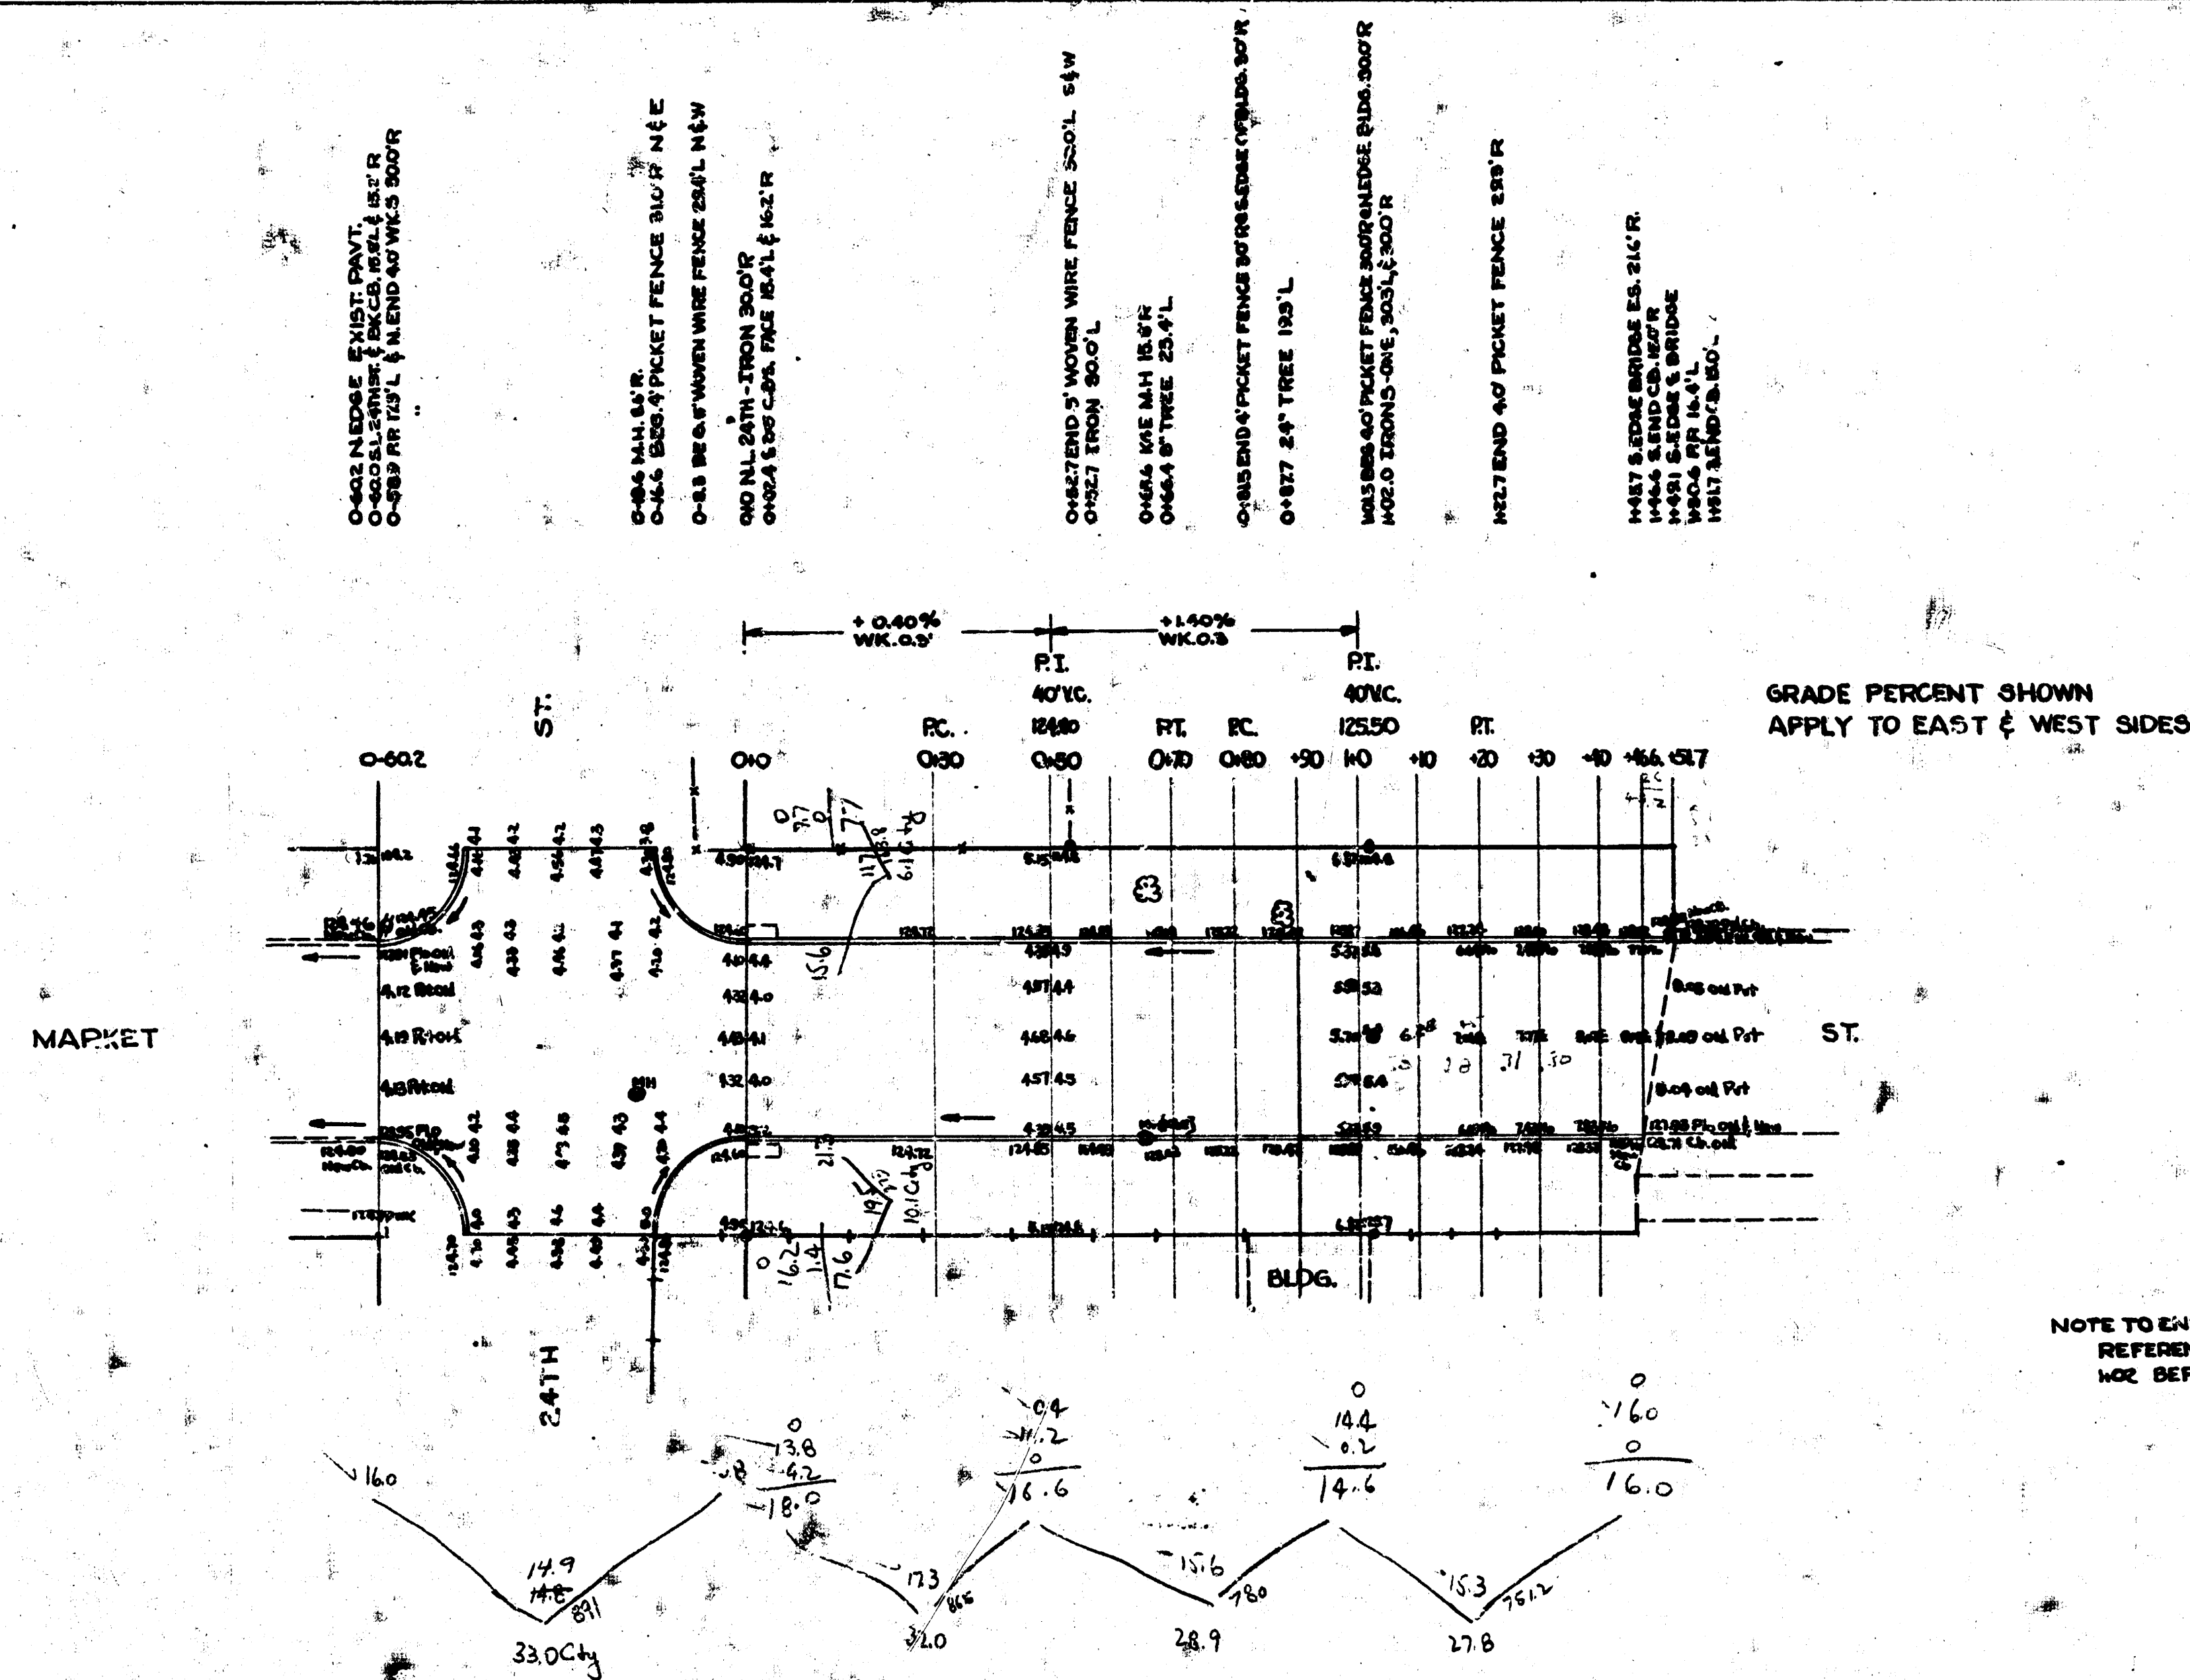

NOTE TO ENGINEER:
REFERENCE IRON & MARKET & STA.
W/C BEFORE START OF CONSTR.

N

SCALE 1" = 20'

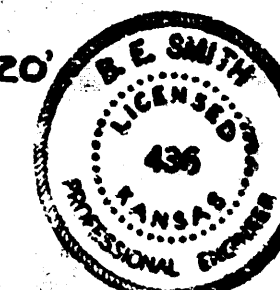

MARKET ST.
S.L. 24TH TO S.L. CANAL BRIDGE
30' CONC. CD.

CITY OF WICHITA, KANSAS
D.E. SMITH
APRIL 1953

CITY ENGINEER
PROJ. NO. C-13-11

1 4 3 15