




$$\begin{array}{r} 2863 \\ + 126.6 \\ \hline 2989.6 \end{array}$$

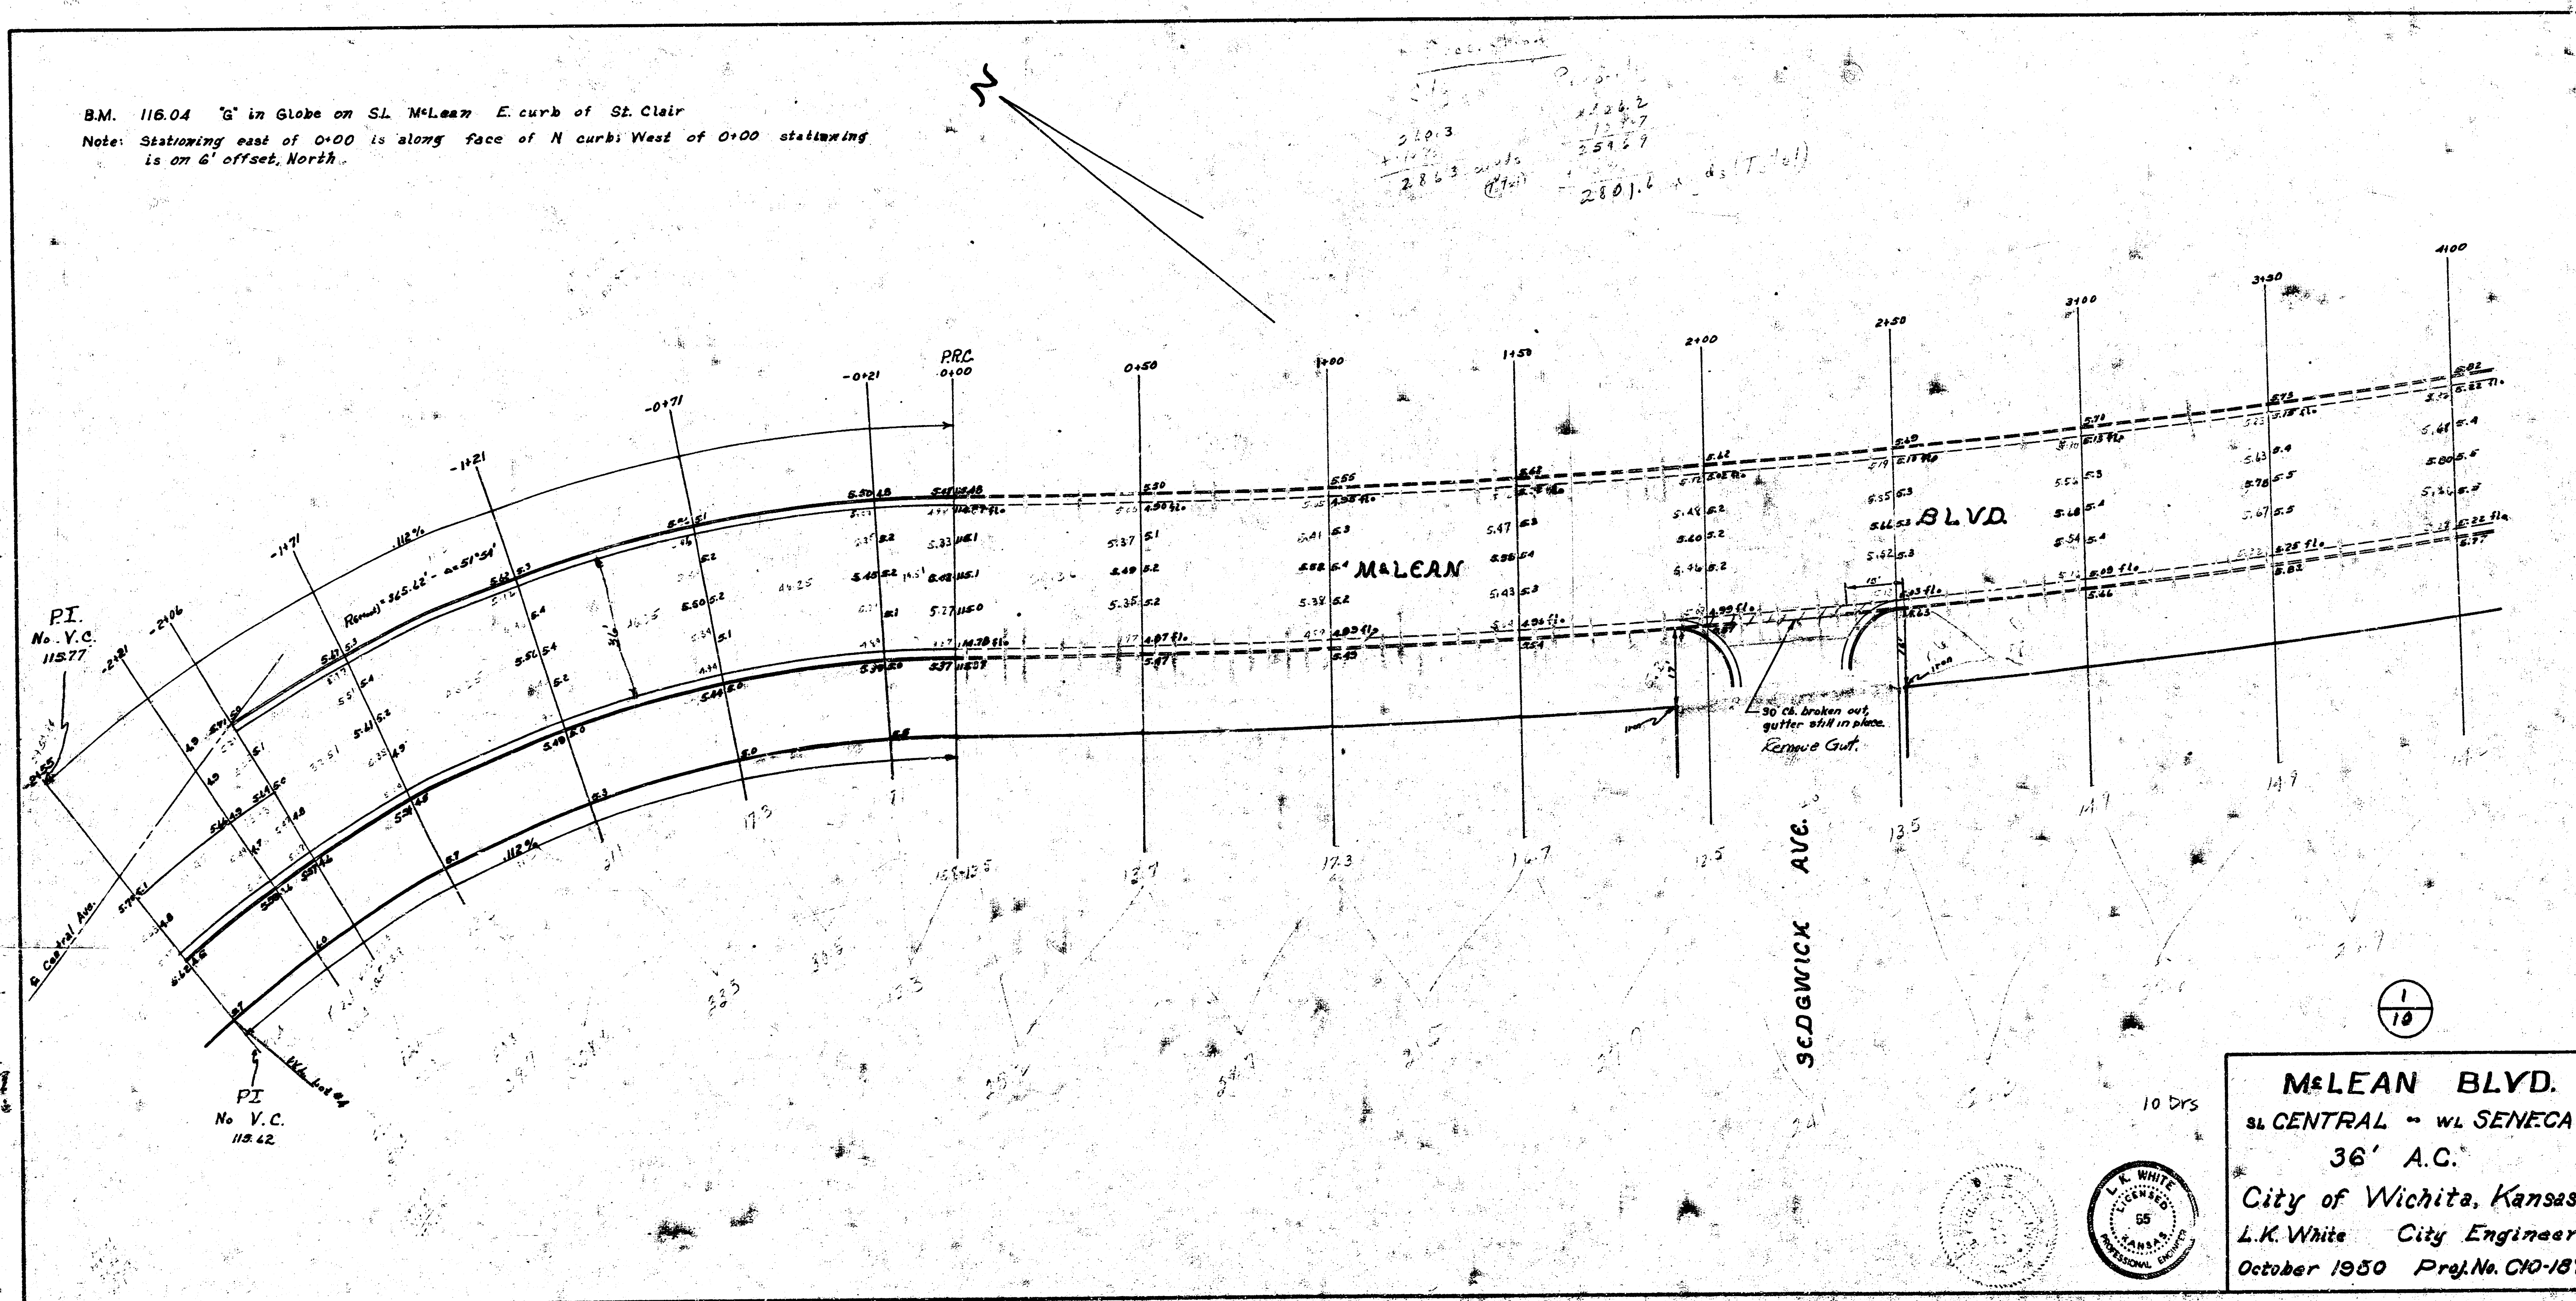


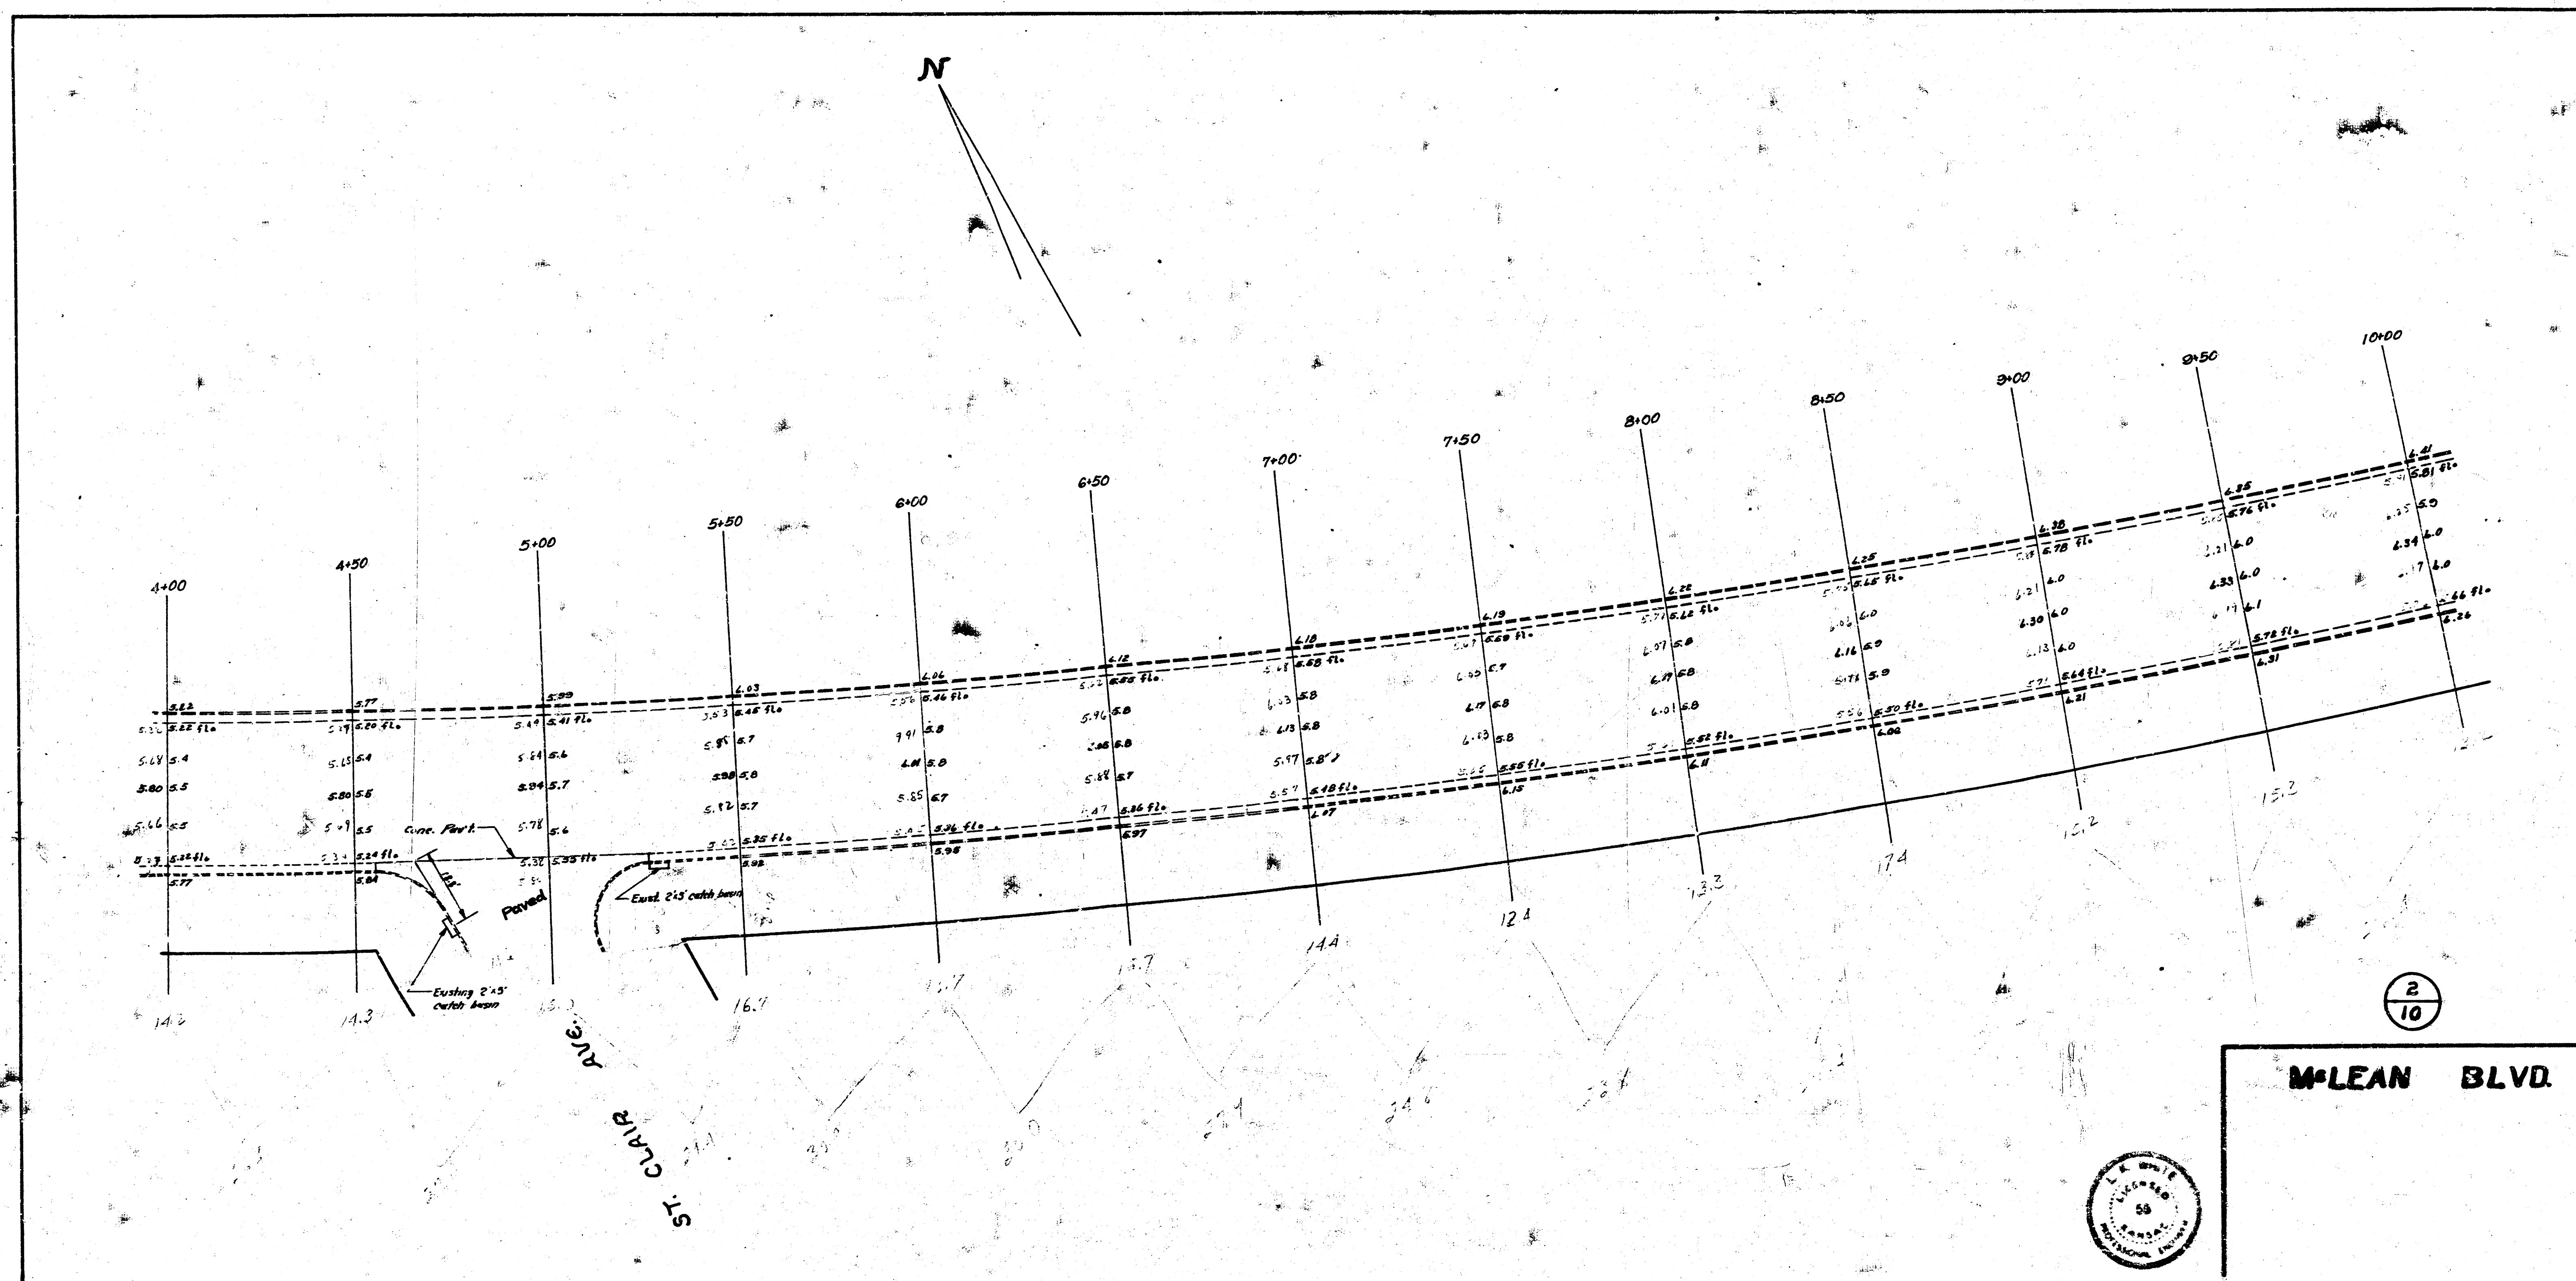


See note, sheet 4

MCLEAN BLVD.

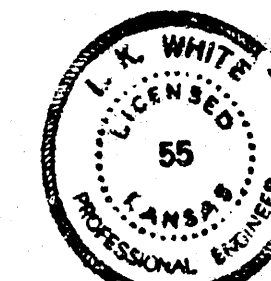



Note: Remove & replace approximately 300' curb & gutter to provide for proper drainage.
This work to be checked & exact amount determined by field engineer.

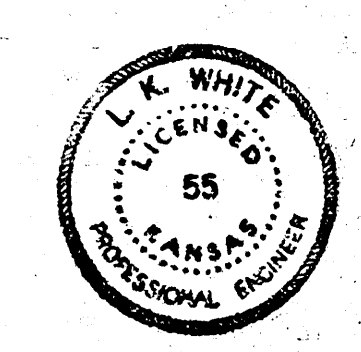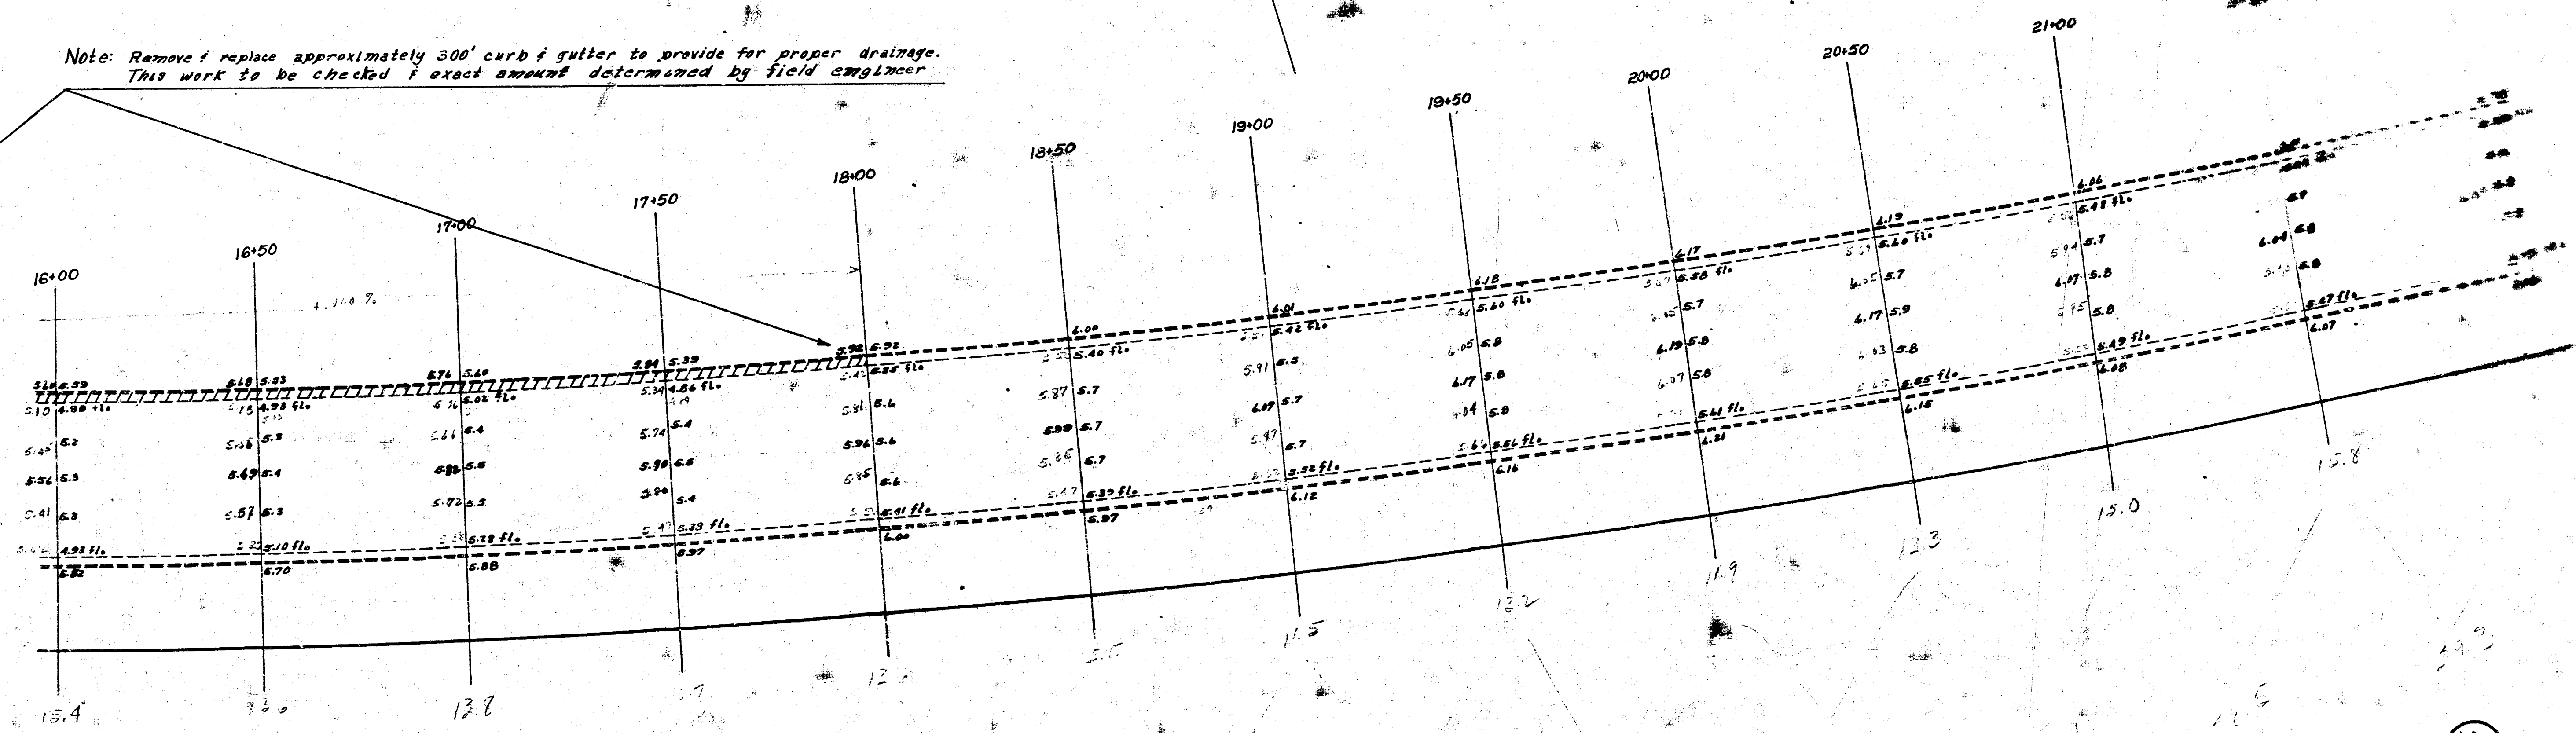


McLEAN BLVD.

4
10

Note: Remove & replace approximately 800' (sta 22+50 to 30+50) curb & gutter. Field engineer to check preliminary elevations prior to setting final grade.

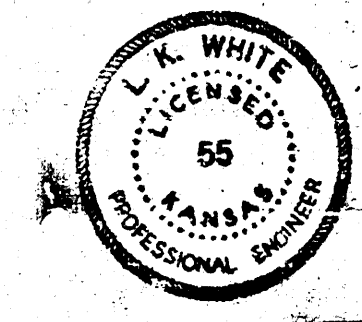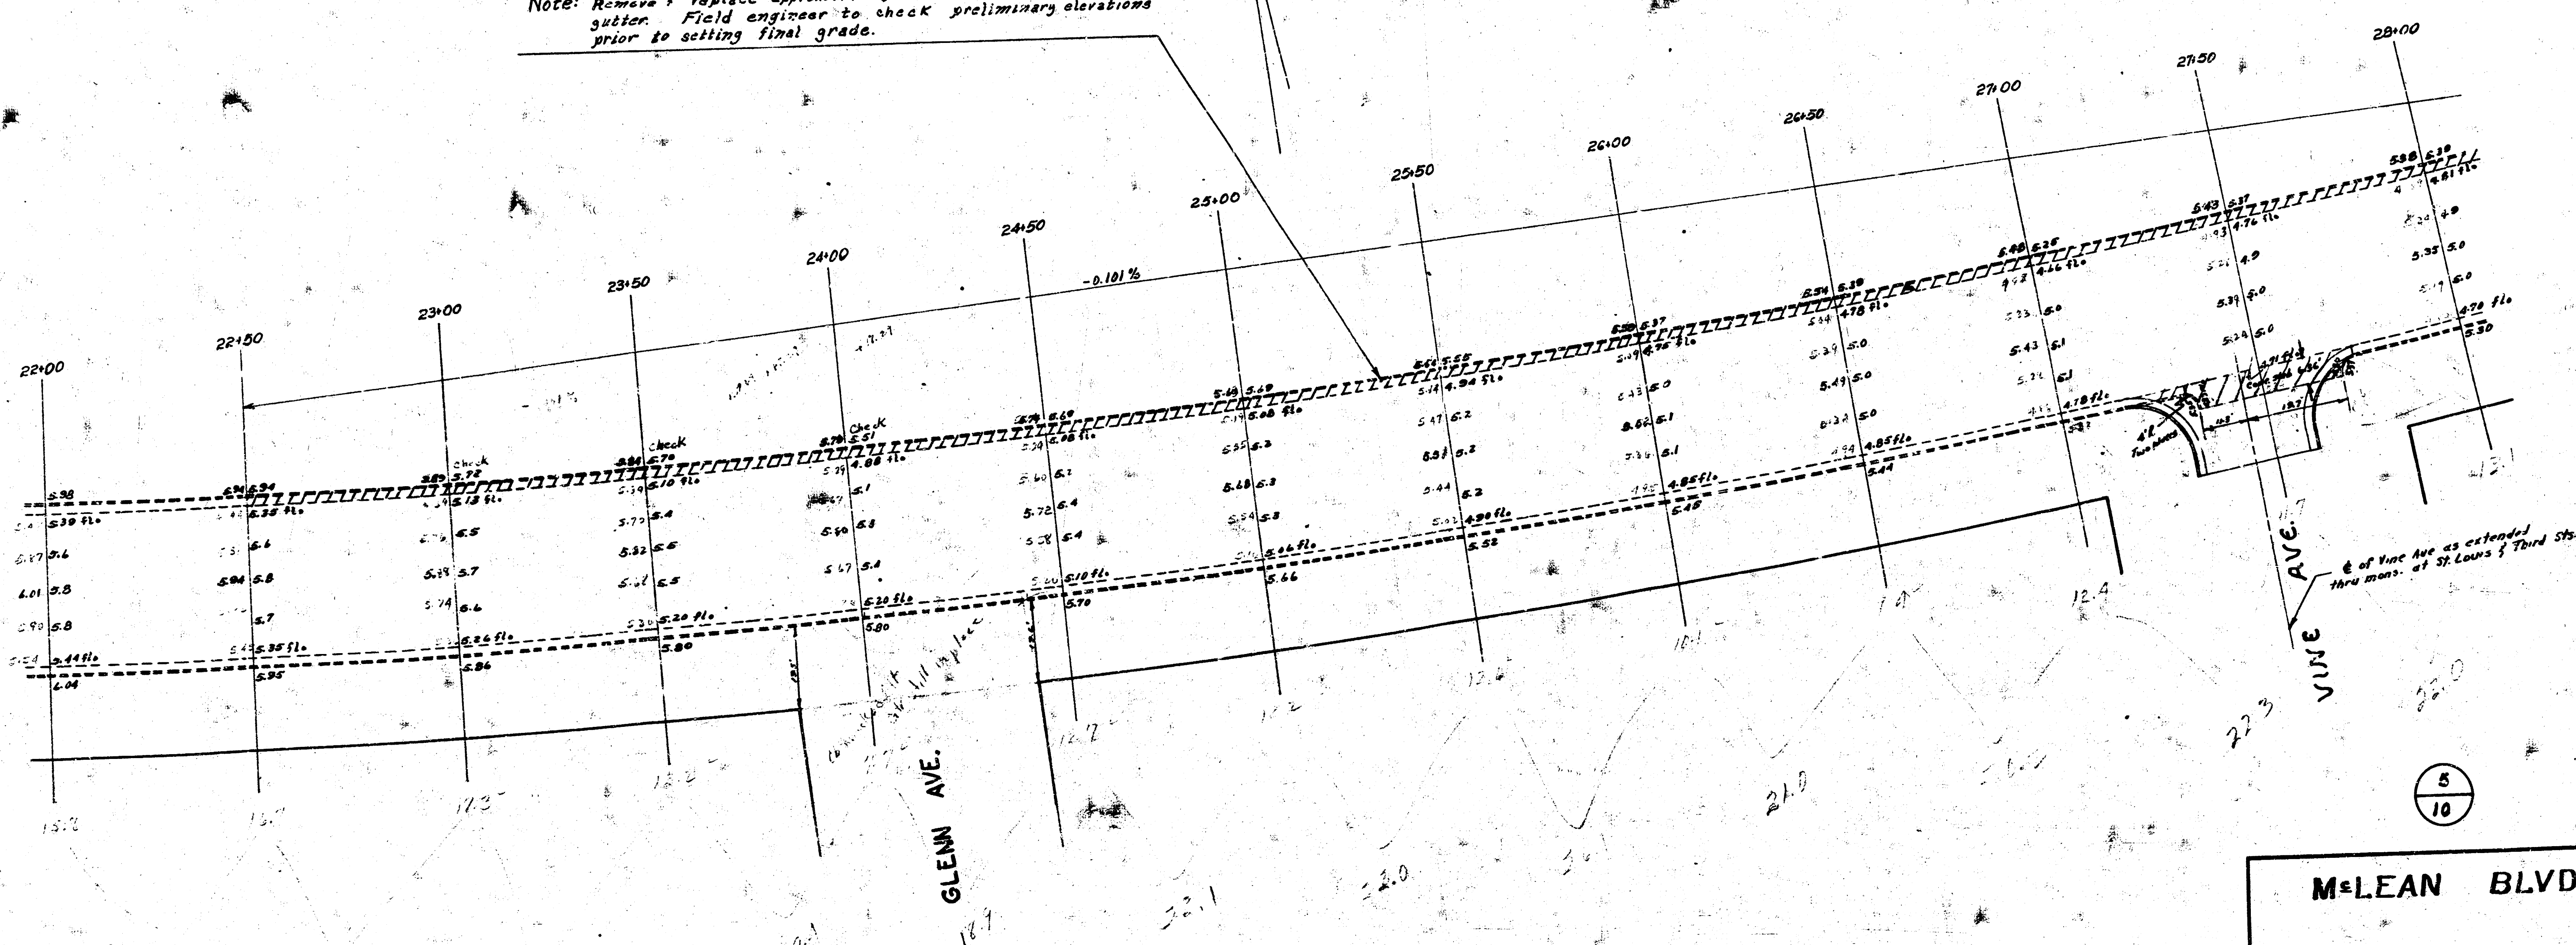

M^{LE}AN BLVD

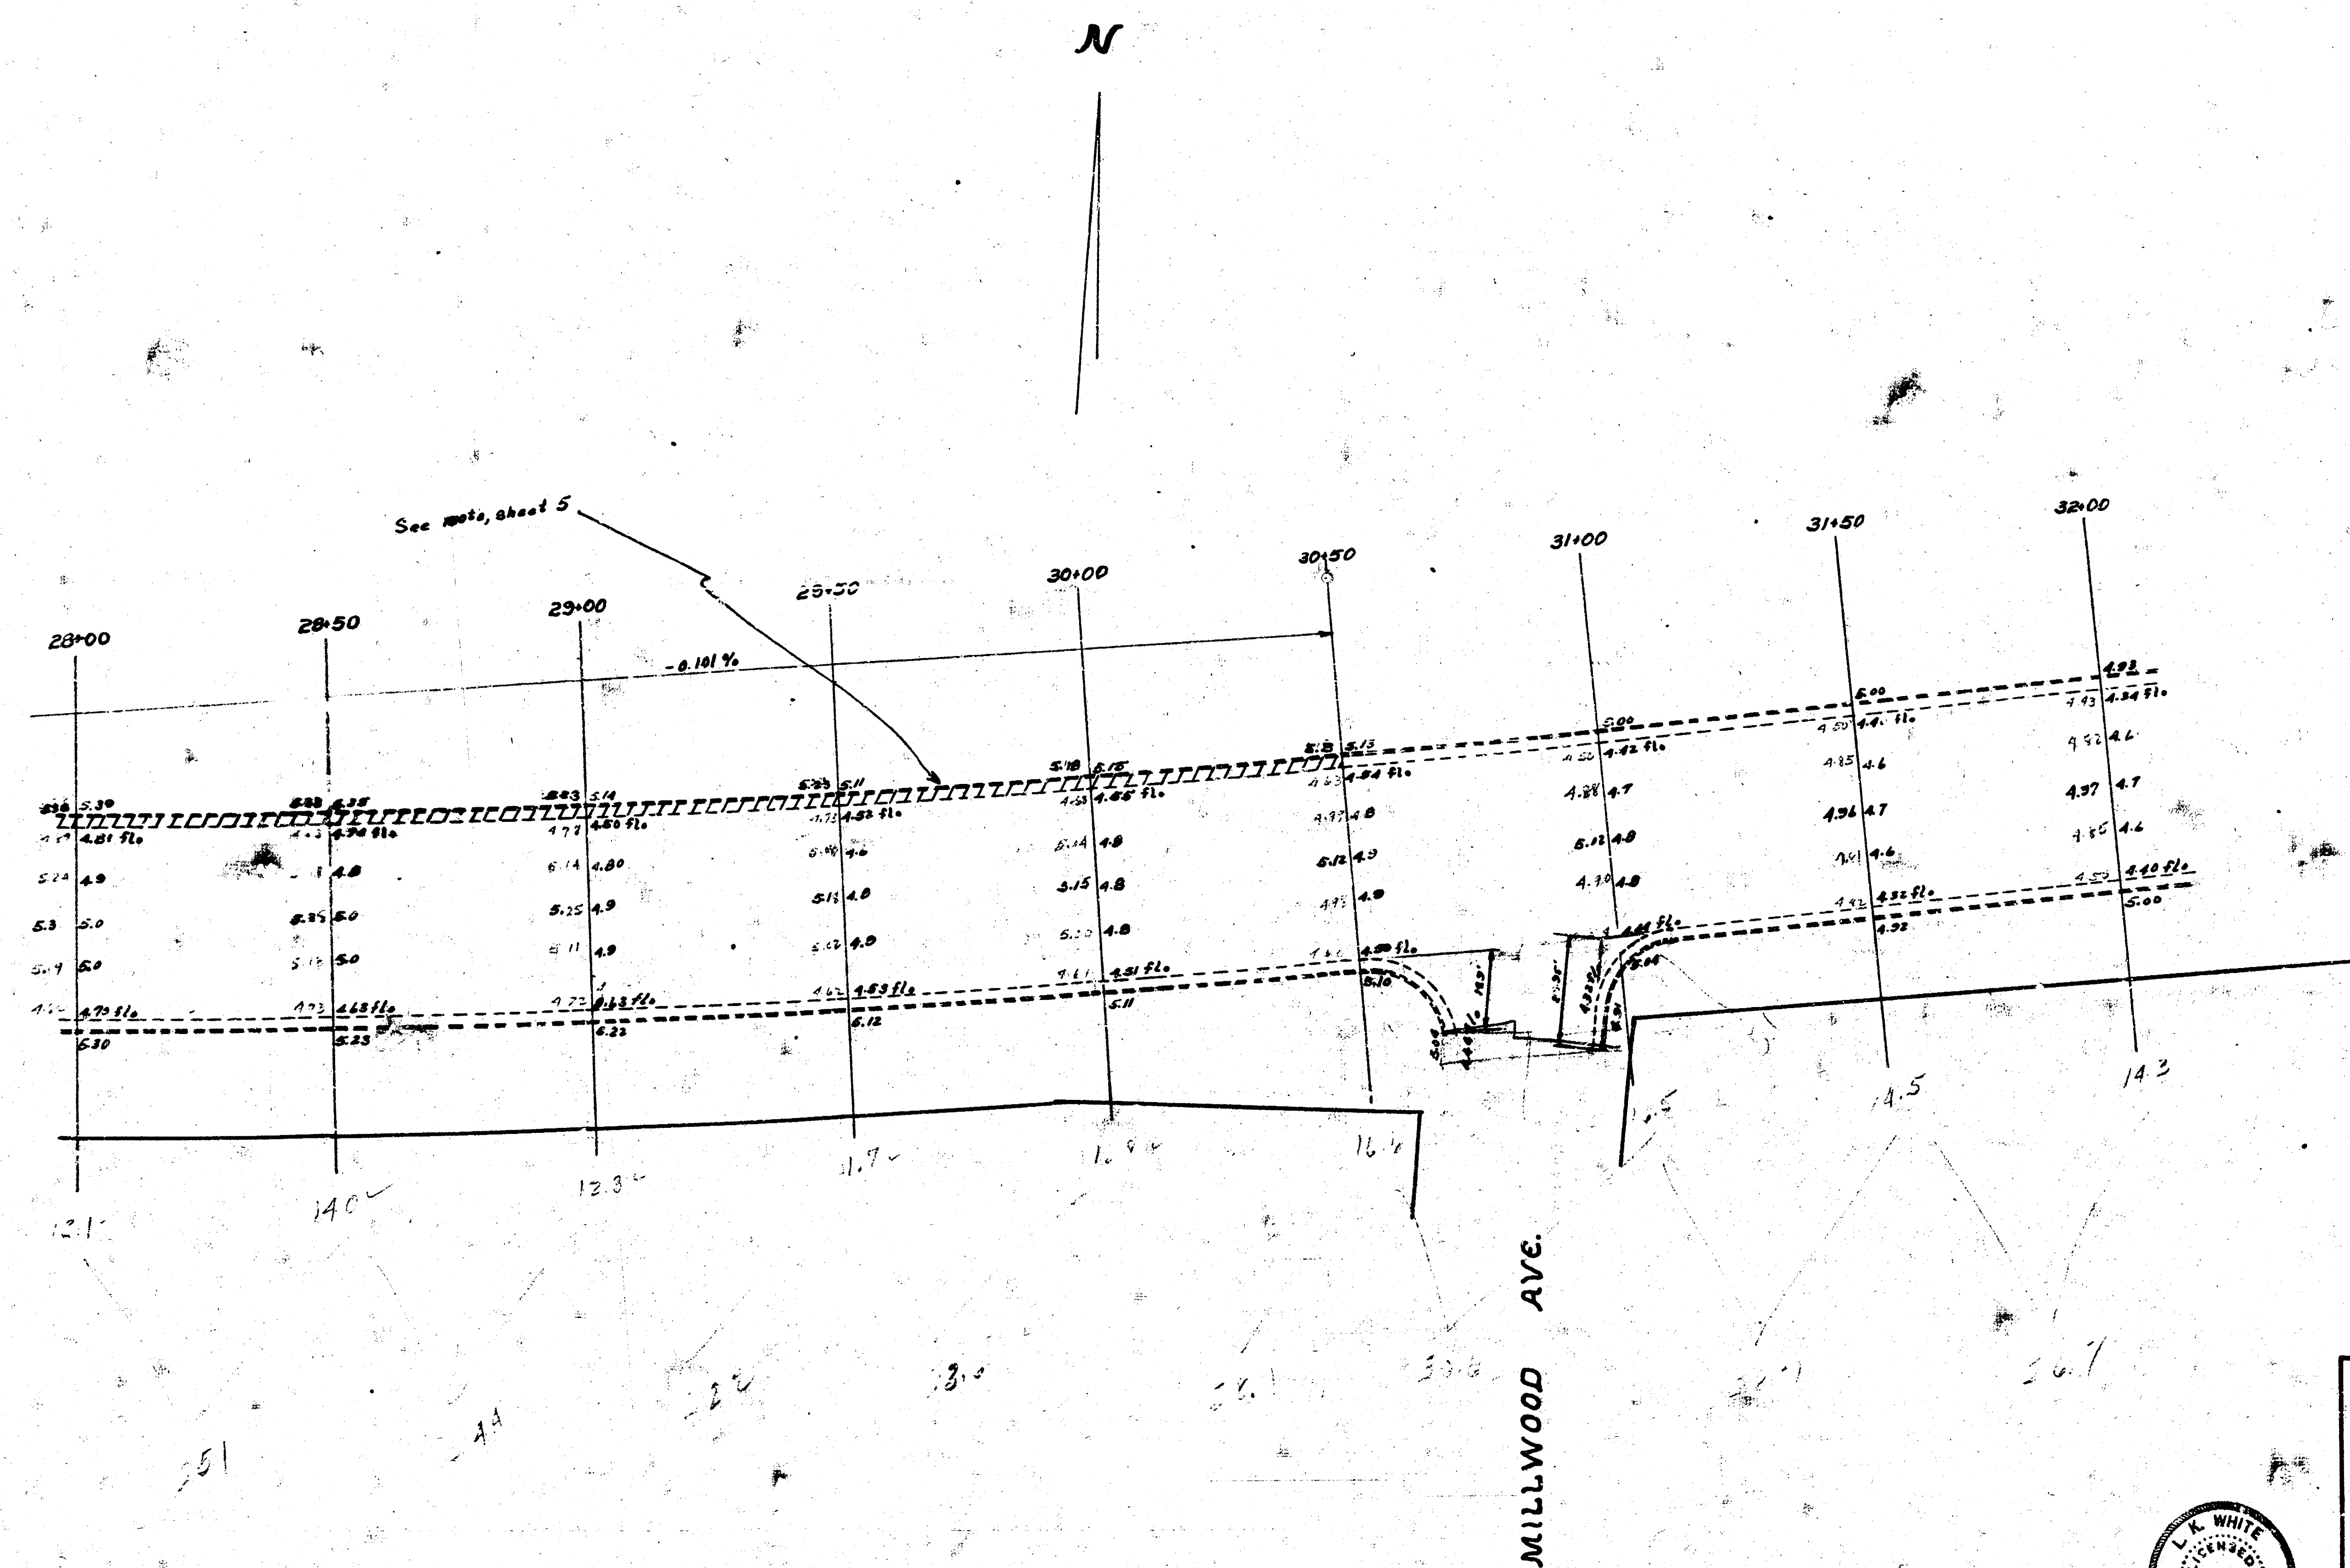

6/10

McLEAN BLVD.

