


MERIDIAN AVE.


FROM 21' N. OF NL. UNIVERSITY TO NL. BROCKWAY

C12-179
C13-144

*Revised
Change 12-179
University N.
11-1-1955
B.L.*

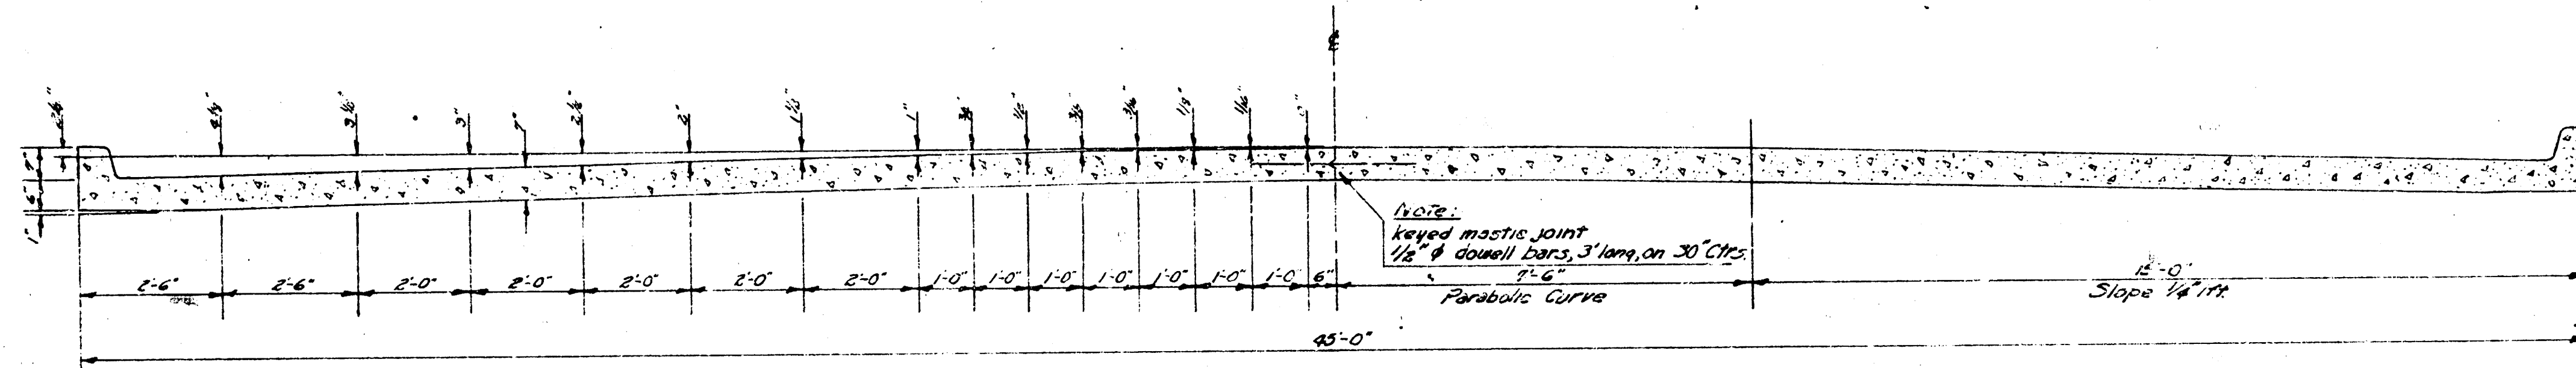


TYPICAL SECTION
NO SCALE

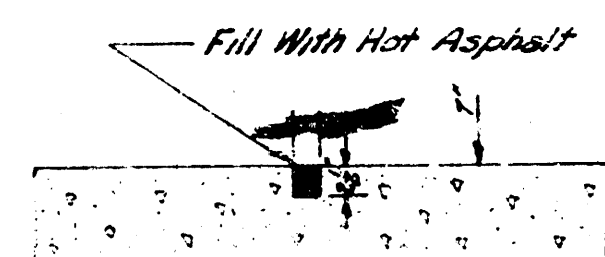


CONTRACTION JOINT DETAIL
NO SCALE

NOTE -

WHERE CURBS IN THE SAME SECTION
ARE AT DIFFERENT ELEVATIONS USE
ELEVATION SHOWN ON PLAN FOR
CONSTRUCTION JOINT.

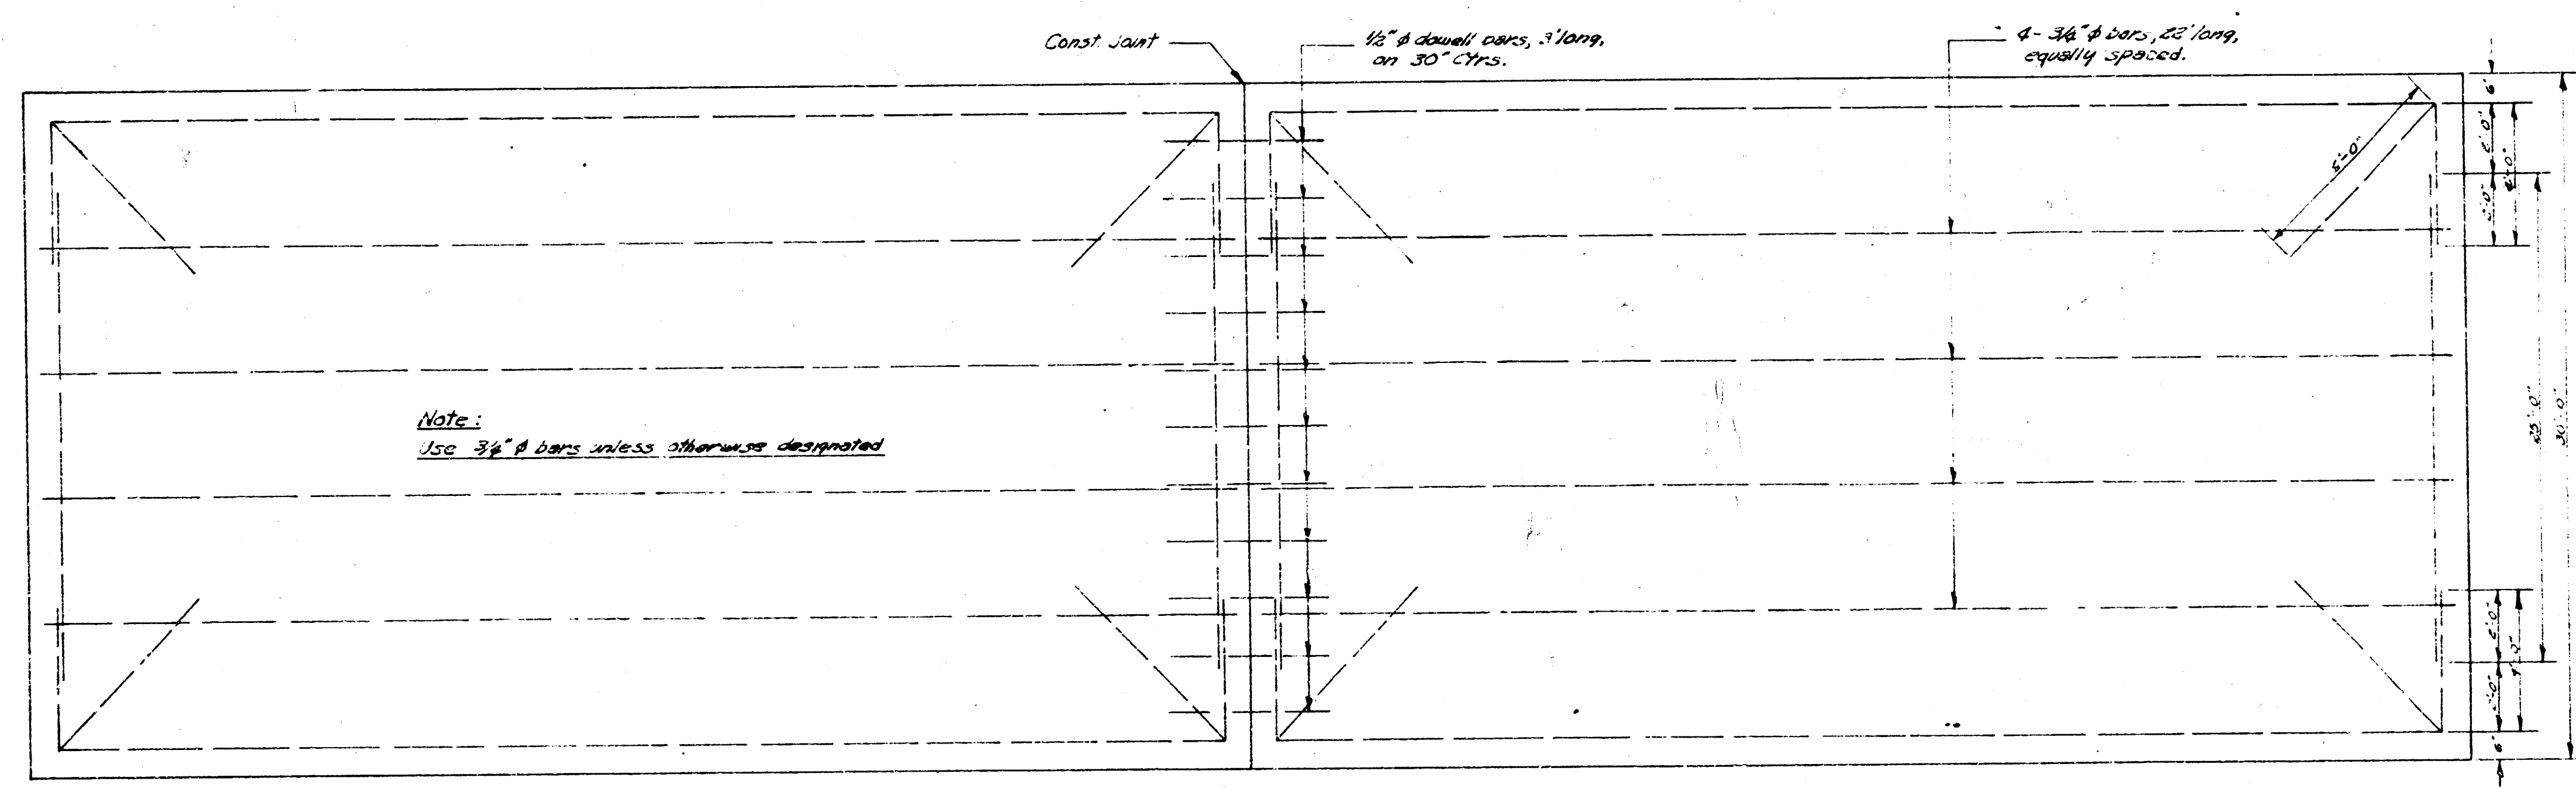


STEEL PATTERN
NO SCALE

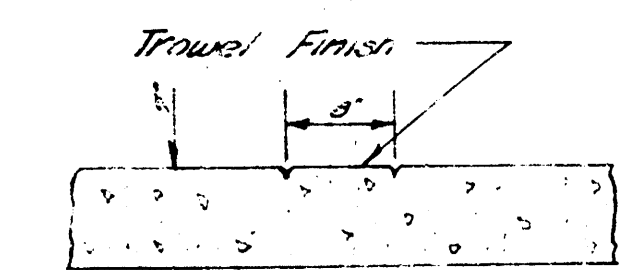

C.L. MARKER DETAIL
NO SCALE

11-11-34
E. E. Smith
C.E.

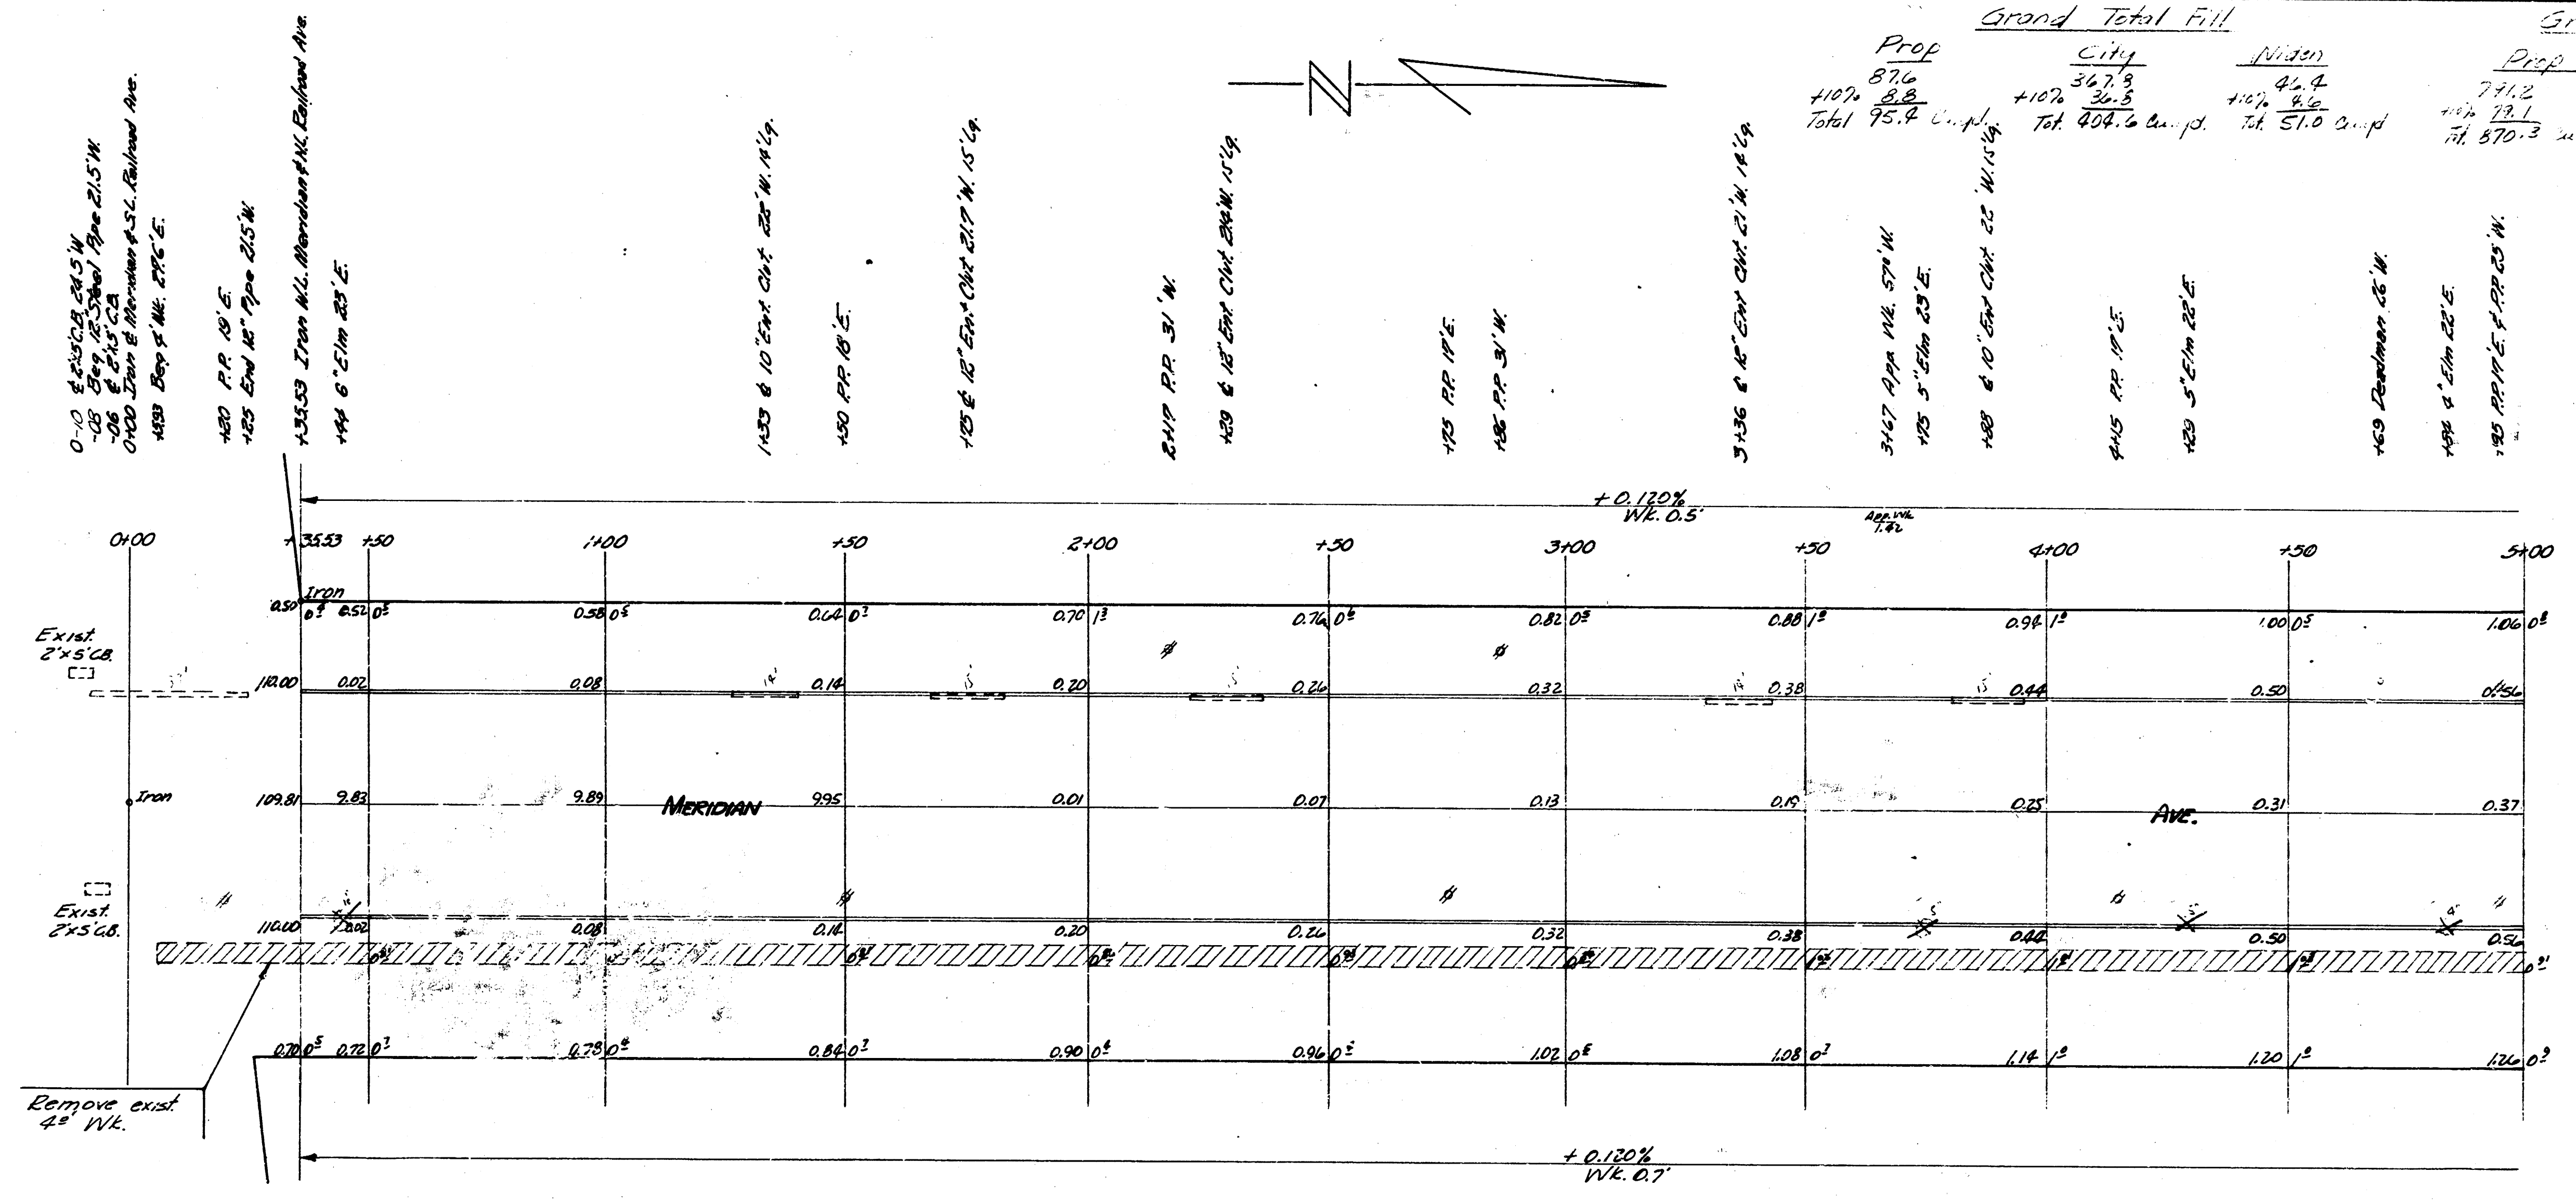

Grand Total Fill			Grand Total Excav.		
Prop.	City	Wilson	Prop.	City	Wilson

Hand Excav.	
Prop.	City
0	20.0 cu. yd.

NOTE: EXTRA STEEL IN CONC.
HEADERS AT APPROACH TO TEACHES.
See detail sheet #3

B.M. 11.09 4" on 3.0m M.H. 120' E. & Meridian 12.5 W. W. R.W.
Stationing on E.



MERIDIAN
21' N. of N.L. UNIVERSITY TO N.L. BRACKNEY
7'- 44' CONC. & C.B.
CITY OF WICHITA KANSAS
E. E. SMITH CITY ENGINEER
JUNE 1934 PROJ. NOS. C.E.-175 F.C.D.-144

