


Property

38.7
36.5
33.7
30.9
28.0
25.0
22.6

Property

38.7
36.5
33.7
30.9
28.0
25.0
22.6

100
36.7 1/2

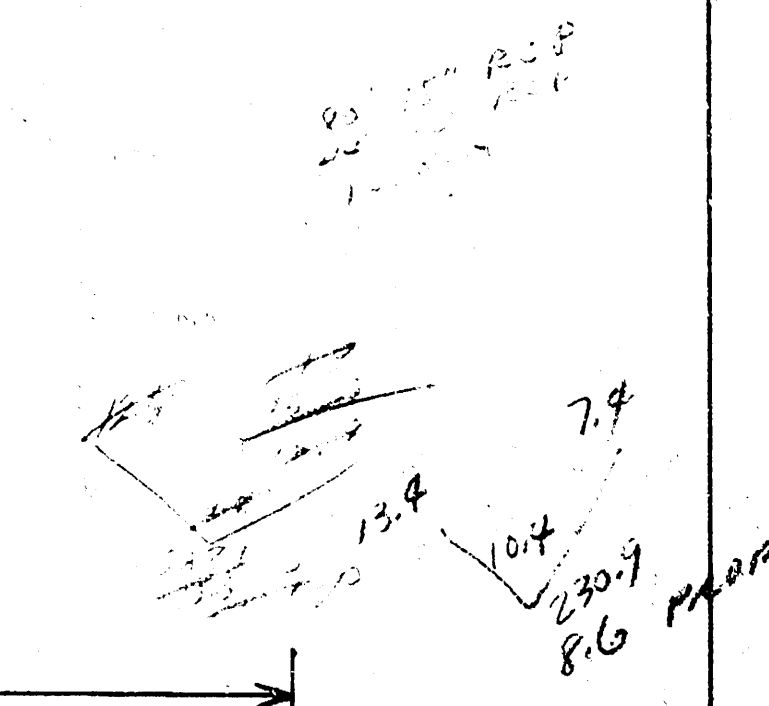

Meridian Ave.
N. 14th Grmick - S. L. Abandoned NW
90' Conc & Cb.
City of Wichita, Kansas
L. H. White City Engineer
June 1948 Project C-15