

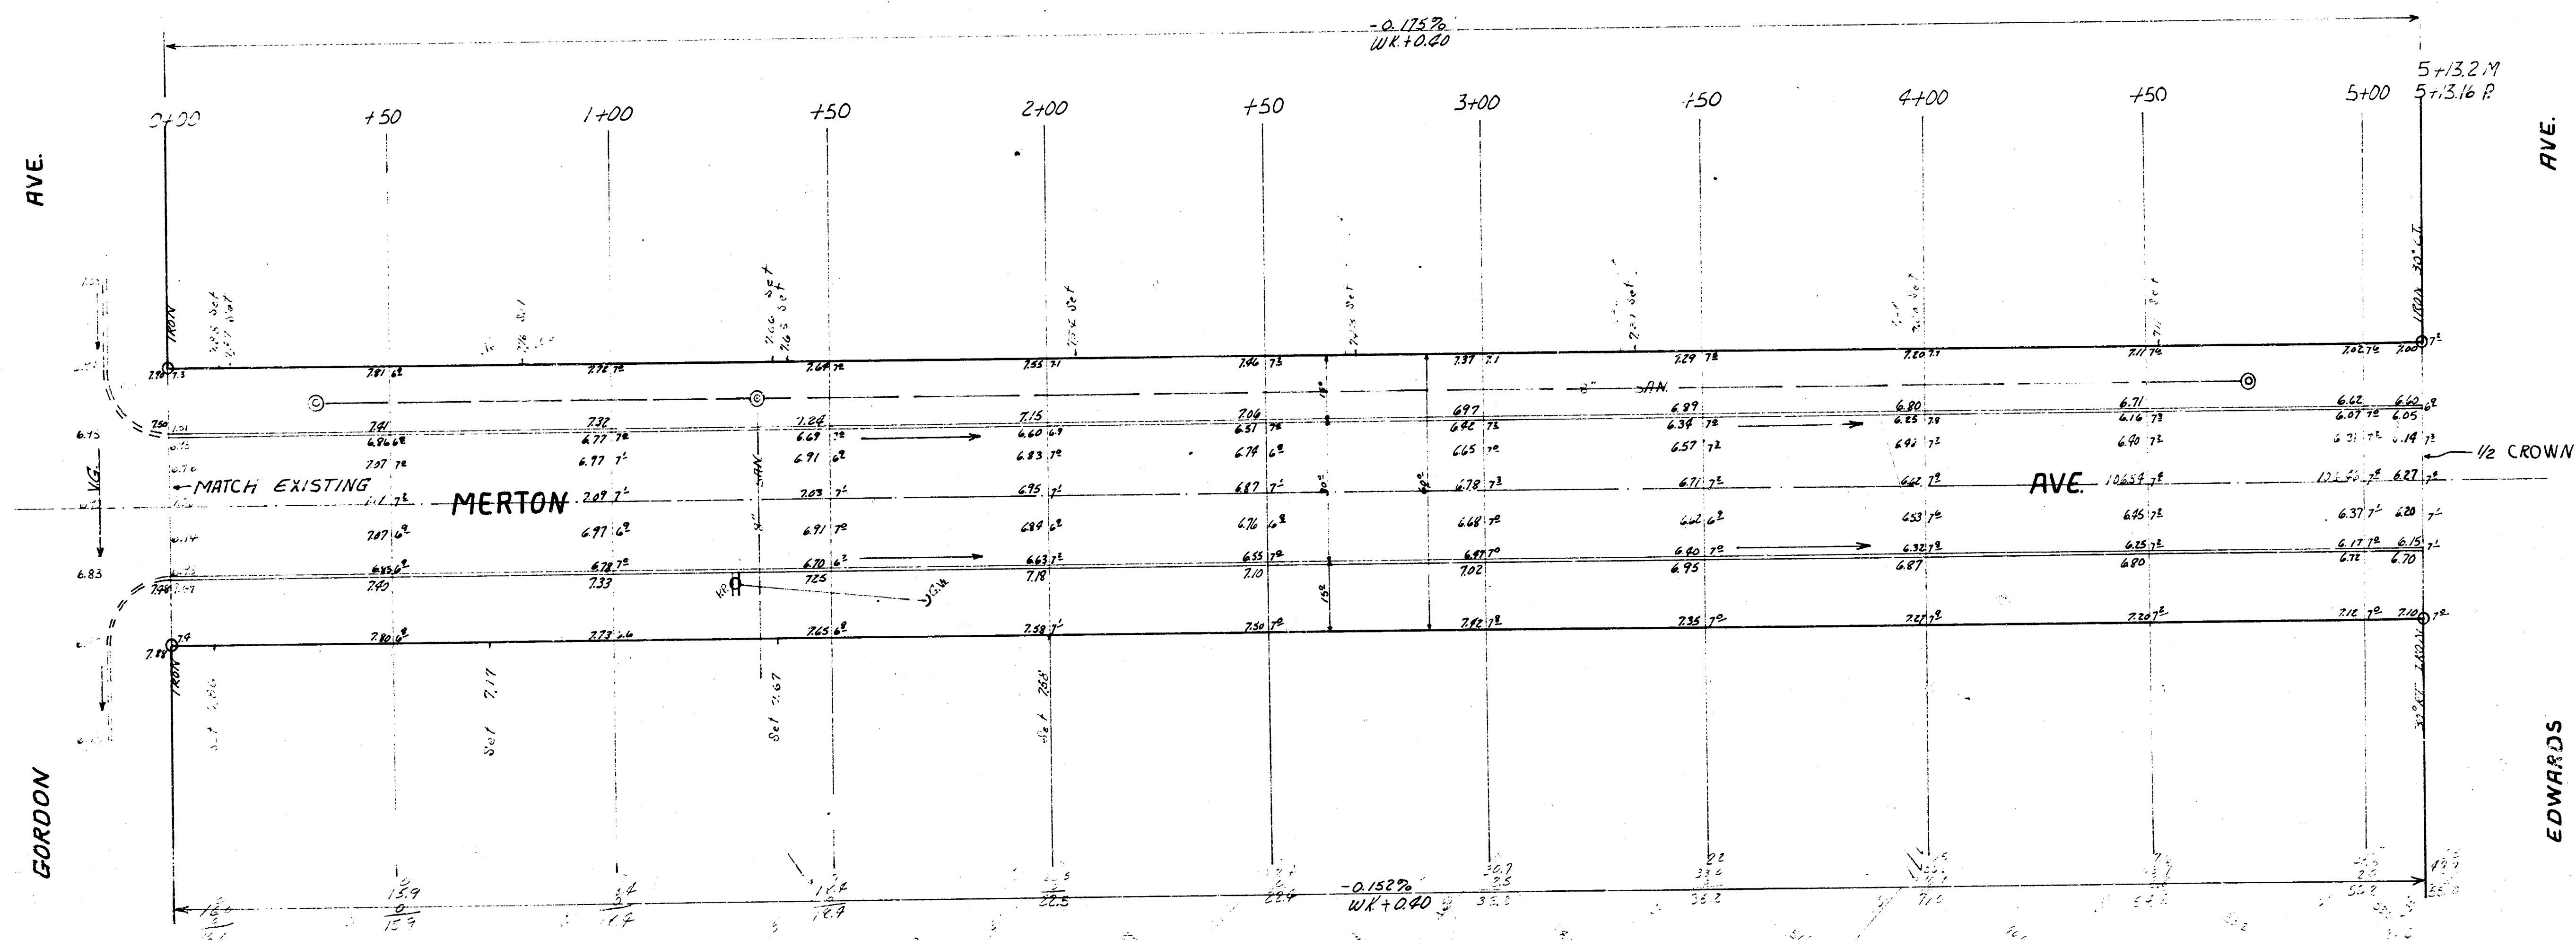


B.M. 109.92 S.E. COR. CONC. PDR. HQ #1657 NW. COR. MERTON & GORDON
 BASE LINE ON E

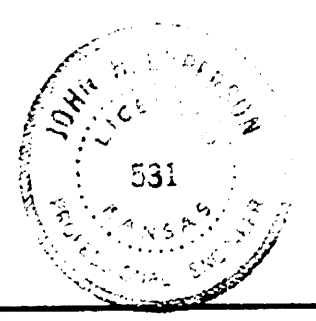

MERTON AVE.
 E.L. GORDON W.L. EDWARDS
 30' CONC. & CB.
 CITY OF WICHITA, KANS.
 B.E. SMITH CITY ENGINEER
 DATE APRIL 1959 PROJ. NO. C-18-194

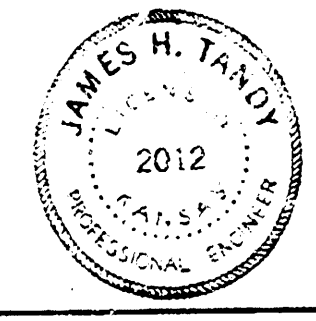

7 AL EXCAV.
 PROP
 3/18
 4075 681
 1955