



BM 12295 "G" IN GRADE 7' W. END S. RT. MILLAIR & MANLYS
 BM 12437 "T" IN TROY TOP PLUS NE COR. WINTERPOLL & 24TH ST.

Surveyed
 by
 B.E. Smith
 Checked
 S.E.E.

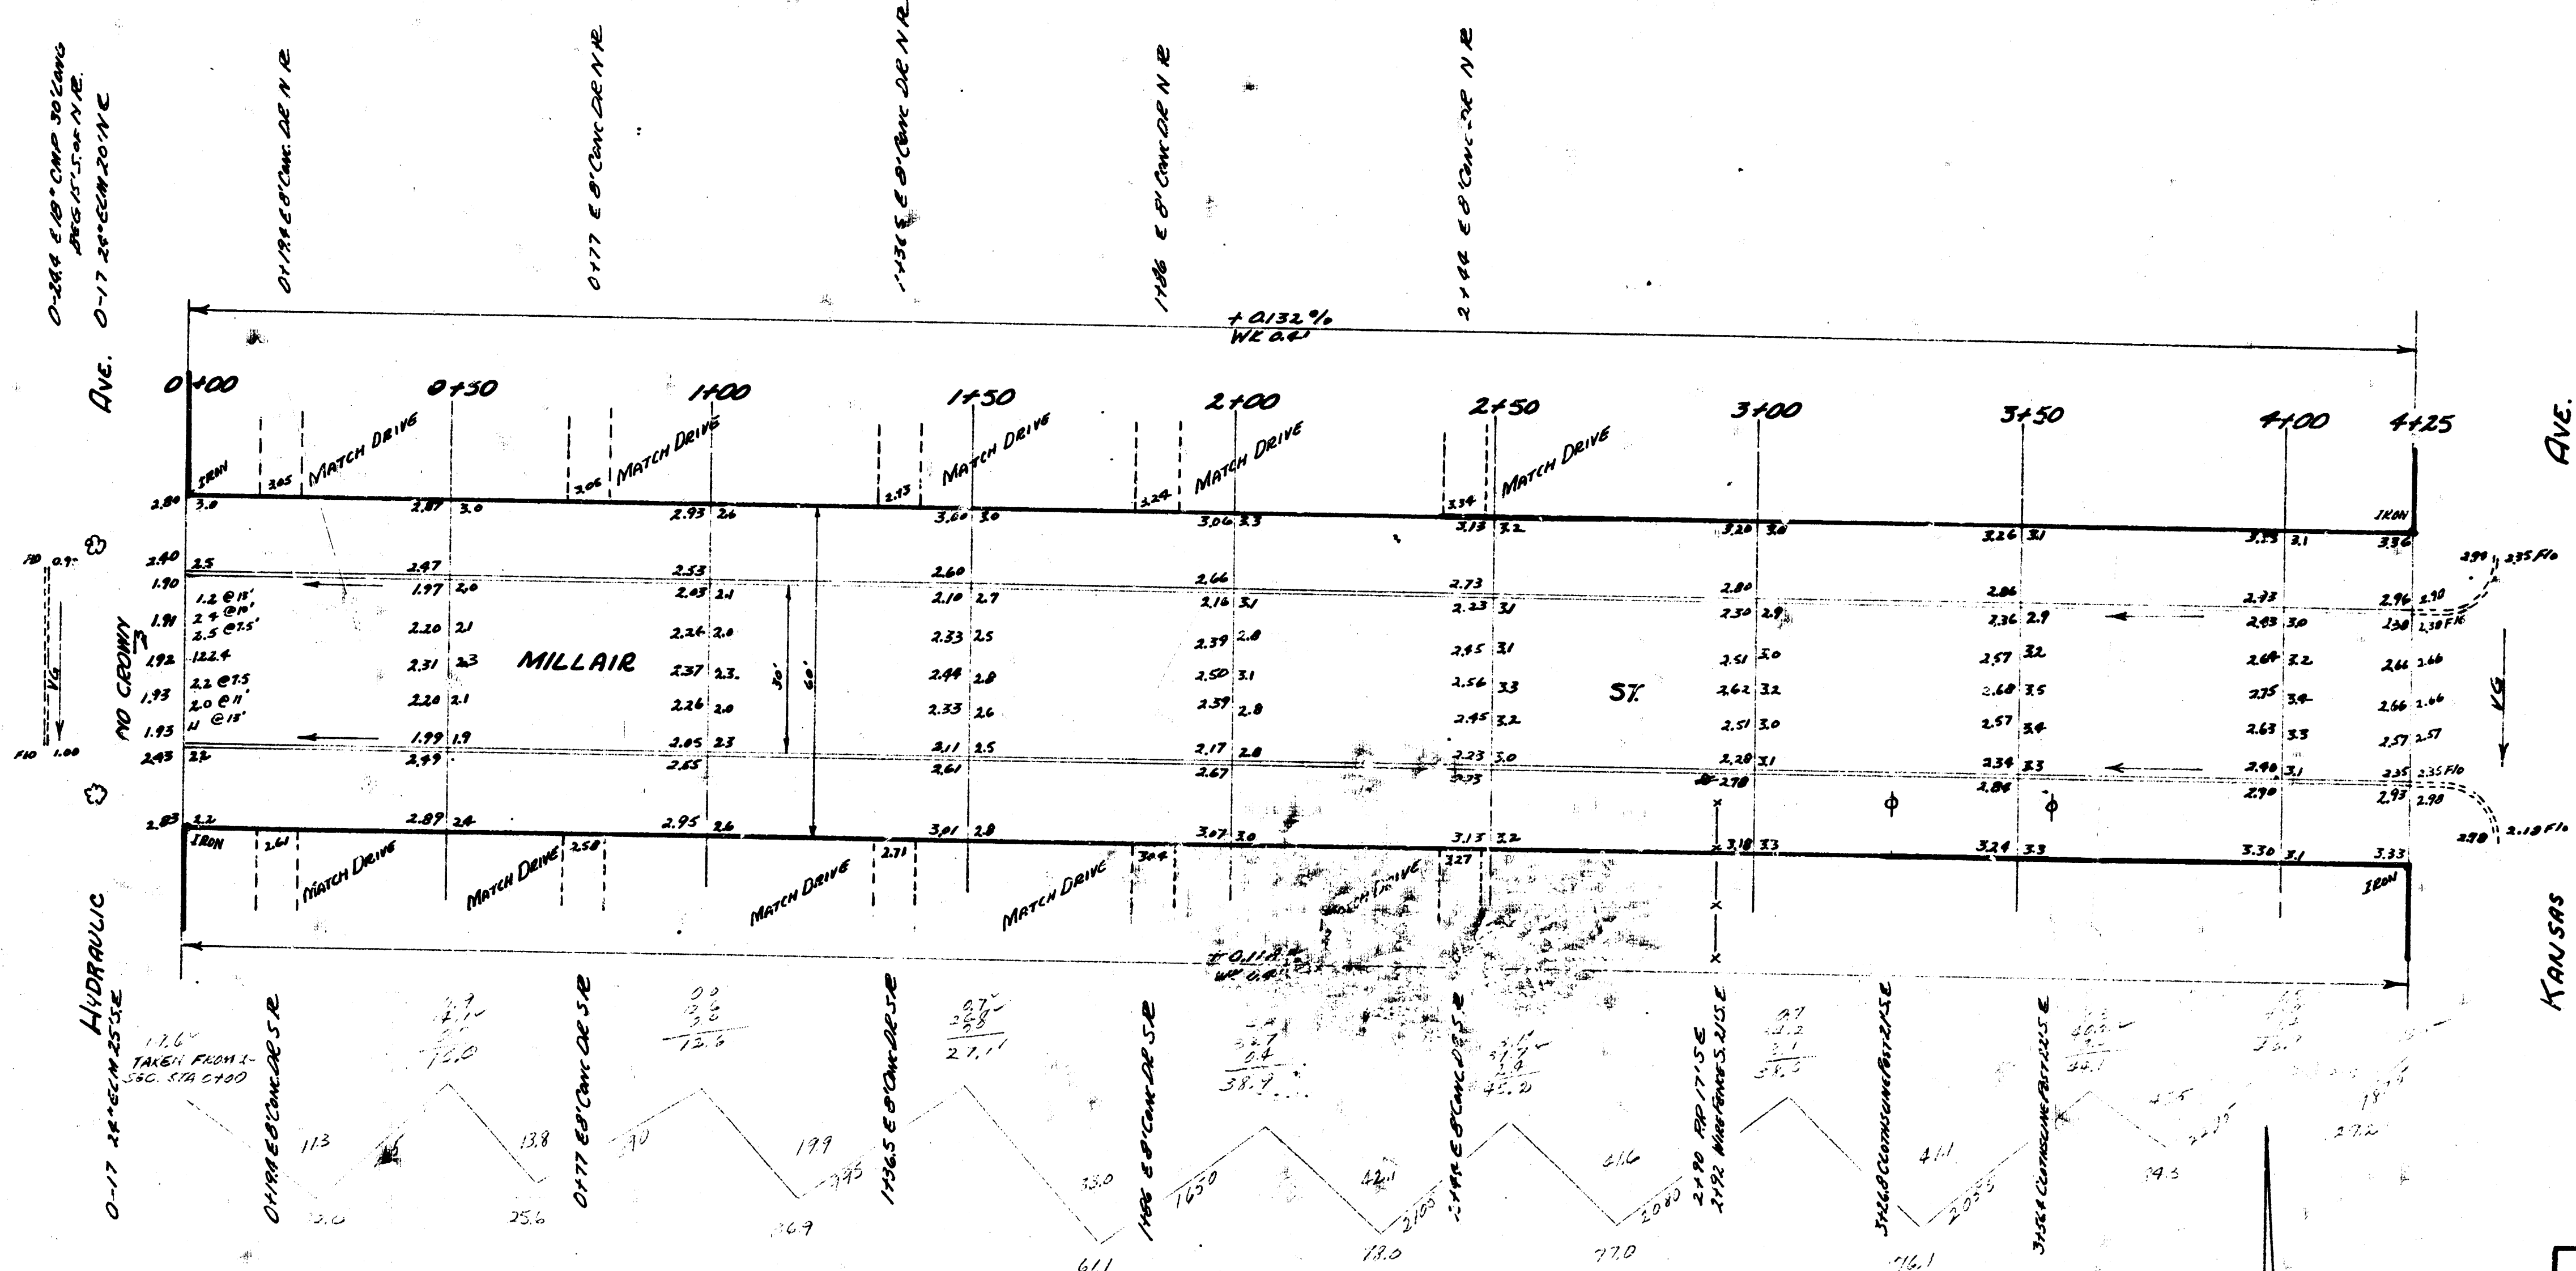

MILLAIR ST.
 E.L. HYDRAULIC TO W. KANSAS
 30' CONC. CB
 CITY OF WICHITA, KANSAS
 B.E. SMITH CITY ENGINEER
 JAN. 13, 1953 PROJ. NO. C12-148

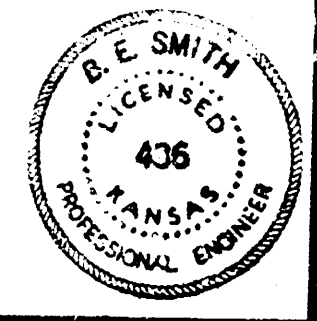

1"=20'