
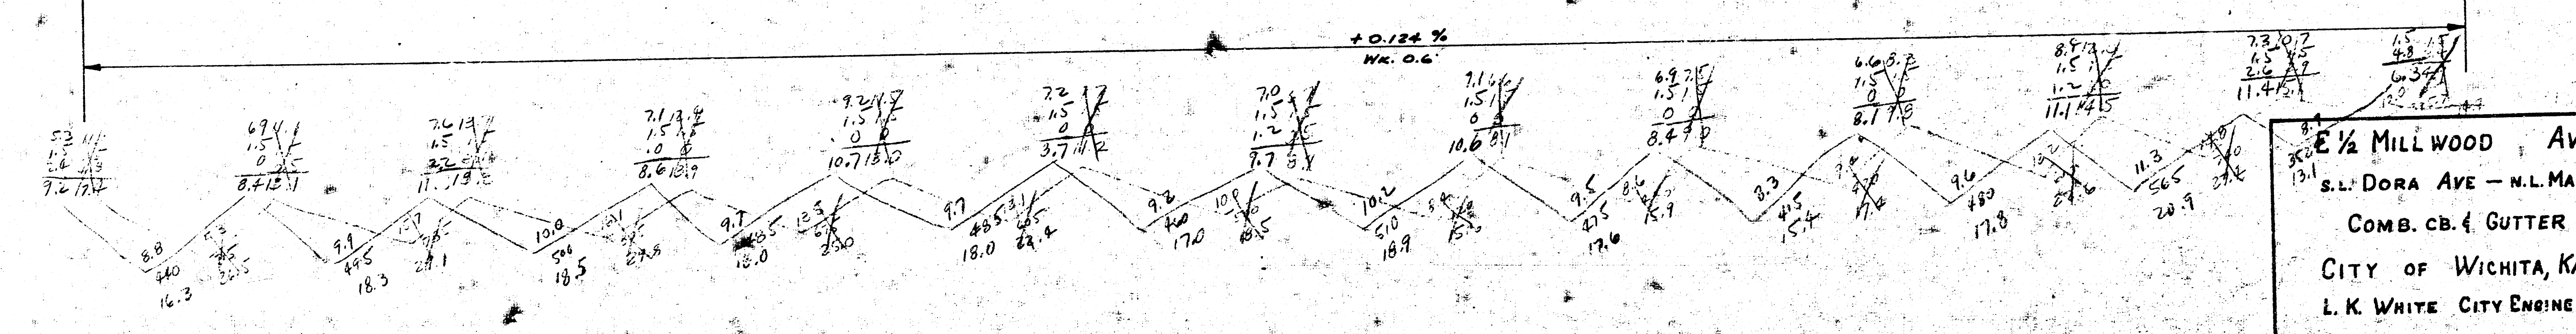


B.M. 102.79 "6" in Globe Wcb. Millwood (N.L. May.


B.M. 103.45 "0" in Globe Ecb. Millwood (N.L. Dora.

Note: Y.B. Hf.3. Both sides of Millwood.

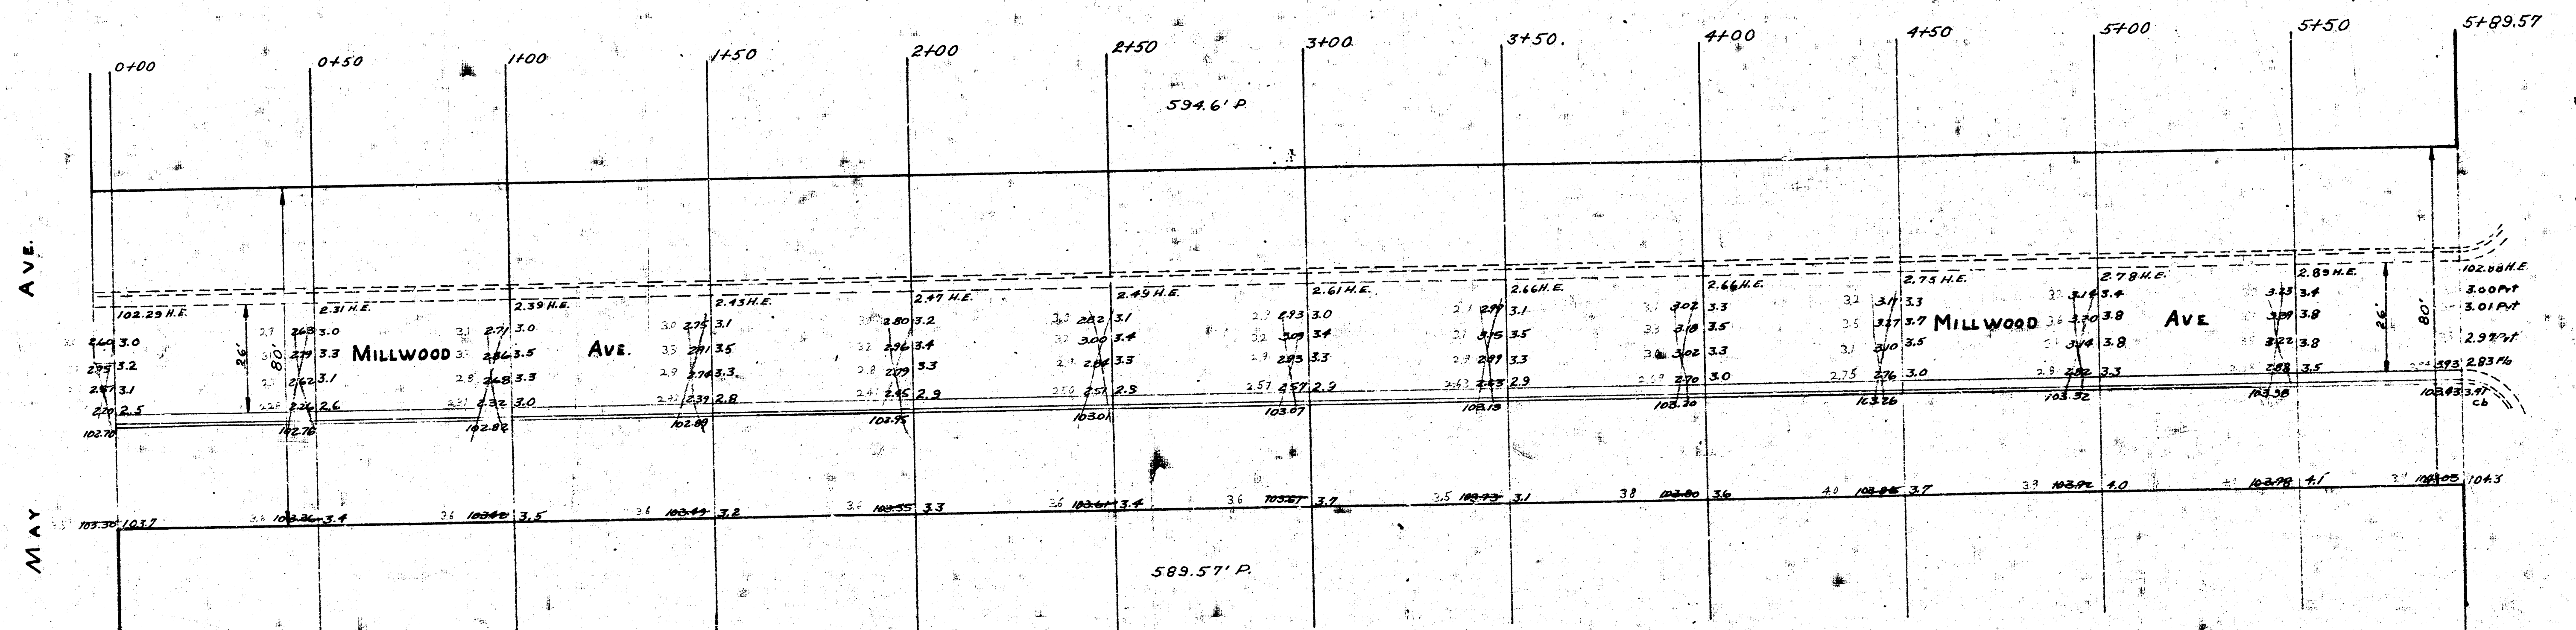

1/2 MILLWOOD AVE.
S.L. DORA AVE - N.L. MAY AVE.
COMB. CB. & GUTTER
CITY OF WICHITA, KANSAS
L. K. WHITE CITY ENGINEER
APRIL, 1950 PROJECT No. 10-19

Book 52 Pages 30-31

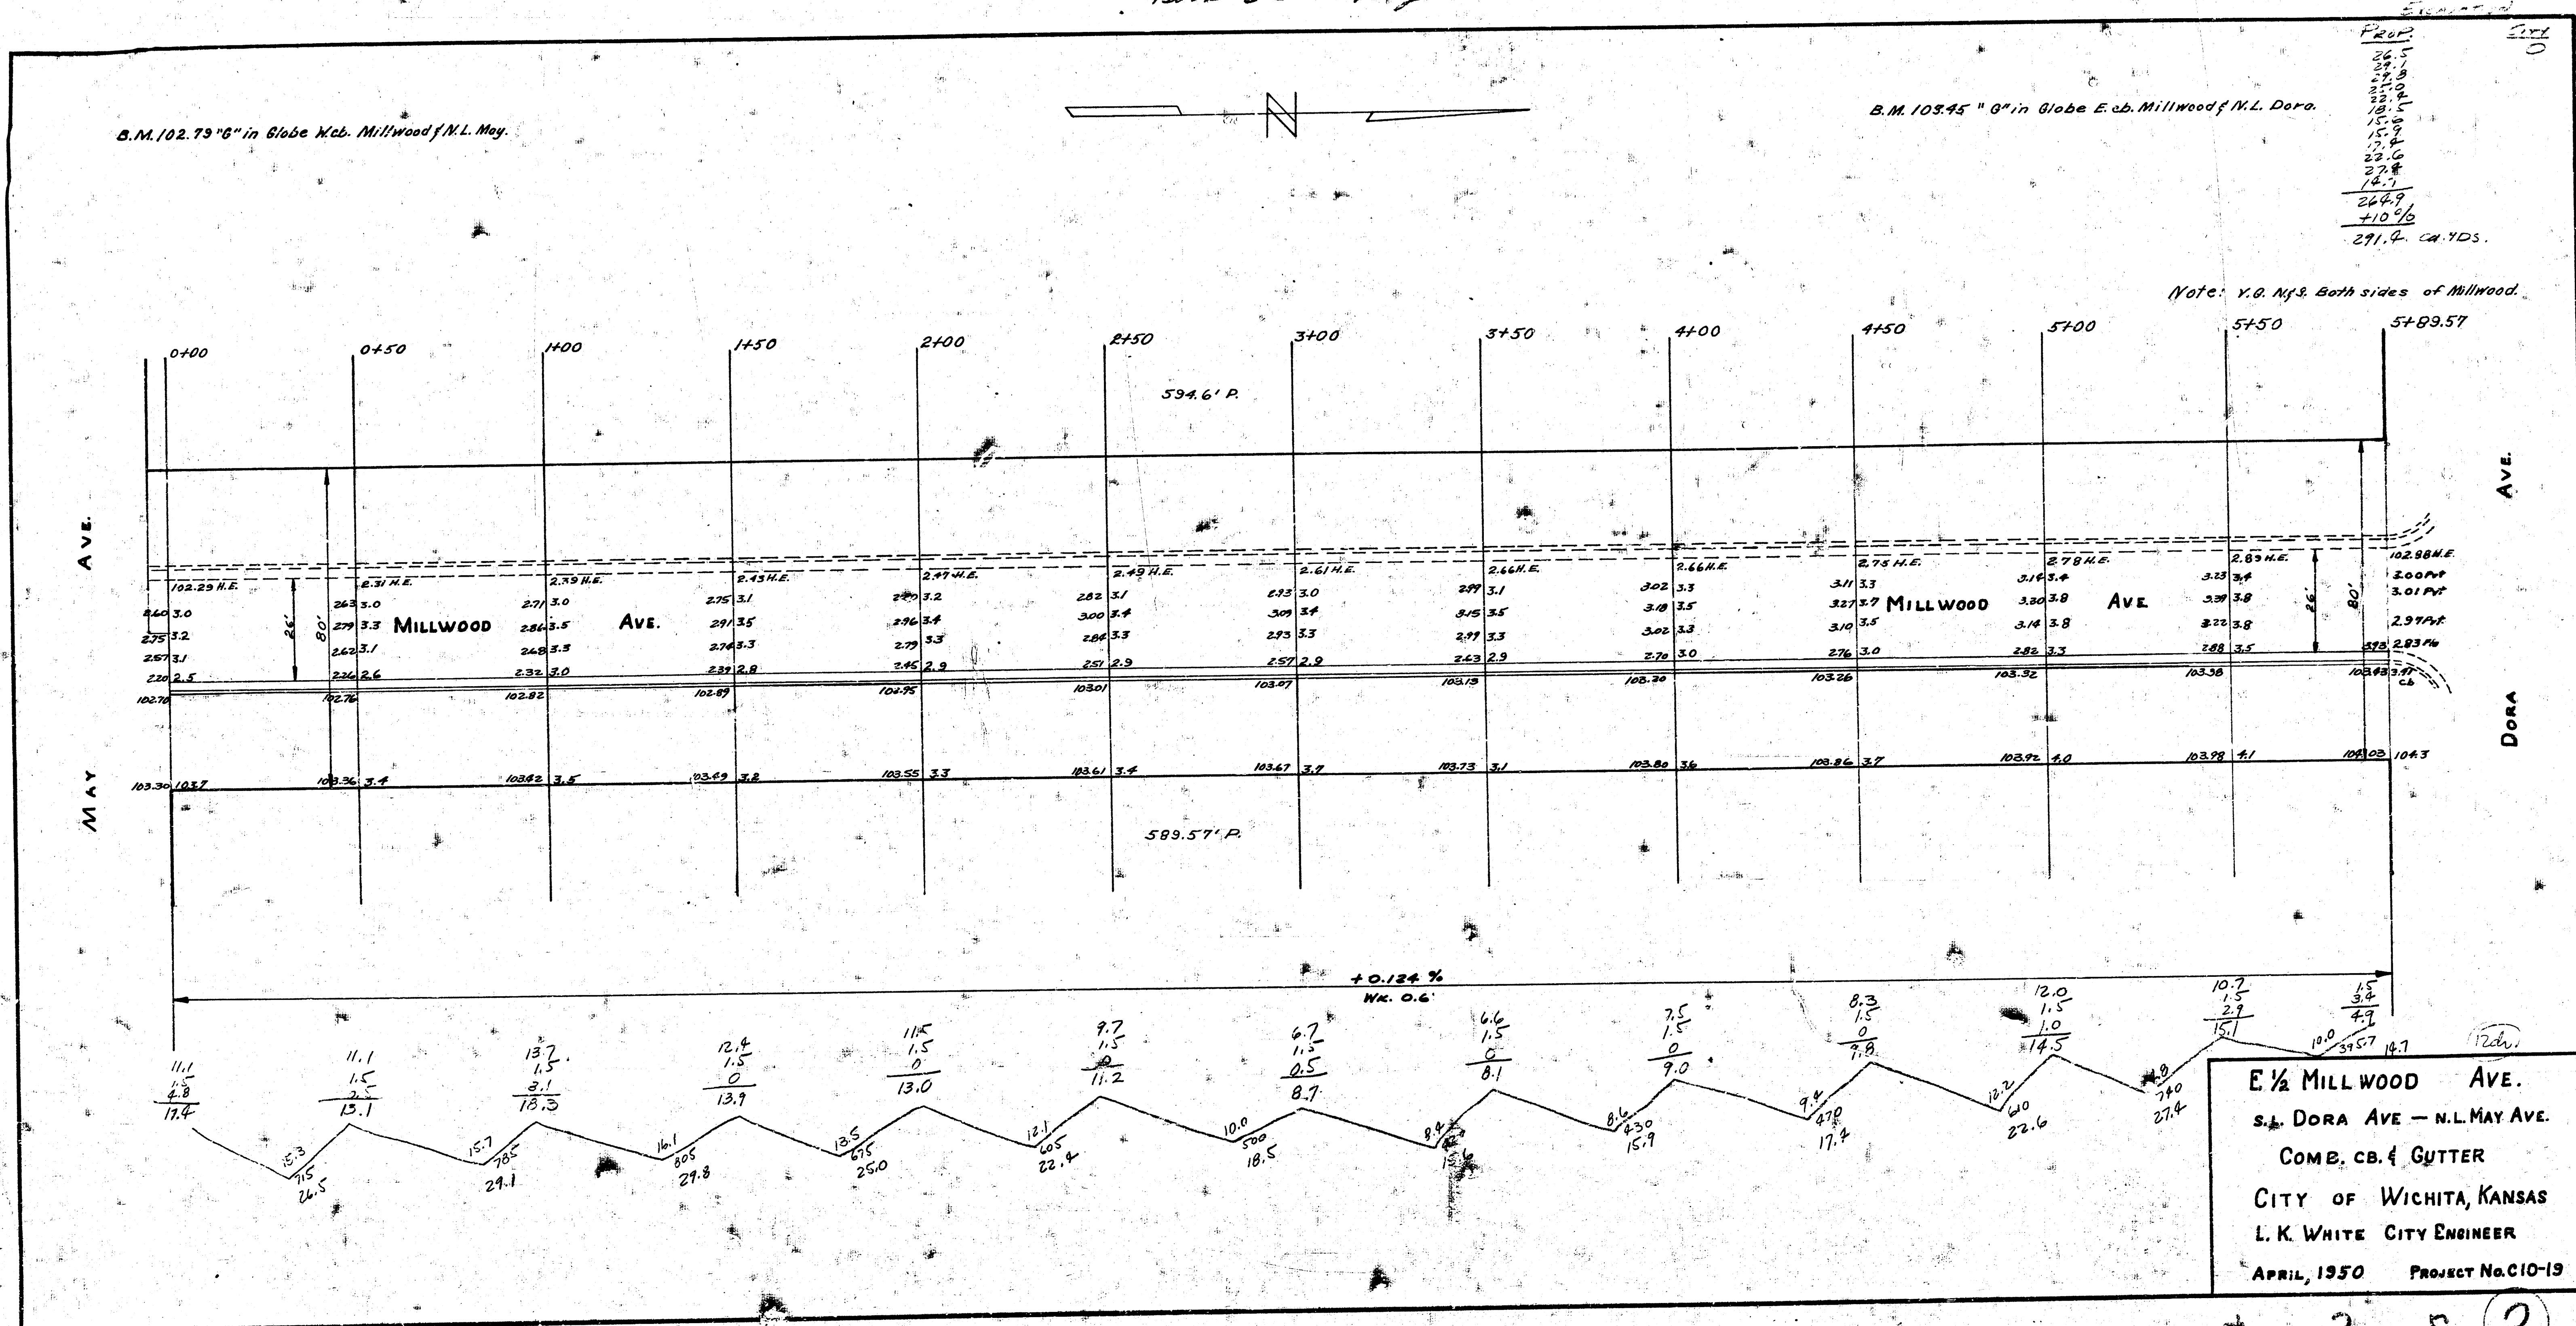

1941
 W.S. MILLWOOD AVE - N.L. MAY TO SL DORA
~~MILLWOOD AVE - SL DORA TO SL ESTHER~~
 CB + GTR ONLY

