




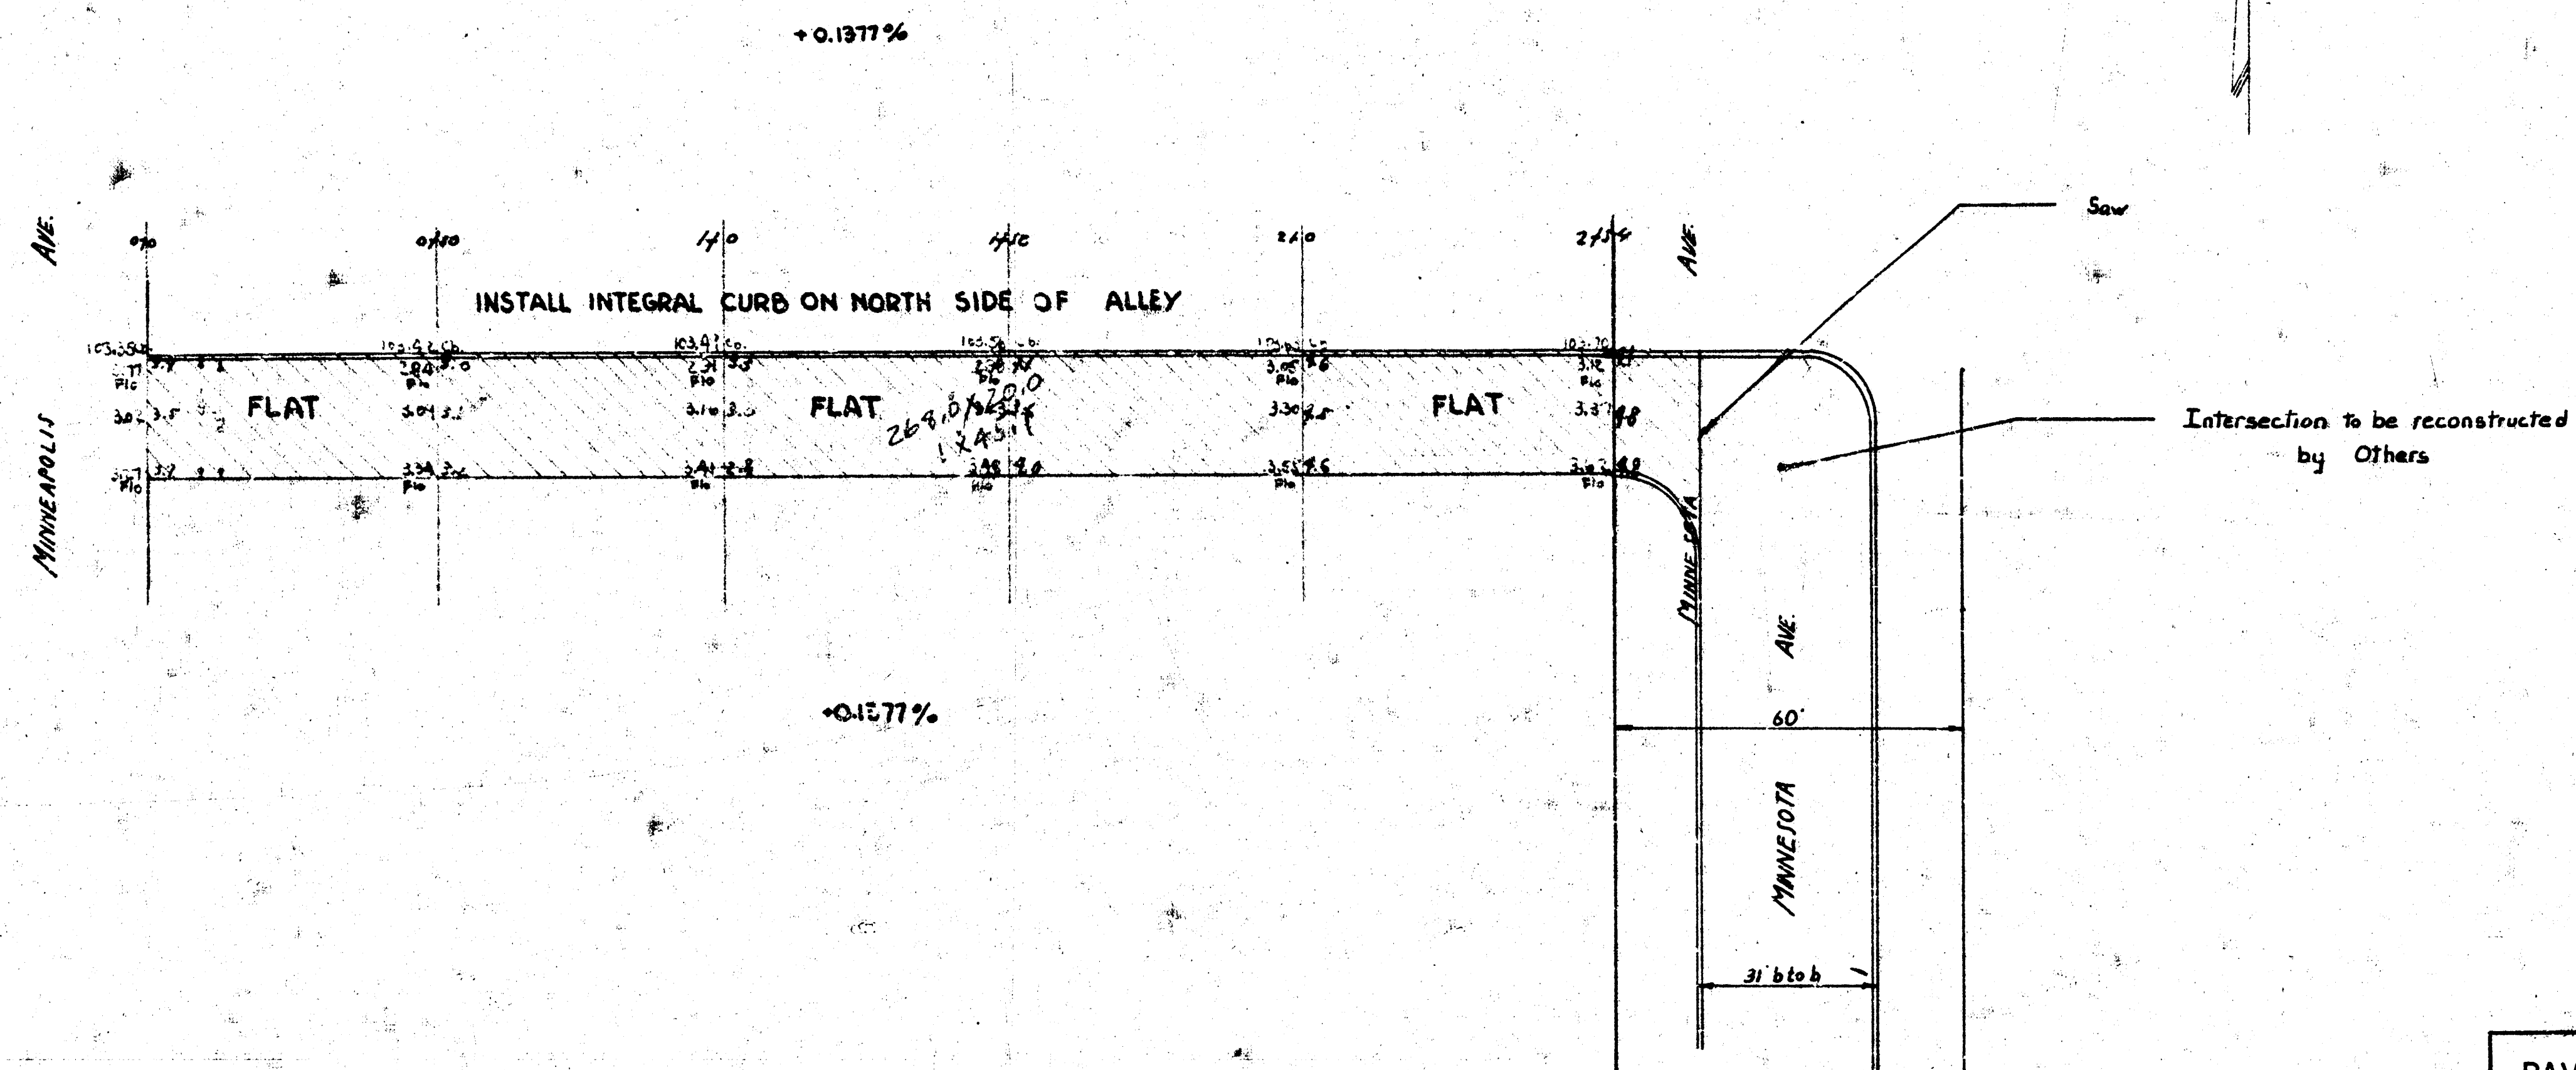


PAVEMENT REMOVAL
 Minneapolis Ave. from N.L. Morris
 to 228 ft. North of the N.L. Morris
 and Alley between Morris and
 Gilbert from E.L. Minneapolis to
 W.L. Minnesota in Connection with
 Right of Way Acquisition for I-35 W
 from Stafford to English.
 City of Wichita, Kansas
 R.W. Linn City Engineer
 Project No. DNKB 533.
 Date:

MINNEAPOLIS AVE. FROM NL MORRIS TO 228 FT. NORTH OF THE NL MORRIS AND ALLEY BETWEEN MORRIS AND GILBERT FROM EL MINNEAPOLIS TO WL MINNESOTA IN CONNECTION WITH RIGHT OF WAY ACQUISITION FOR I-35W FROM STAFFORD TO ENGLISH.

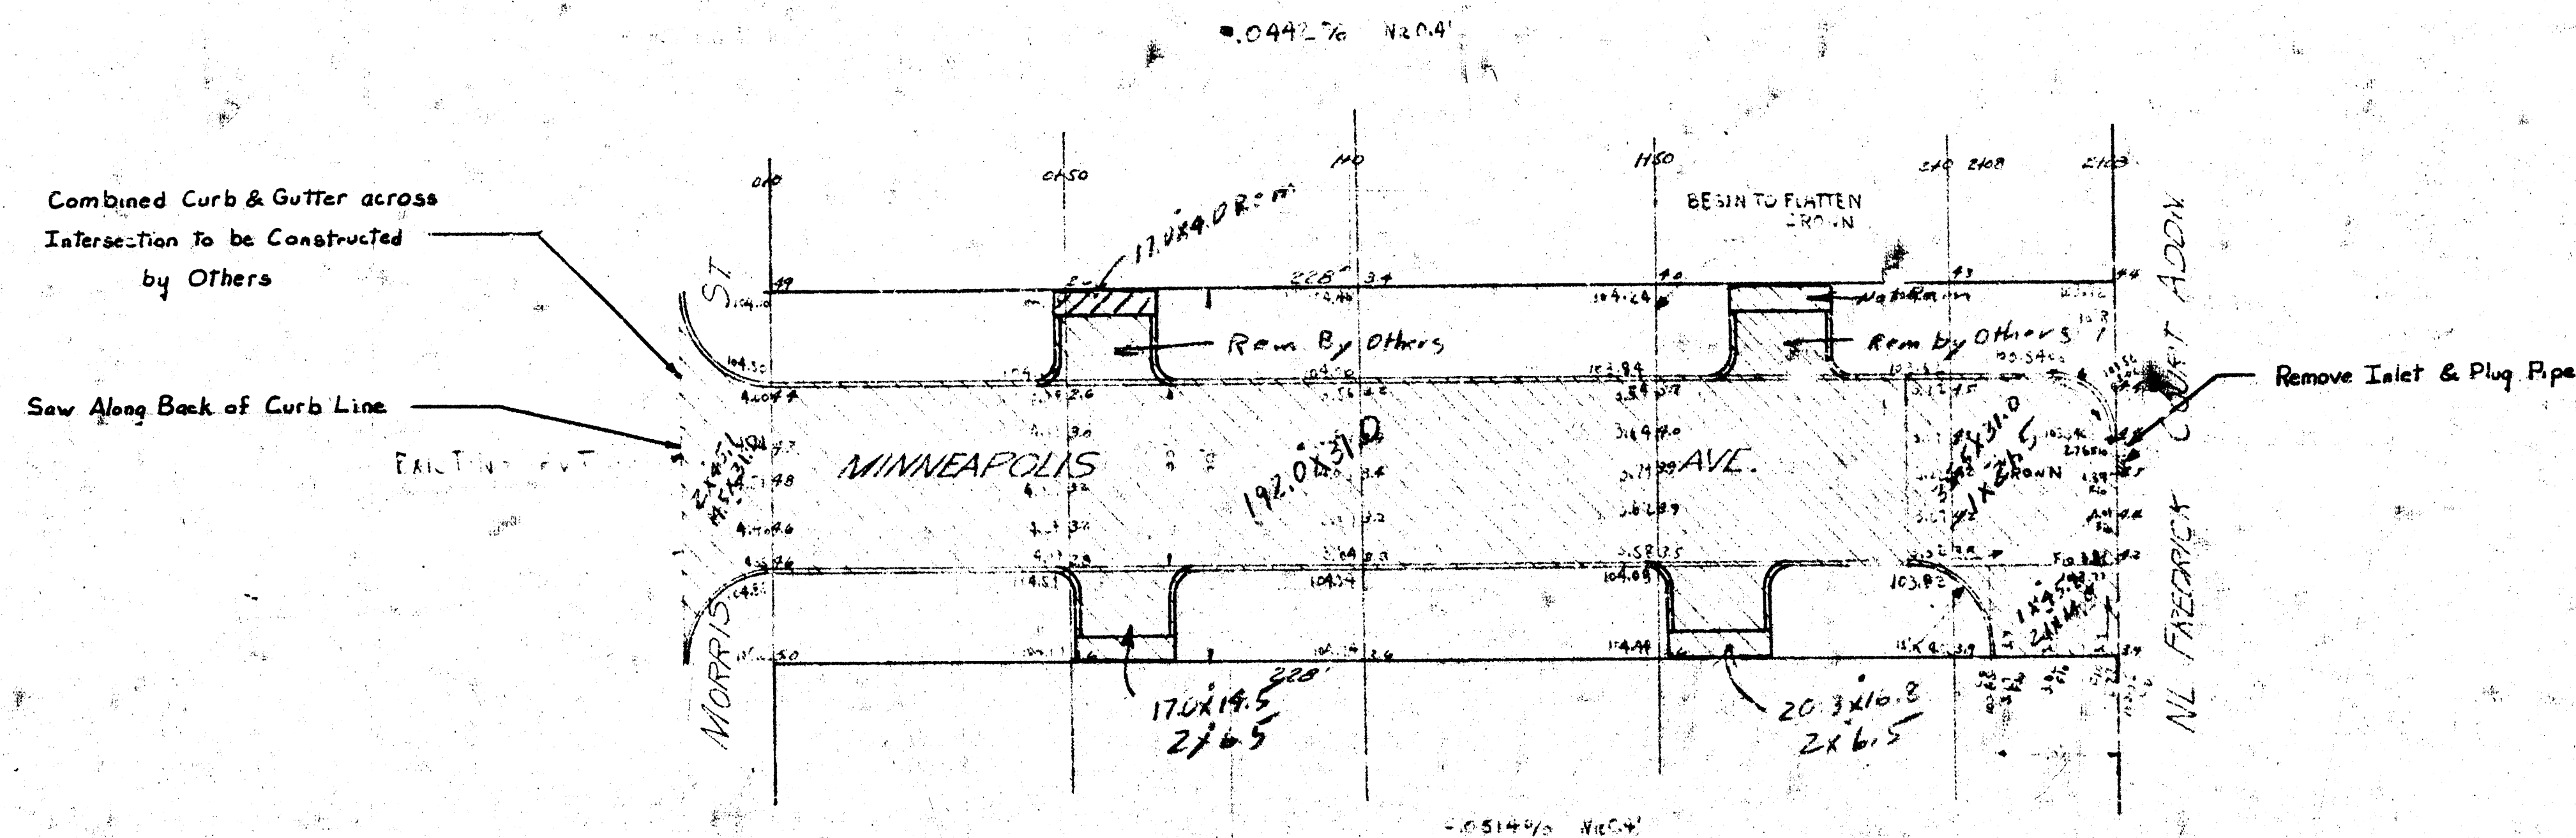

NOTE: CONTRACTOR TO OBTAIN SUITABLE BORROW EXCAVATION TO FILL VOID LEFT BY REMOVAL OF PAVEMENT AND DRIVEWAY. THE ENTIRE AREA IS TO BE LEVELLED AND GRACED TO MATCH THE ADJACENT GROUND LINE. BORROW EXCAVATION SHALL BE APPROVED BY THE ENGINEER WITH REGARDS TO SUITABILITY PRIOR TO DELIVERY TO PROJECT. LEVELLING AND GRACING THE AREA WILL NOT BE PAID FOR DIRECTLY AND SHALL BE CONSIDERED AS SUBSIDIARY TO THE GENERAL ITEMS OF WORK.

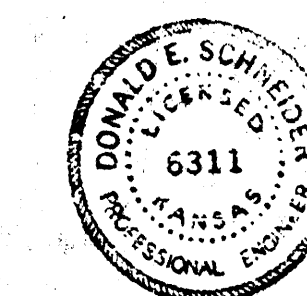

PAVEMENT REMOVAL
 Minneapolis Ave. from NL Morris to 228 ft. North of the NL Morris and Alley between Morris and Gilbert from EL Minneapolis to WL Minnesota in Connection with Right of Way Acquisition for I-35W from Stafford to English.
 City of Wichita, Kansas
 R.W. Linn City Engineer
 Project No. DNKB 533
 Date: Mar 1974