



MINNEAPOLIS
S.L. NORTHERN TO N.L. INDUSTRIAL

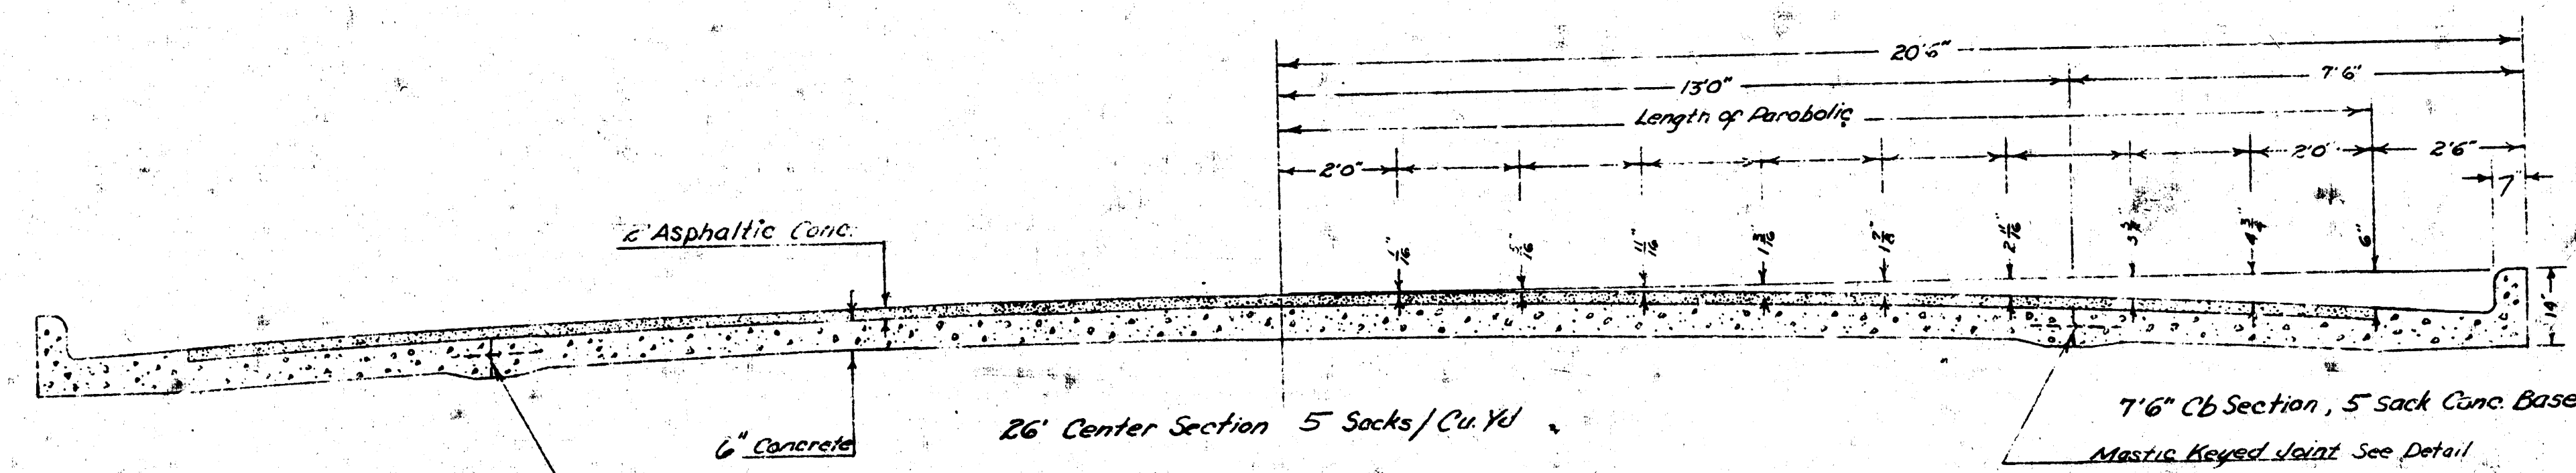


TYPICAL SECTION

Scale $\frac{1}{2}" = 1'$

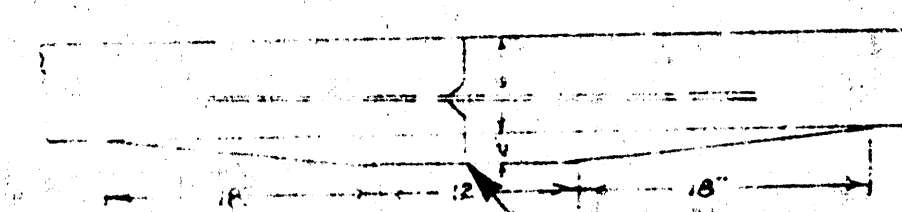


Detail of Keyed Joint
NO SCALE
JOINT WAS NOT THICKENED

USED 4" DOWELS

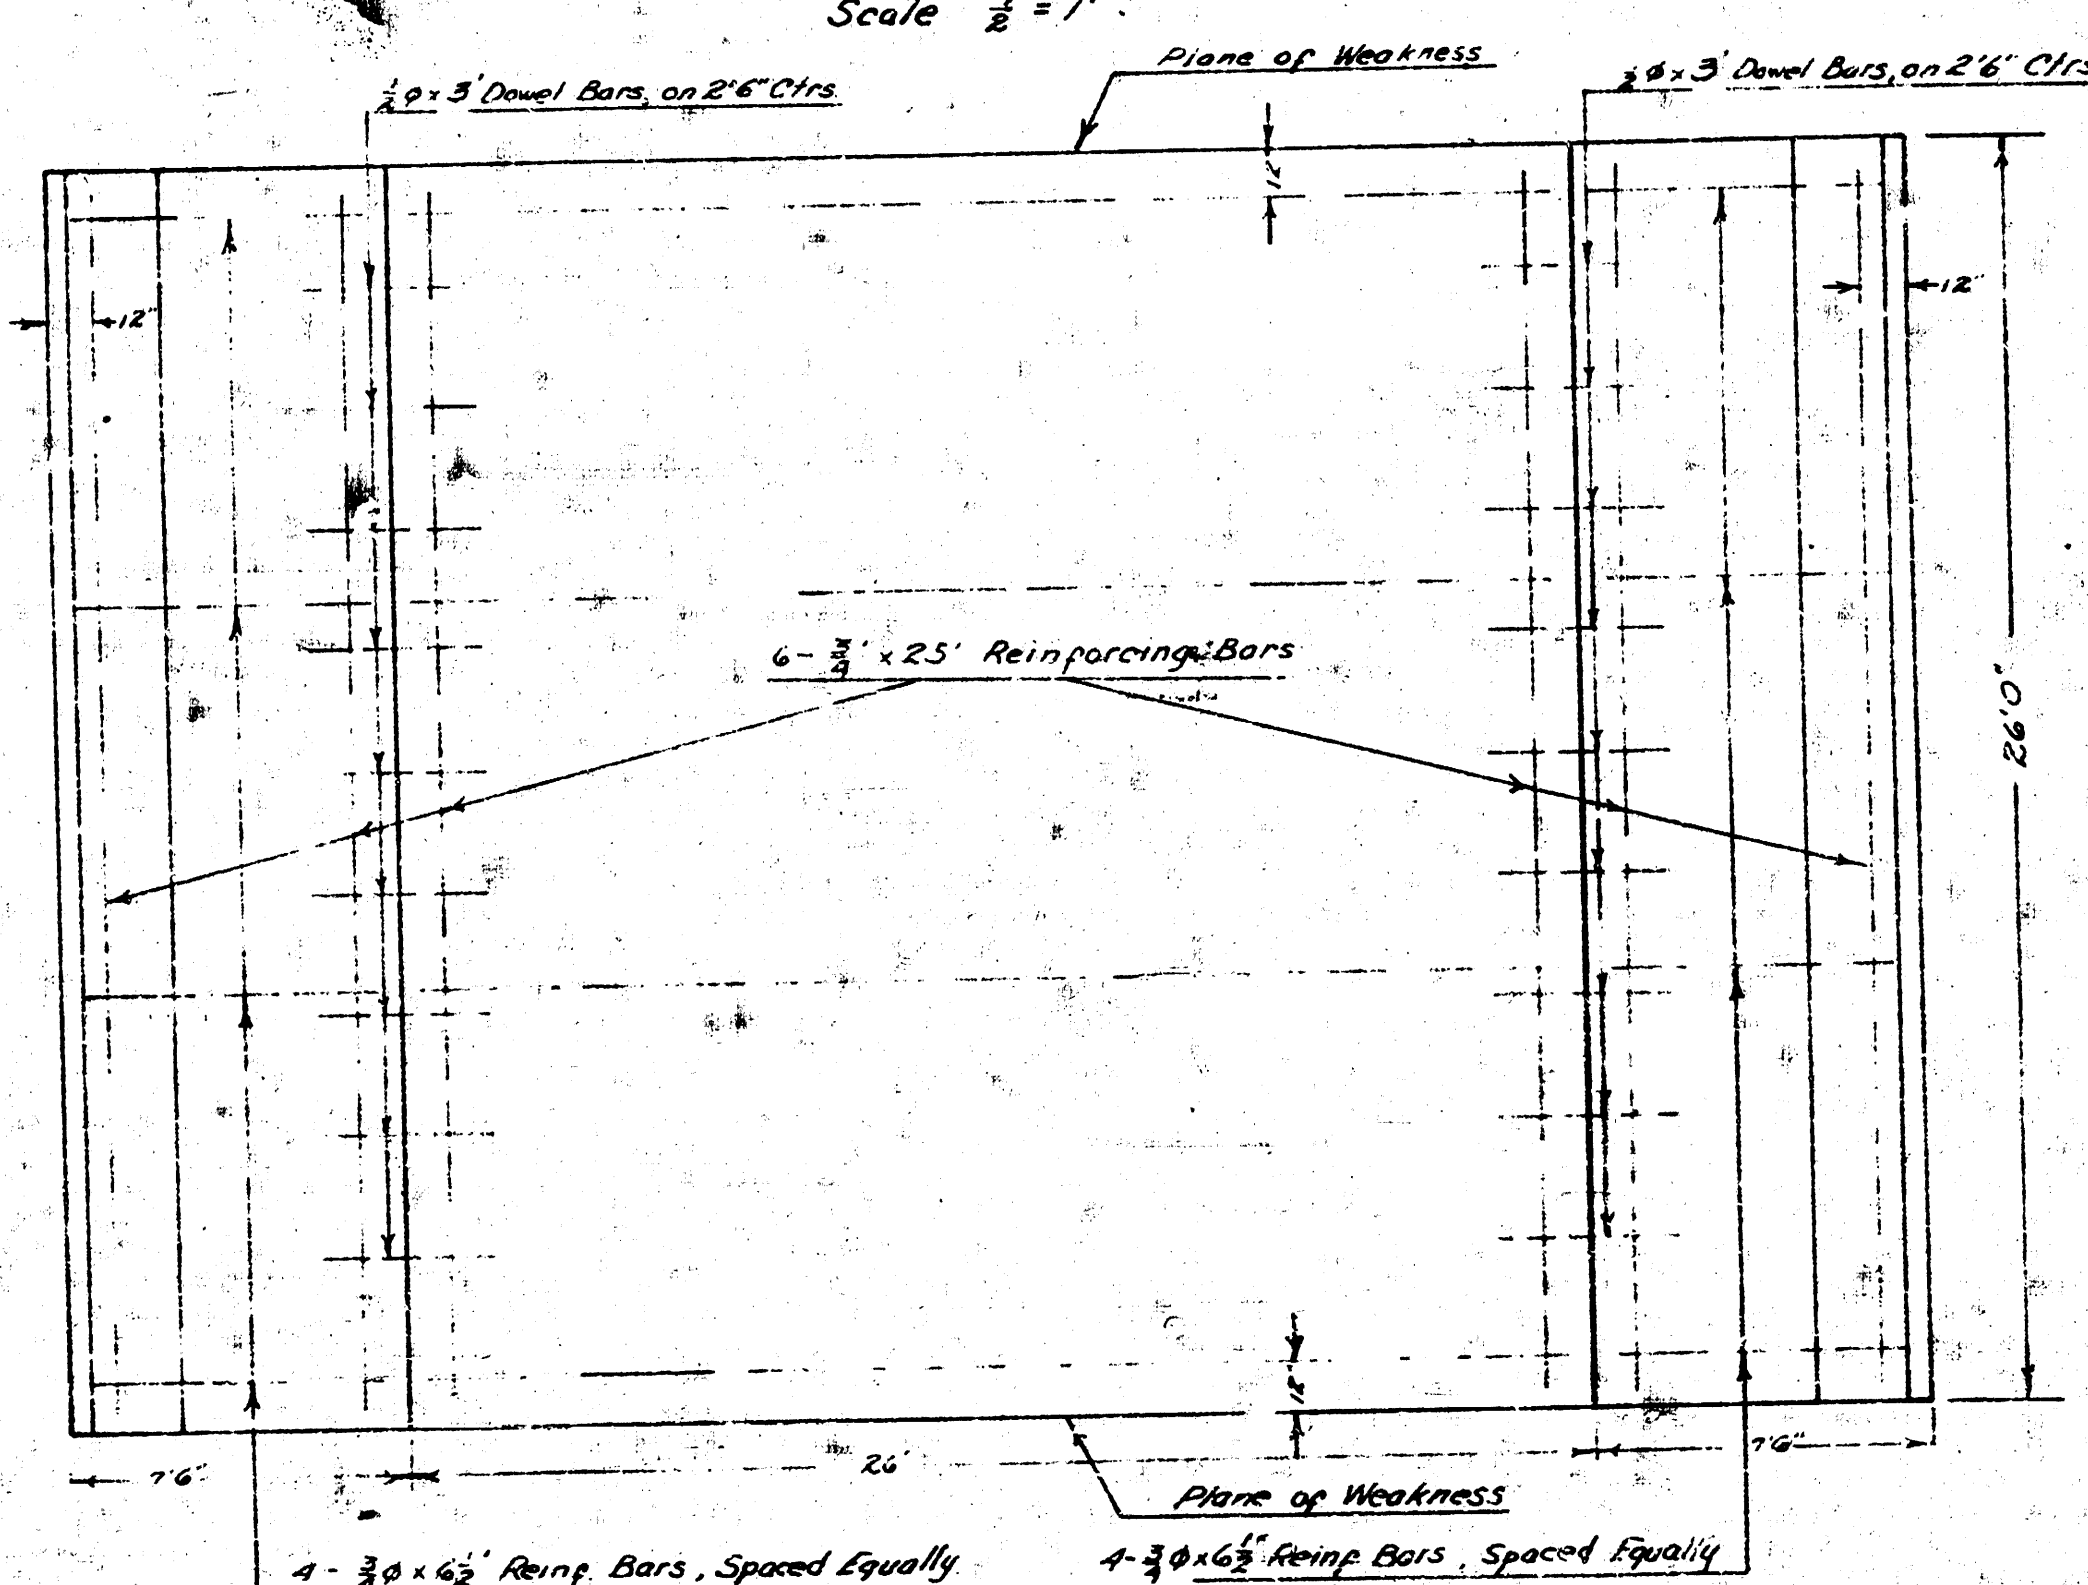



STEEL PATTERN

Scale $\frac{1}{4}" = 1'$

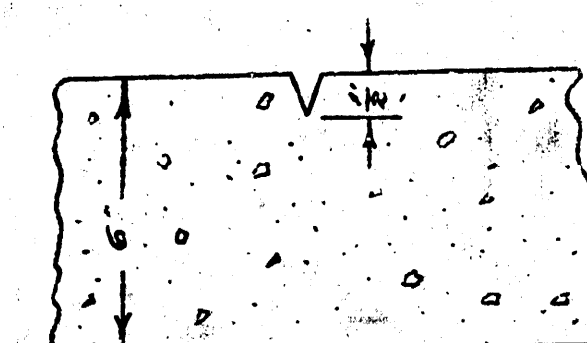

Detail Plane of Weakness
Plane of Weakness to be Cut with
Double-Ridge Groover to Depth as
Shown in a Straight Line from
Curb to Curb 26' Ctr. to Ctr.

5-12

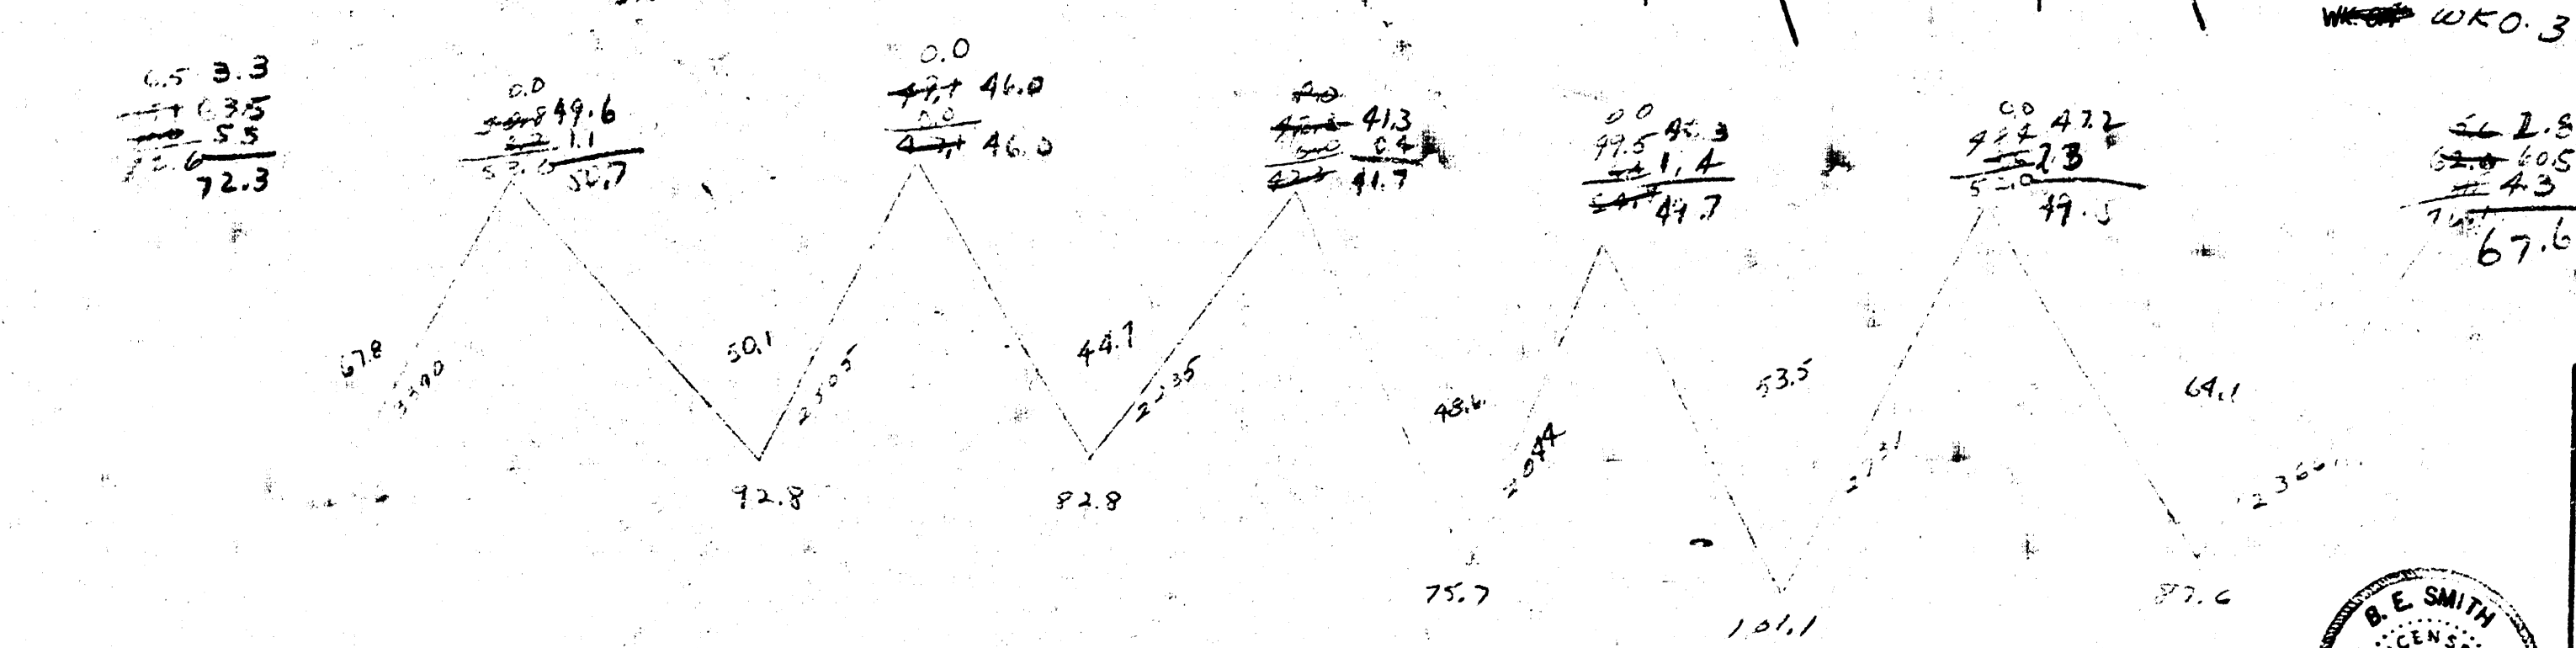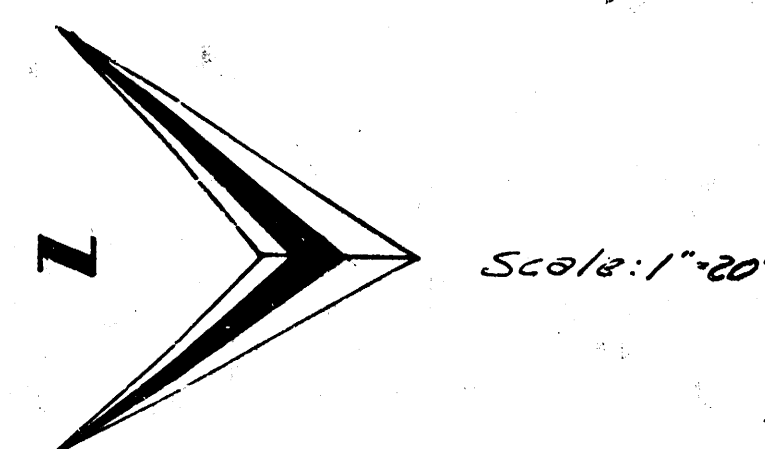

MINNEAPOLIS
S.L. NORTHERN TO NL INDUSTRIAL
36-2-40 A.C.
6 BASE
CITY OF WICHITA, KANSAS
L. K. WHITE CITY ENGINEER
AUGUST 1952 PLAN NO. C12-110

