
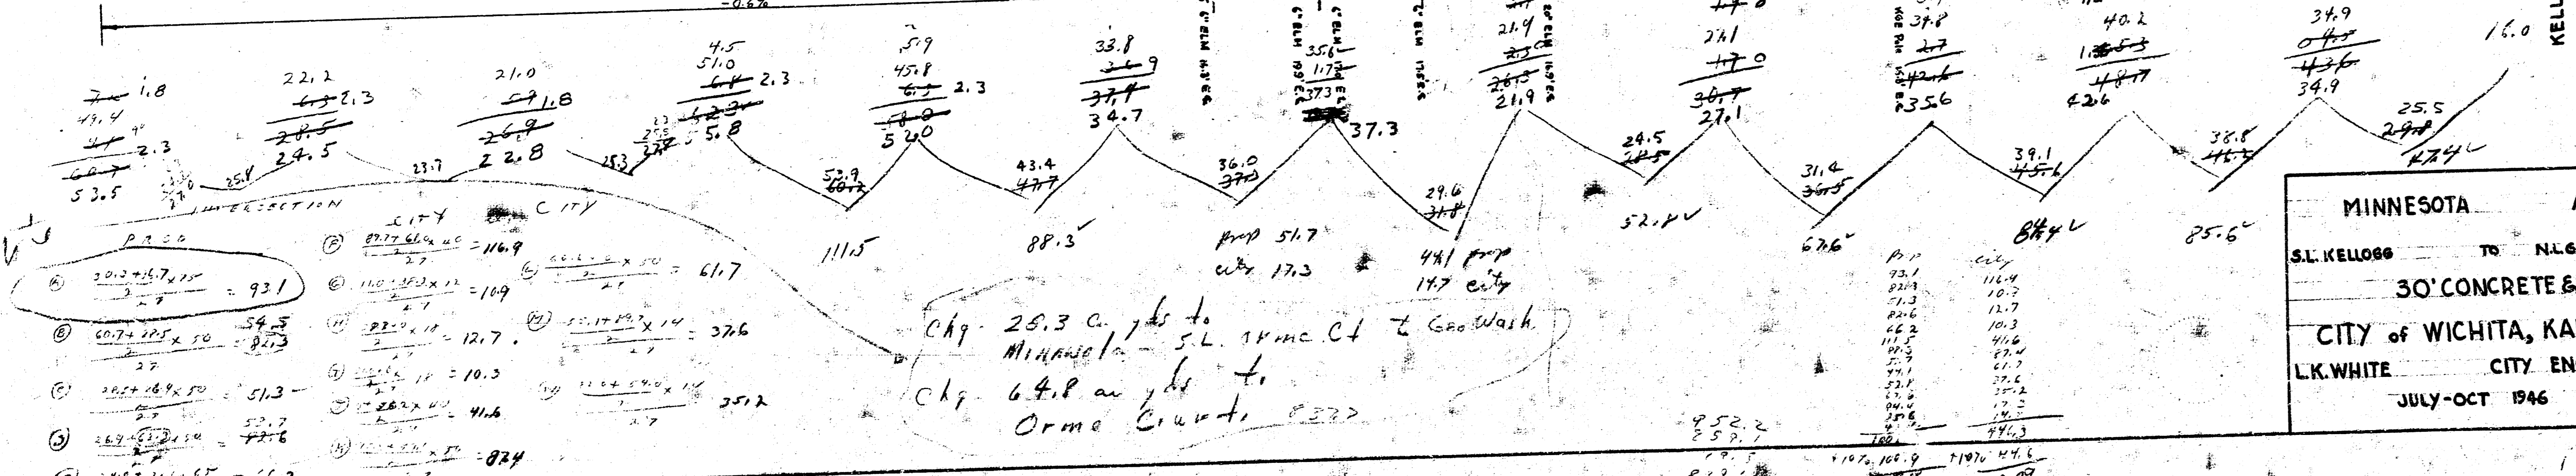



B.M. 108.23 N.E. Cor. Lower Step How 2001 Indianapolis & Orme Court

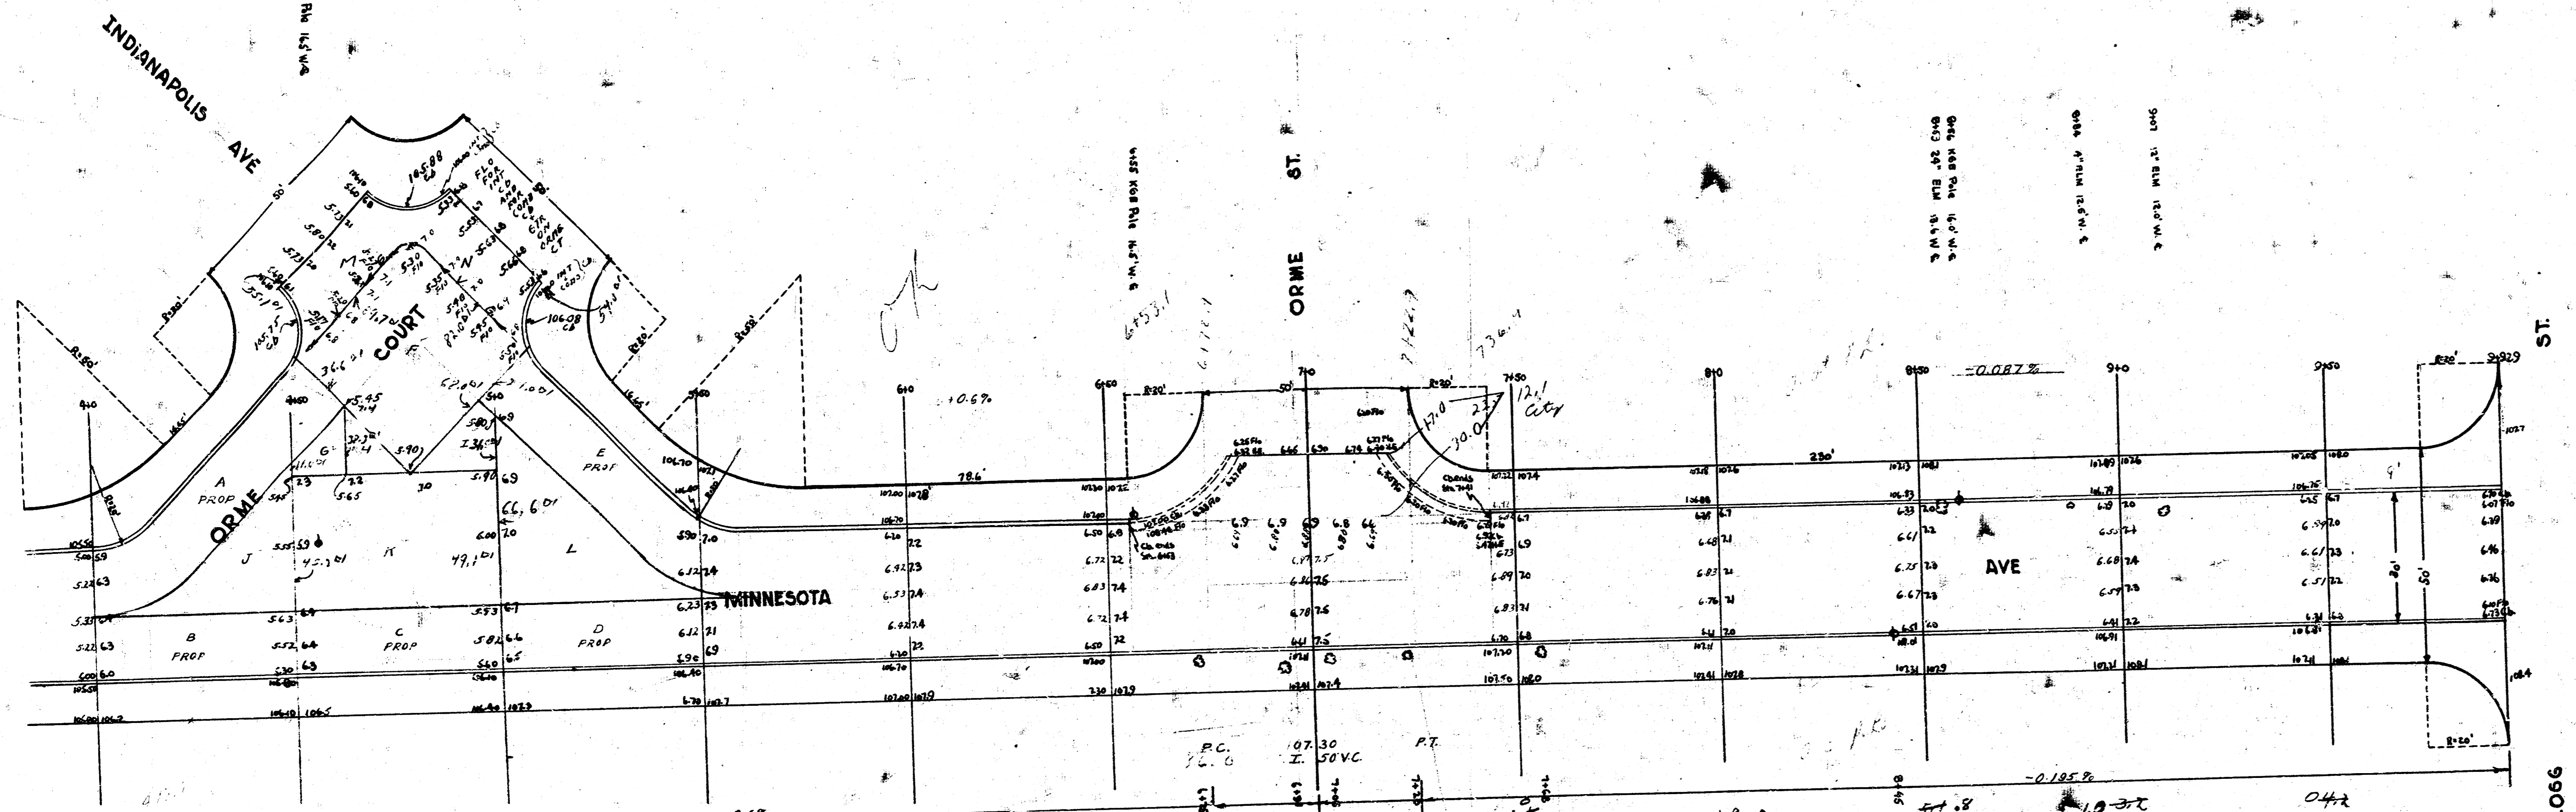

- ① $\frac{20.3 \times 57.11}{3} = 93.1$
 ② $\frac{60.7 \times 25 \times 50}{27} = 54.5$
 ③ $\frac{20.5 \times 69 \times 50}{27} = 51.3$

Chg. 25.3 c. to
 Minnesota - S.L. 1000 Ct & Geo Wash.
 Chg. 6.4.8 a. to
 Orme Court. P. 222

MINNESOTA AVE	
S.L. KELLOGG	TO N.L. GEO. WASHINGTON
30' CONCRETE & C.B.	
CITY OF WICHITA, KANSAS	
L.K. WHITE	CITY ENGINEER
JULY-OCT 1946	

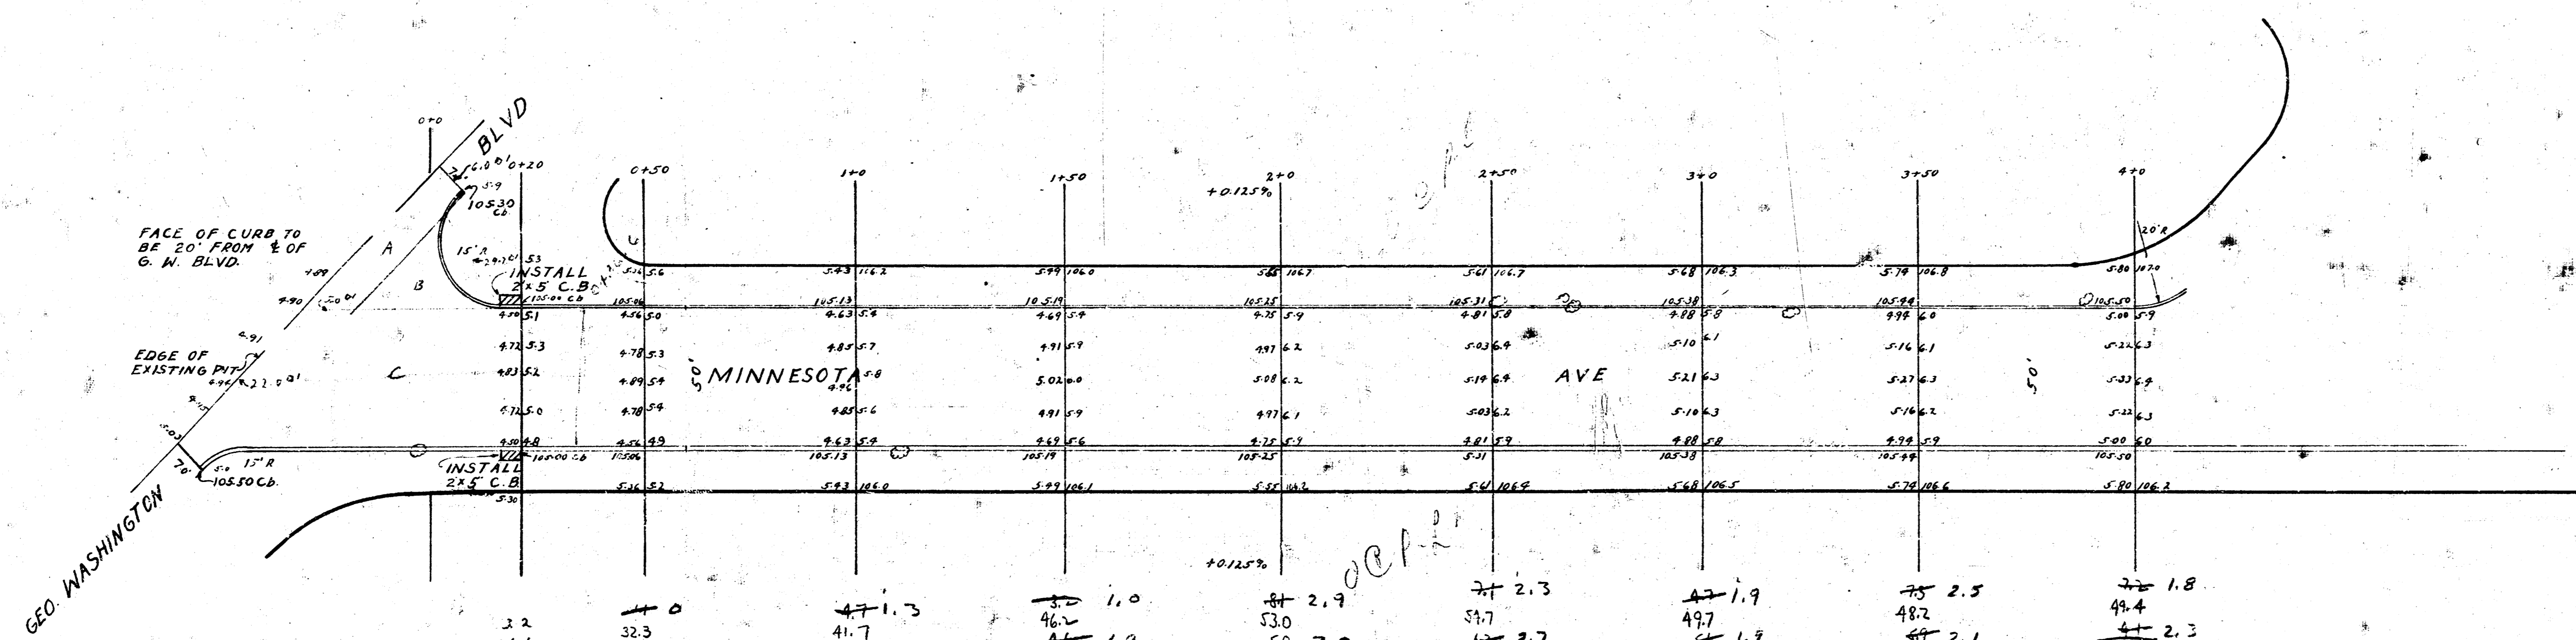


City

Pump
 36.9
 77.4
 96.5
 115.0
 115.0
 118.5
 118.4
 113.1
 751.8
 + 1000 (1000)
 1751.8
 871.0 C. J.

Totals
 Pump
 871.0
 1109.8
 1980.8
 City
 90.9
 490.9
 581.8

992.7

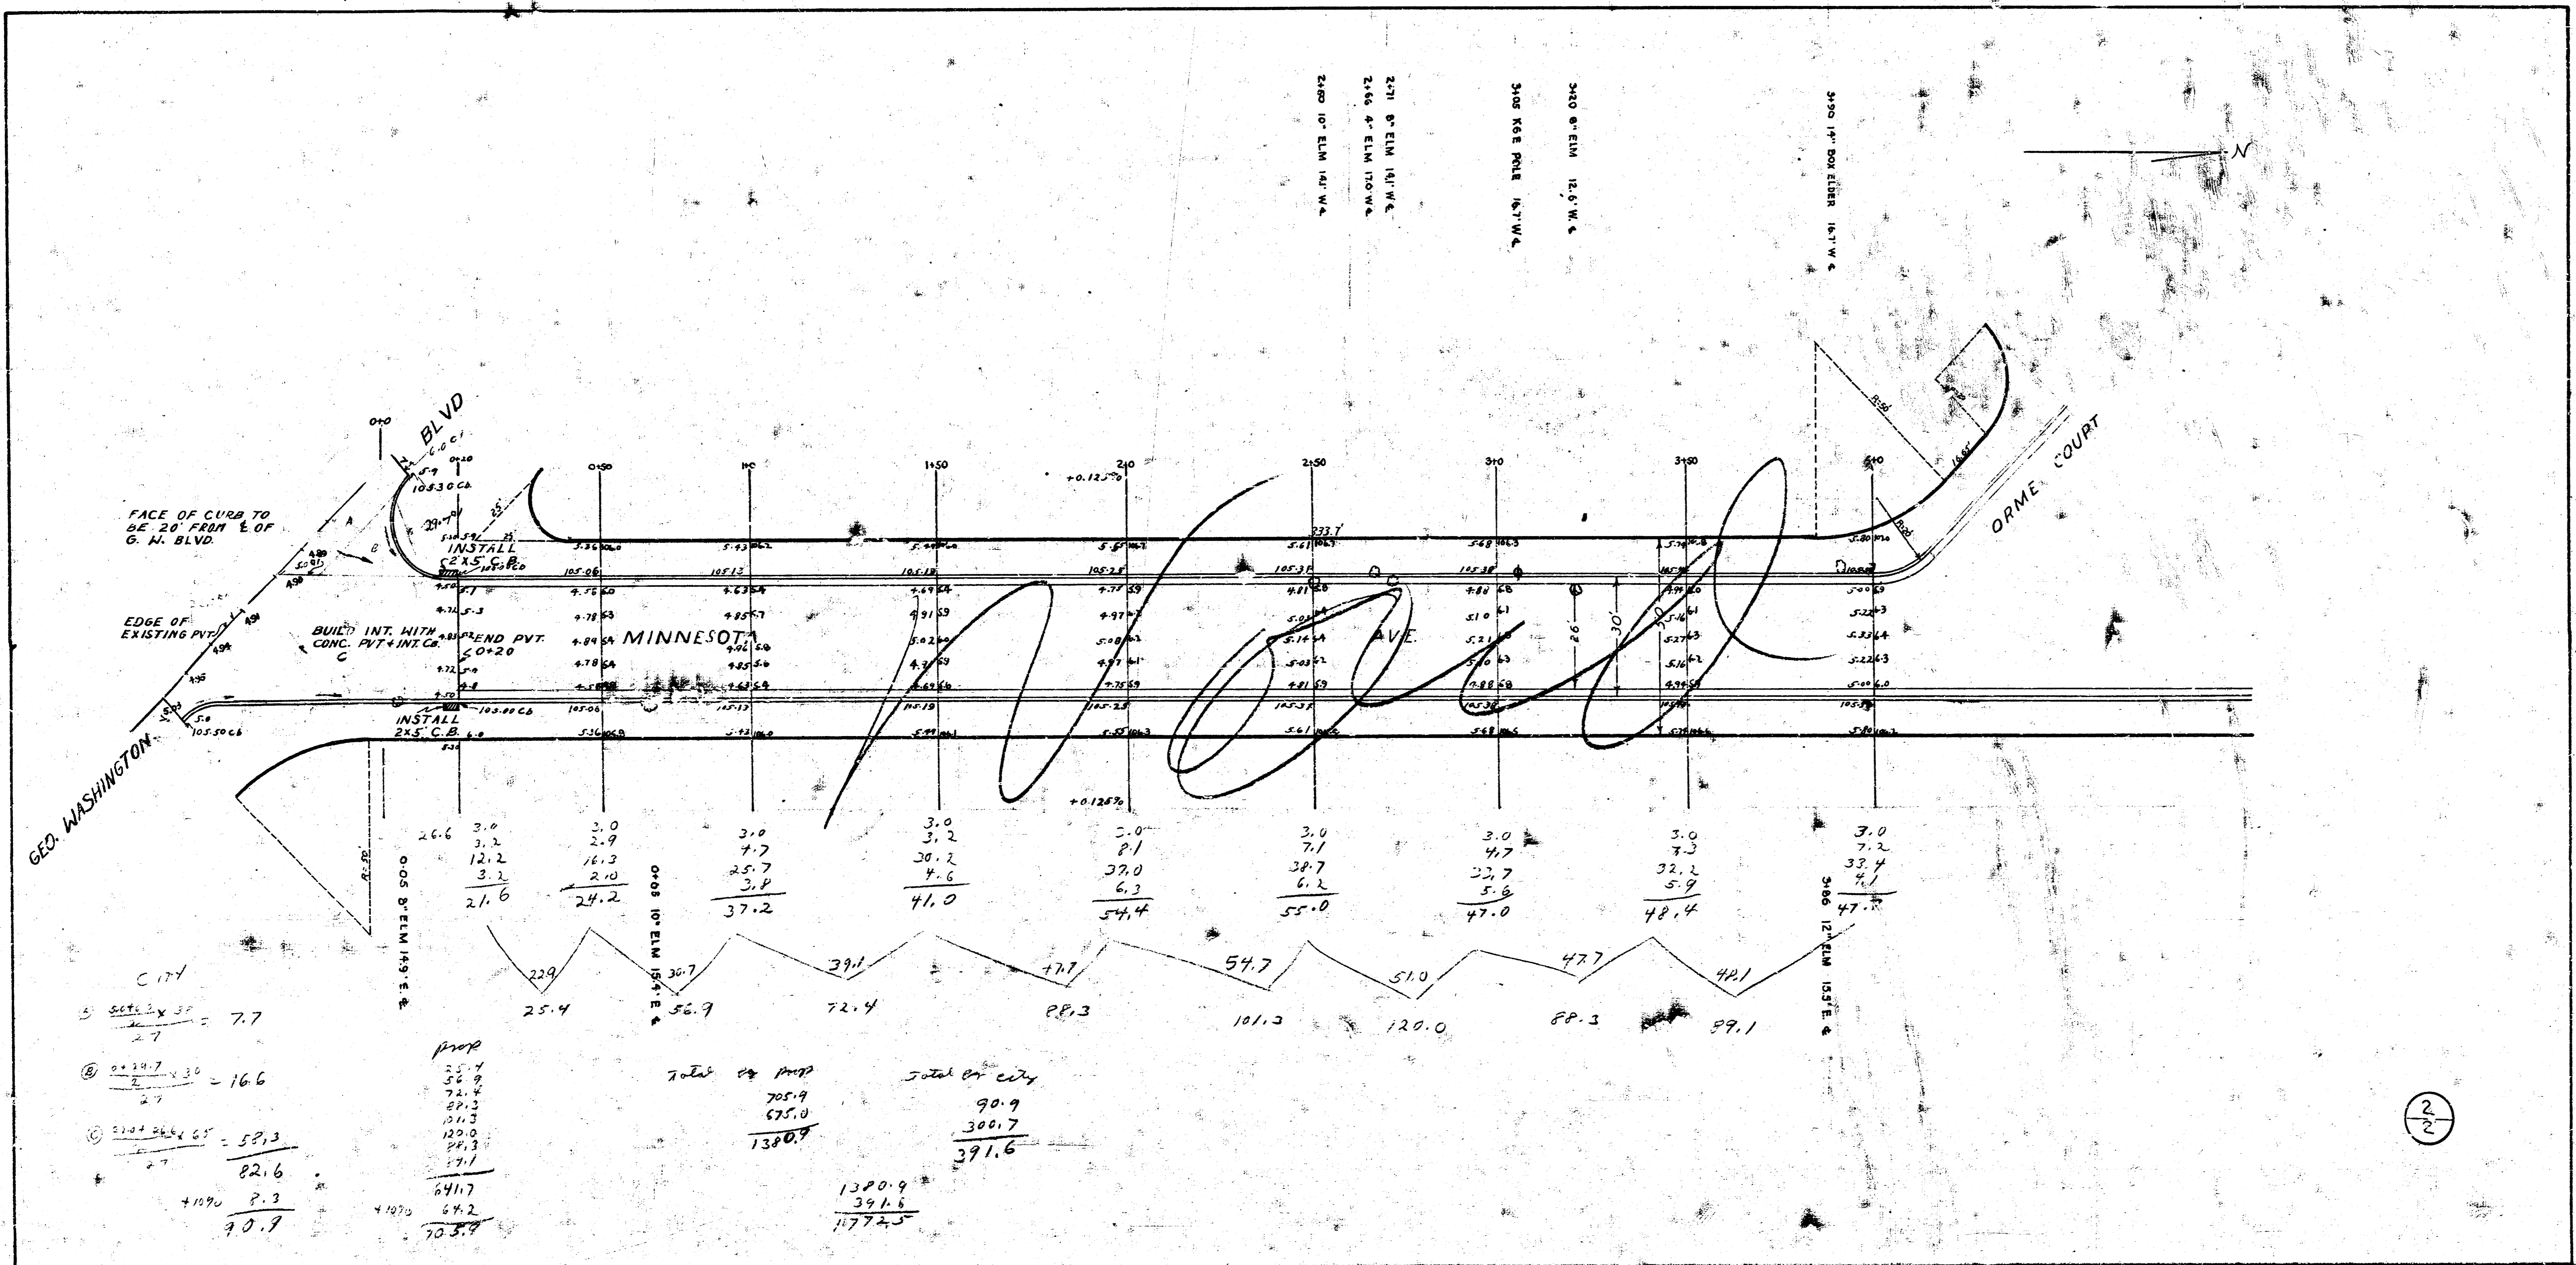

Total of Prop											
Total of City											

CITY
