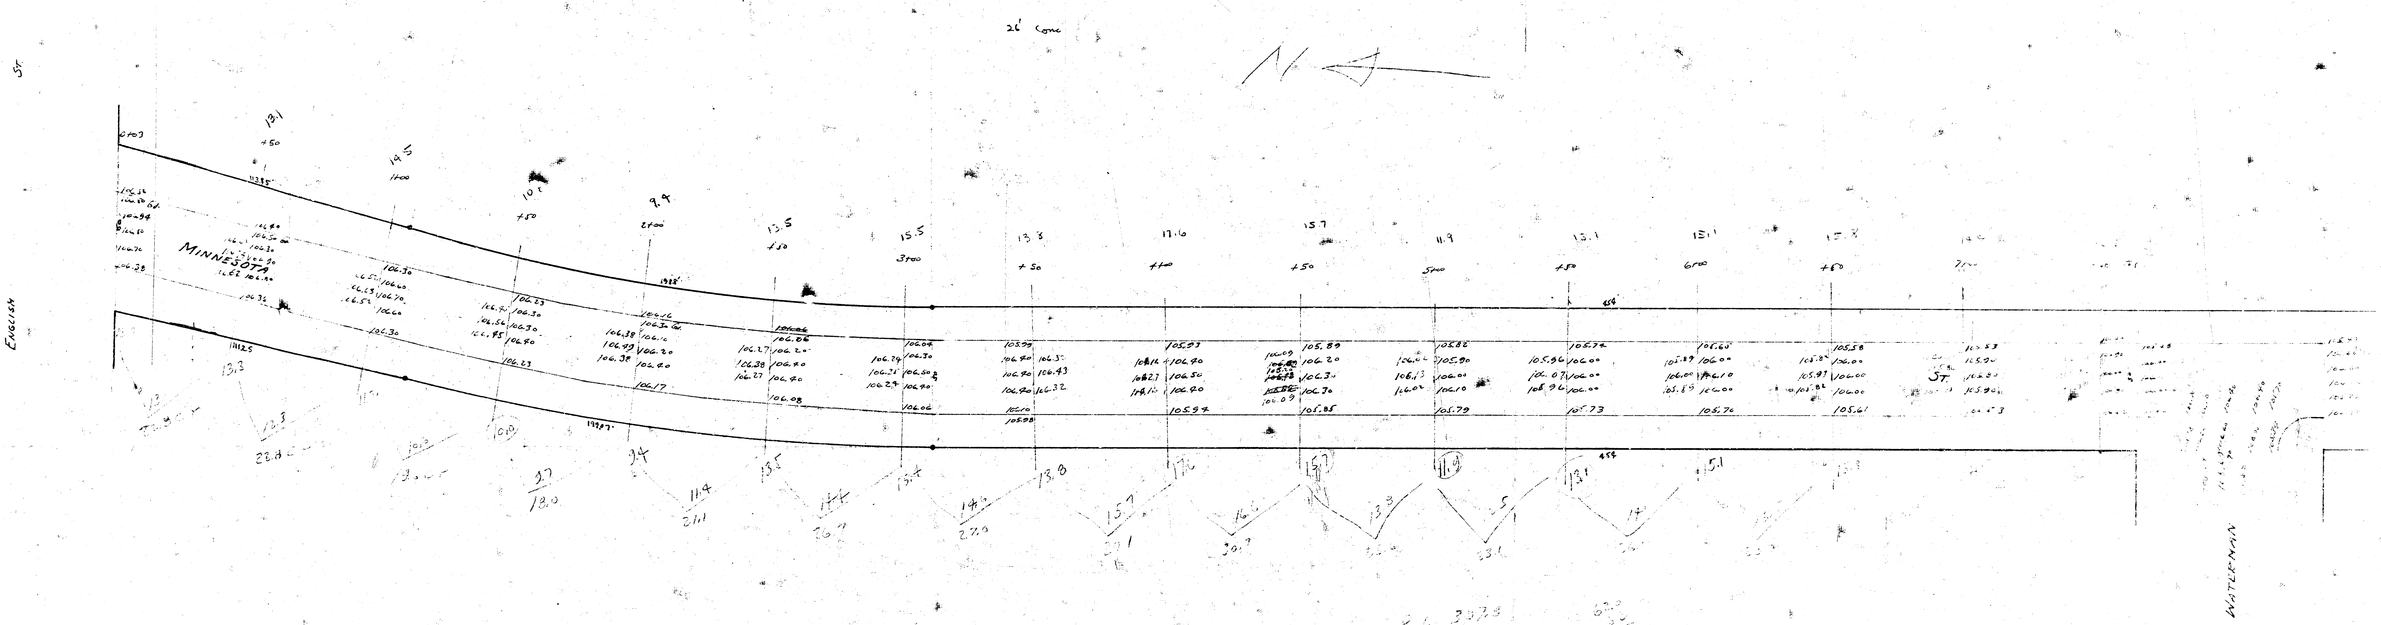Minnesota- S.L. English to S.L. Waterman.