



FEIN PROFILE

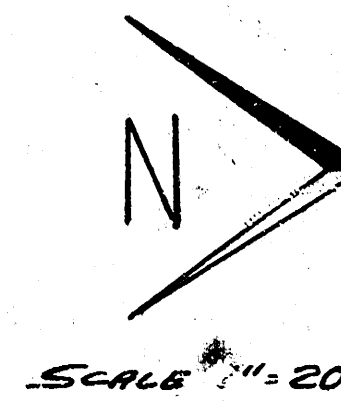

PROJECT
 50.7
 40.1
 30.1
 20.1
 10.1
 0.1
 485.7 CUTS ETC.
 +10.1
 534.2

D.M. 188.59 STANDARD SEC. 25TH & 26TH


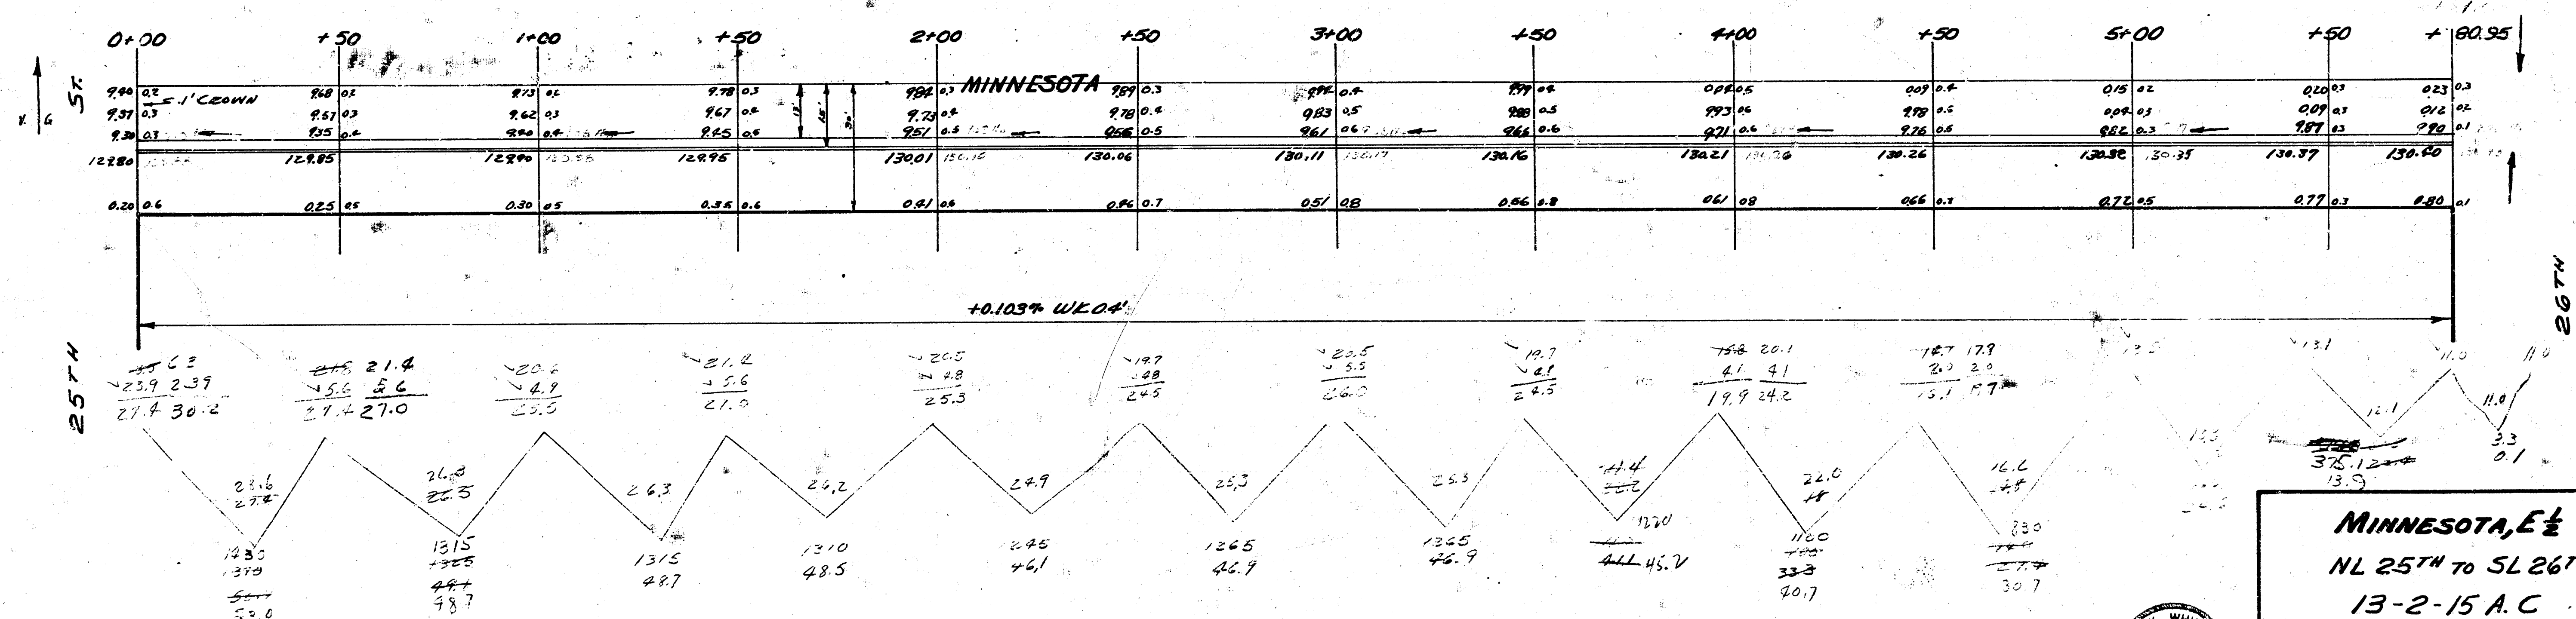

MINNESOTA, E 1/2
 NL 25TH TO SL 26TH
 13-2-15 A.C.
 CITY OF WICHITA KANSAS
 L.E. WHITE CITY ENGINEER
 JUNE 13, 1952 PROJ. NO. C11-344

