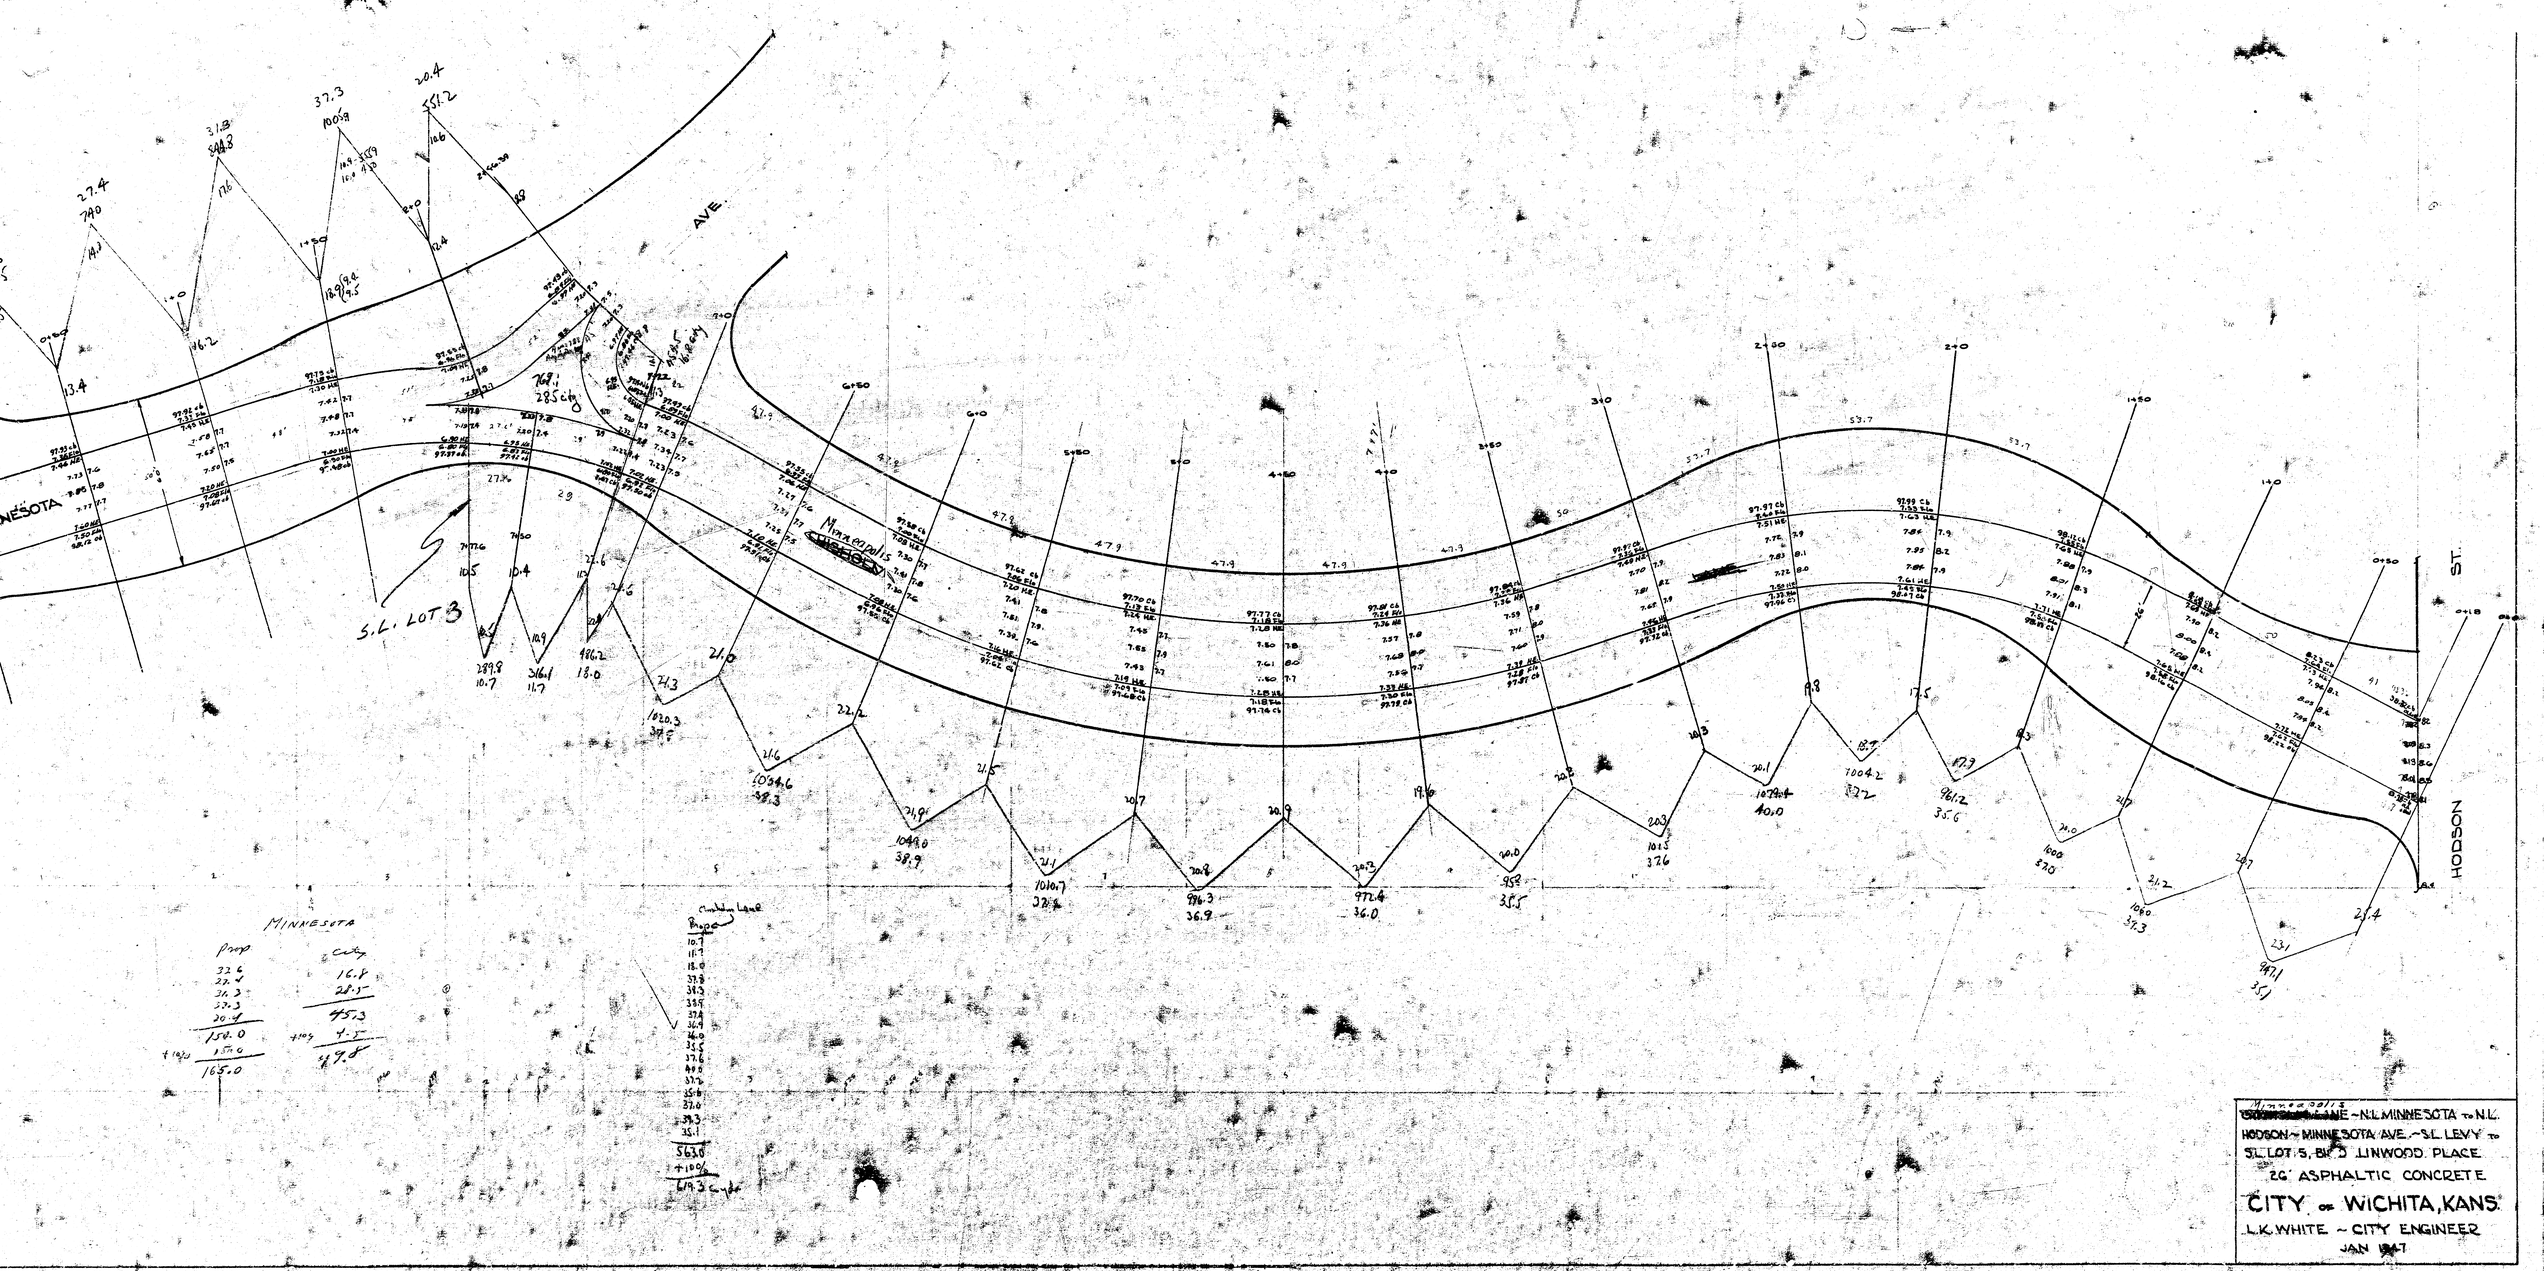
AVE.
MINNESOTA
Minneapolis
HODSON
ST.
S.L. LOT 3
Pump
City
Curbing Load
Pump
City
MINNESOTA ~ N.L. MINNESOTA to N.L.
HODSON ~ MINNESOTA AVE. ~ S.L. LEVY to
S.L. LOT 5, BLK 3 LINWOOD PLACE.
26' ASPHALTIC CONCRETE
CITY OF WICHITA, KANS.
L.K. WHITE ~ CITY ENGINEER
JAN 1947