
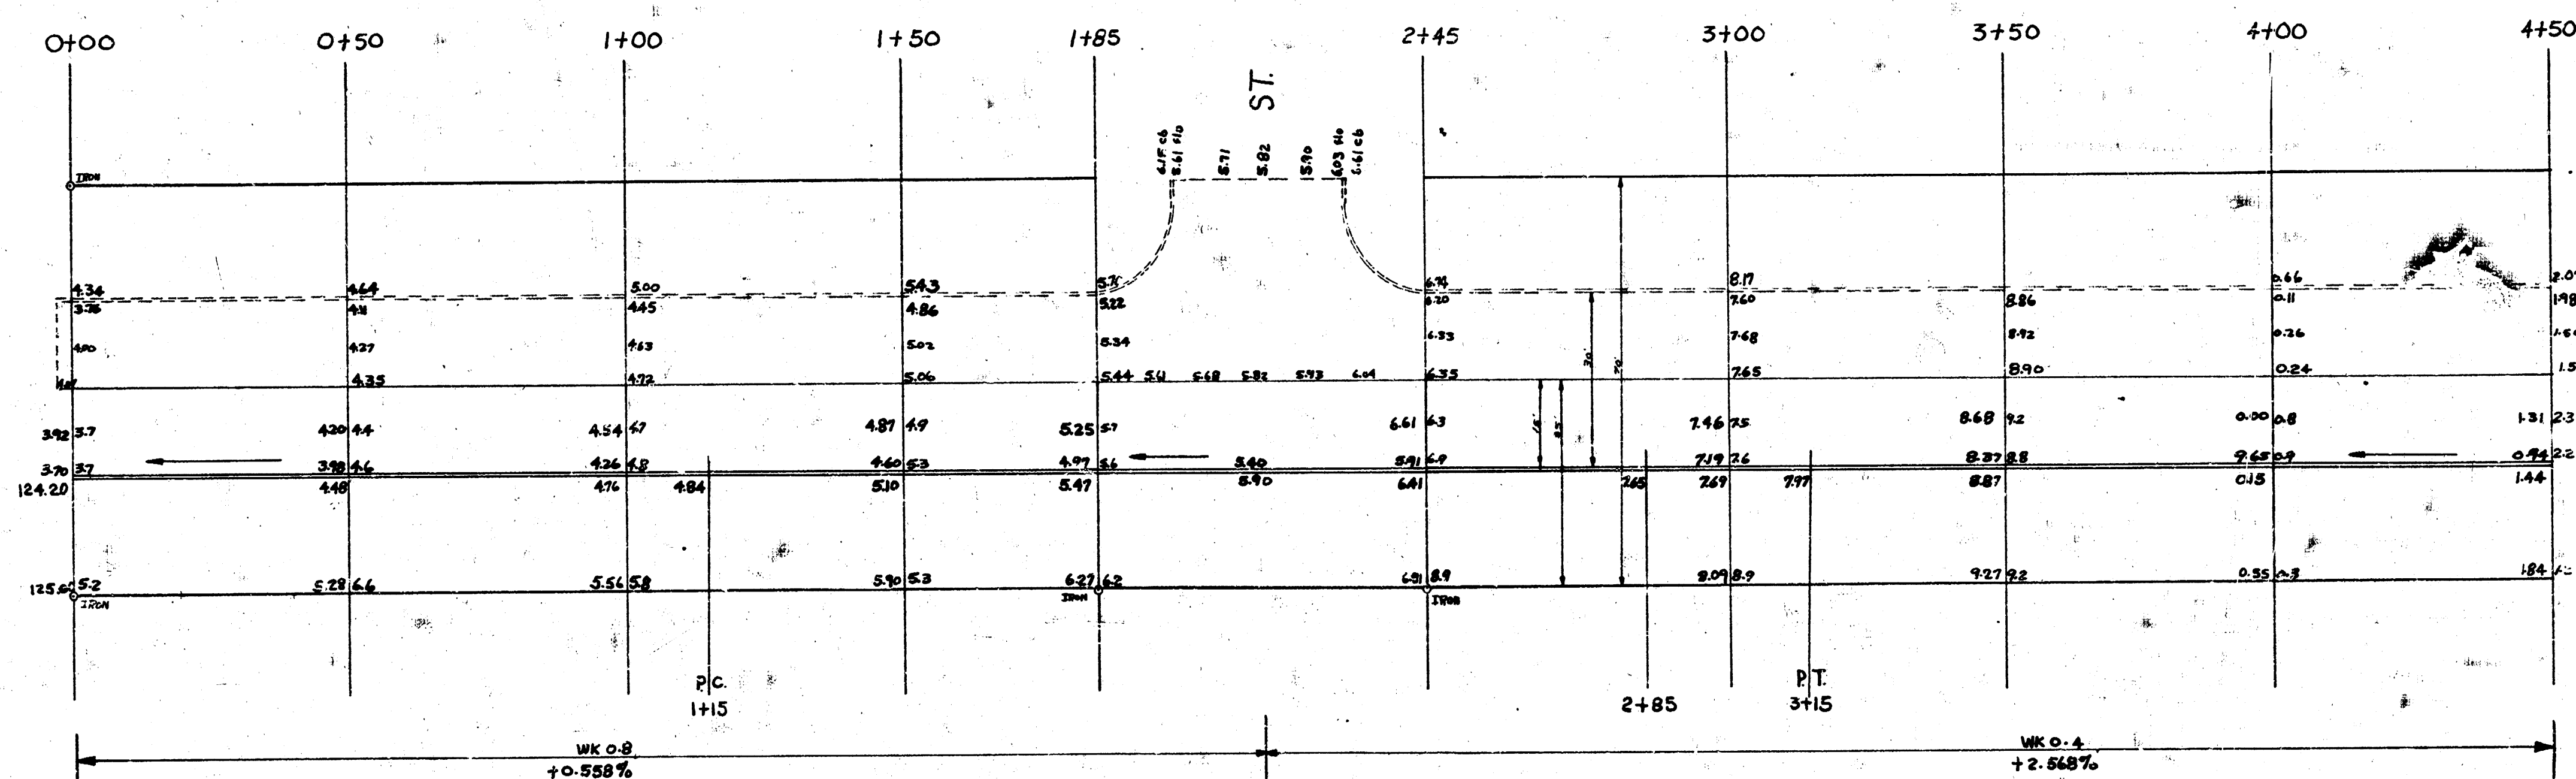


BM. 124.34 "G" in Globe W carb S and part on Mission Rd. at sta 0+00
 B.M. 129.55 E. Rim M.H. on W.I.S. E.S. Woodlawn Approx. 200' SE. of SW.
 Cor Funston & Woodlawn.
 Sta on E R - S. to N.

O-235 Beg. end on W.S.
 0+00 Bay Lincoln Hills 3rd Add.


1+85 S.L. Funston

2+45 N.L. Funston

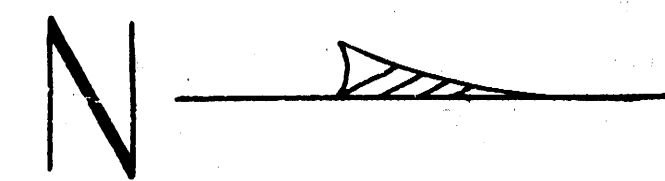

LEGEND


1" = 100' HORIZ.
 1" = 10' VERT.

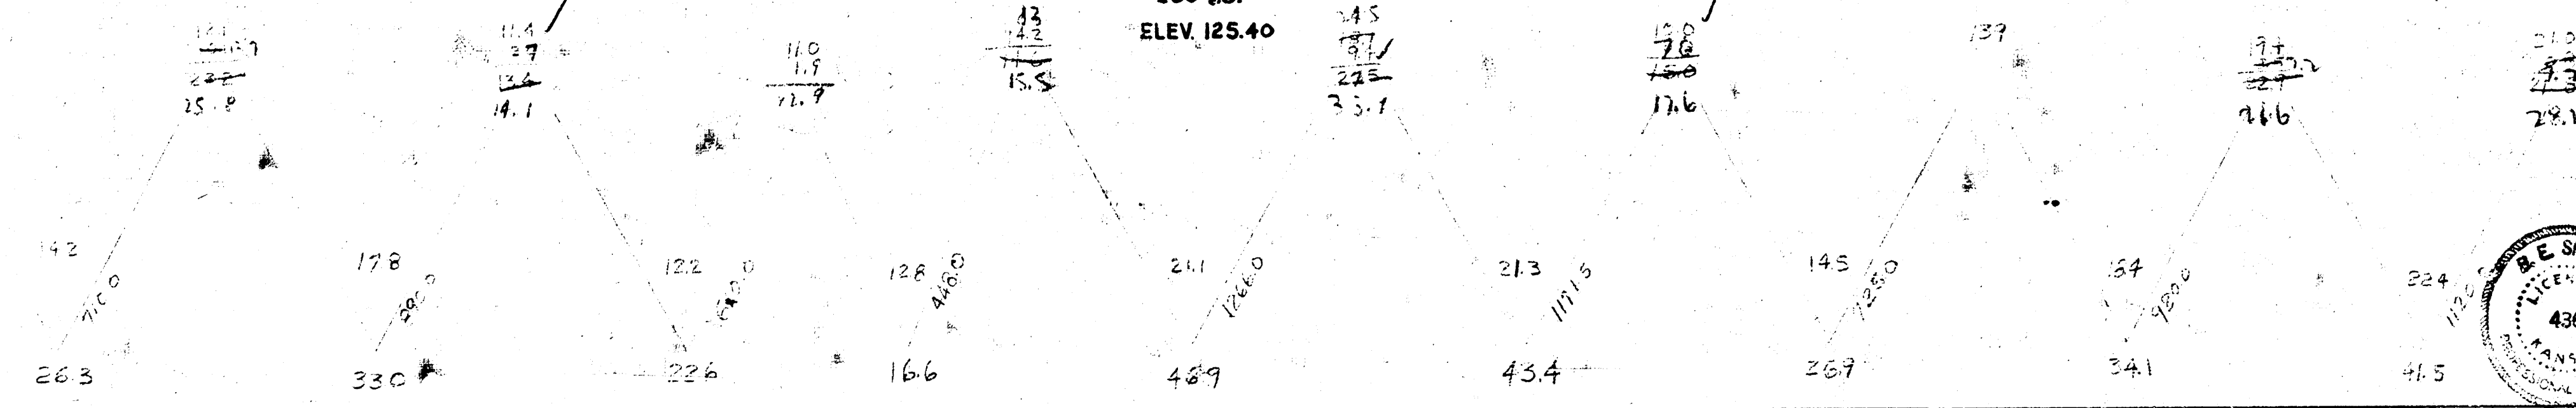



E 1/2 MISSION ROAD
 S.L. HARRY TO S.L. LINCOLN HILLS 3RD ADD.
 15' CONC. & CB
 B.E. SMITH
 APRIL 1954
 CITY ENGINEER
 PROJ. NO. C14-36



Survey by PAUL B. JAMES
 Plan of
 E.C. W.P.
 Checked J.L.

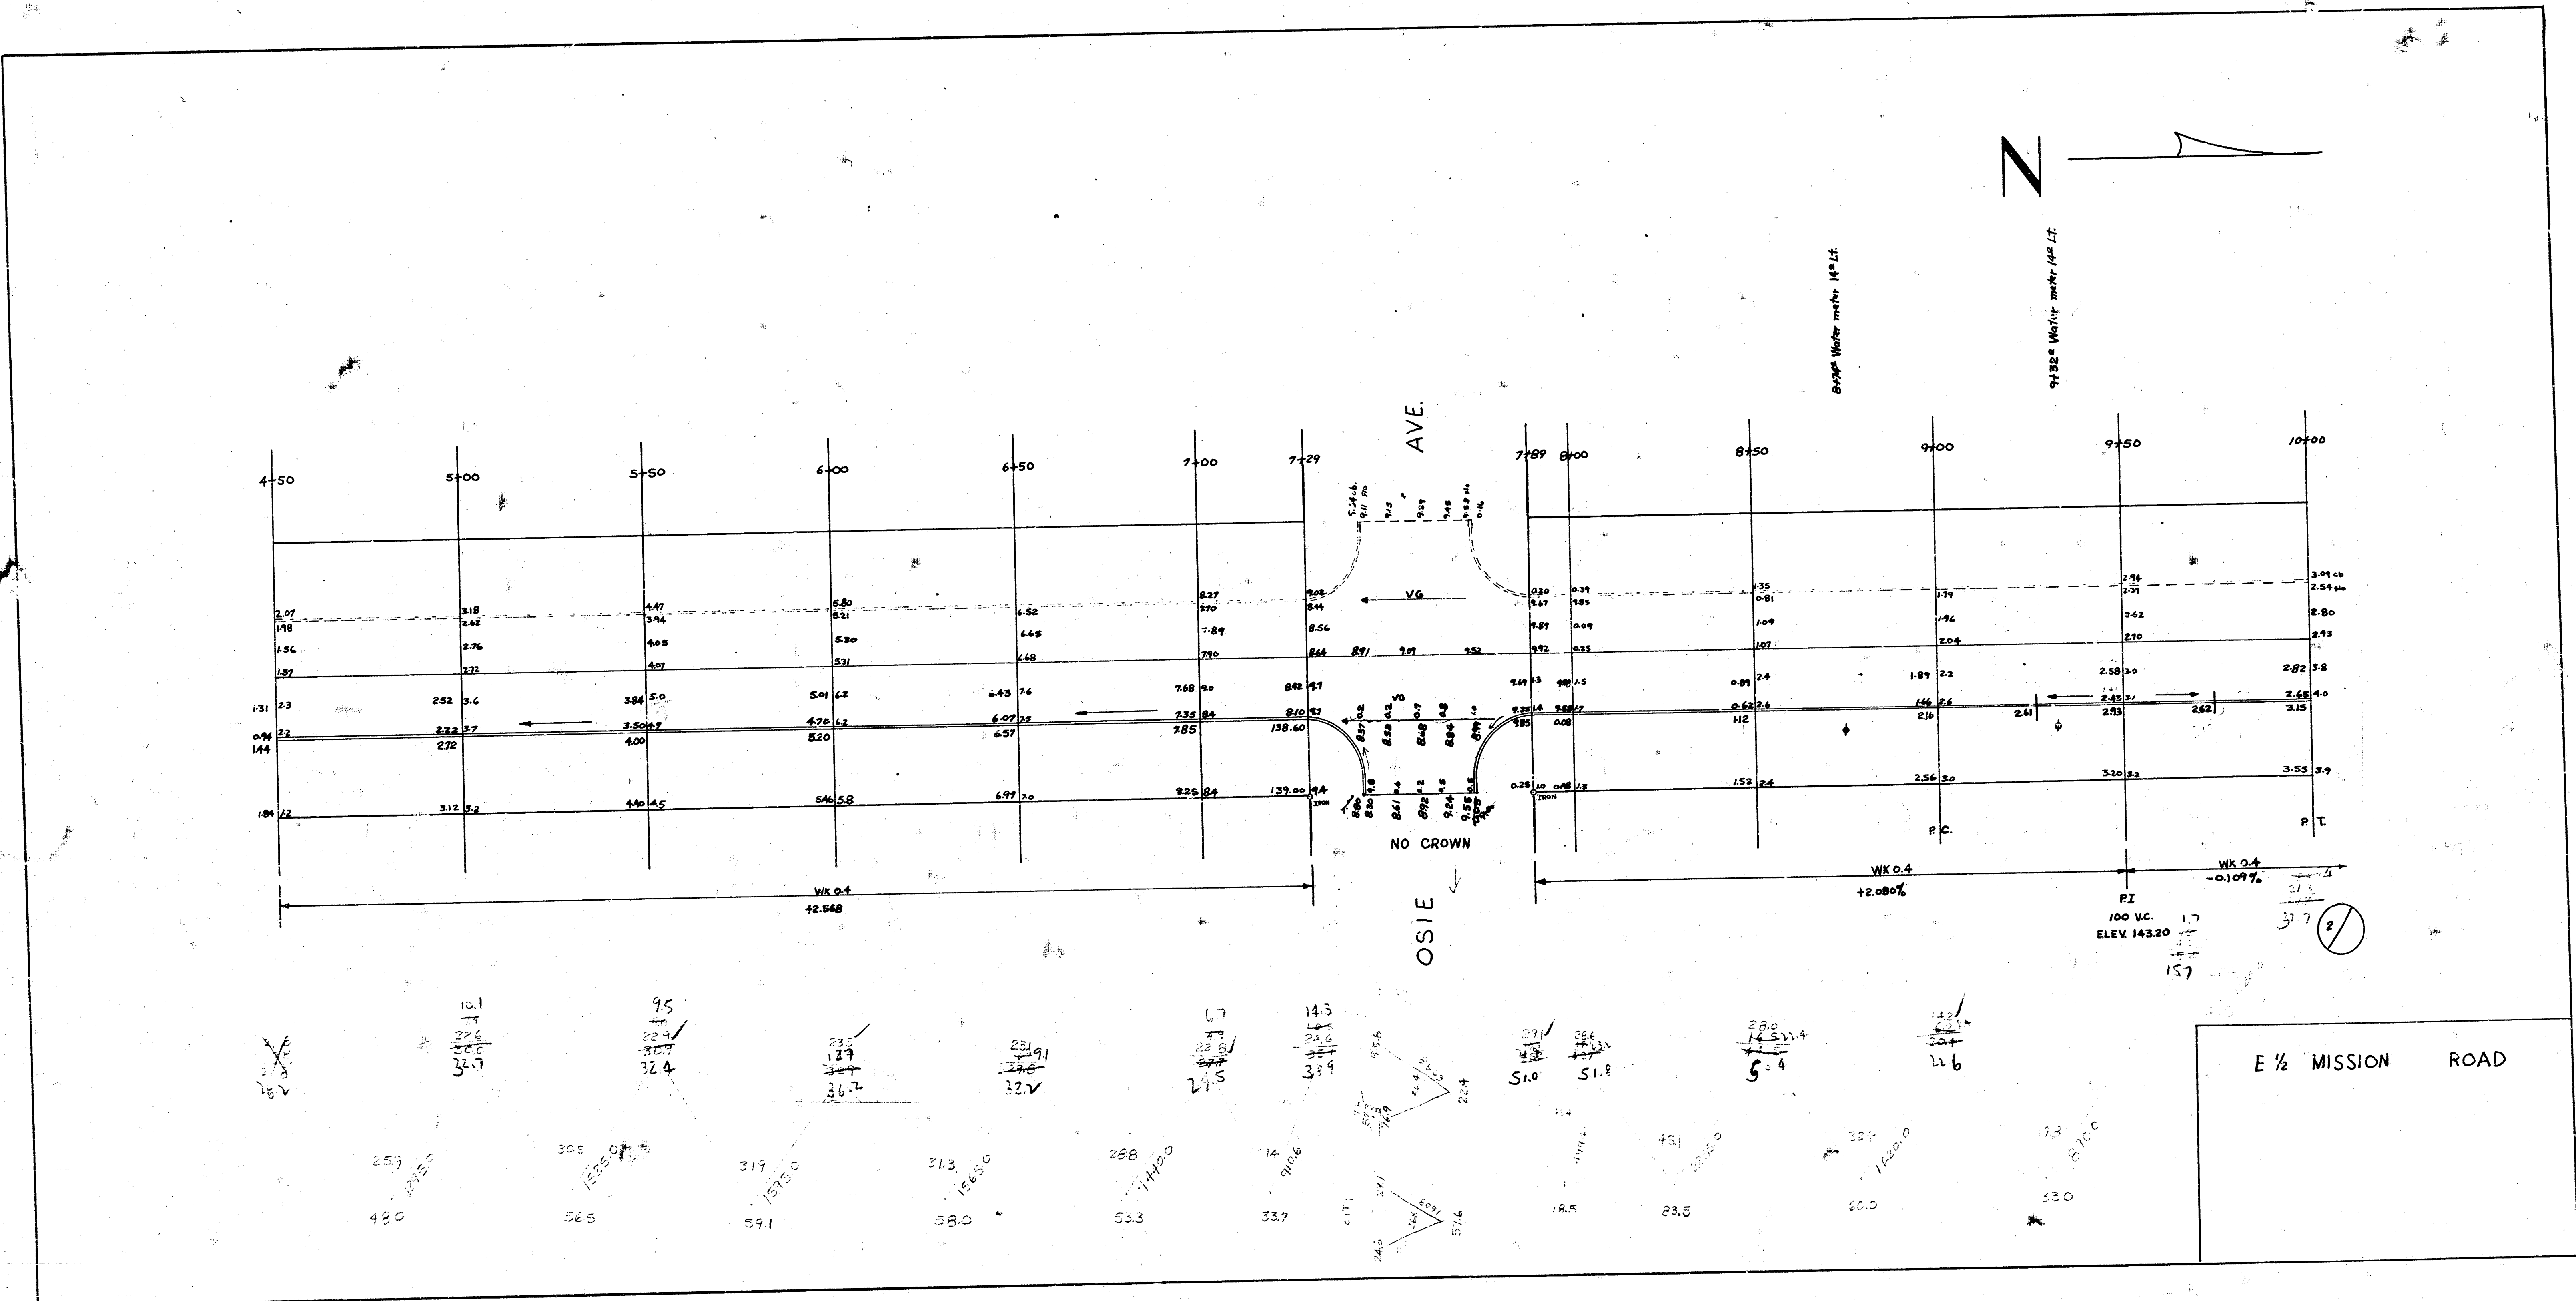

BM. 14270 "G" in Globe west curb Mission north radius of drive at sta 14+69

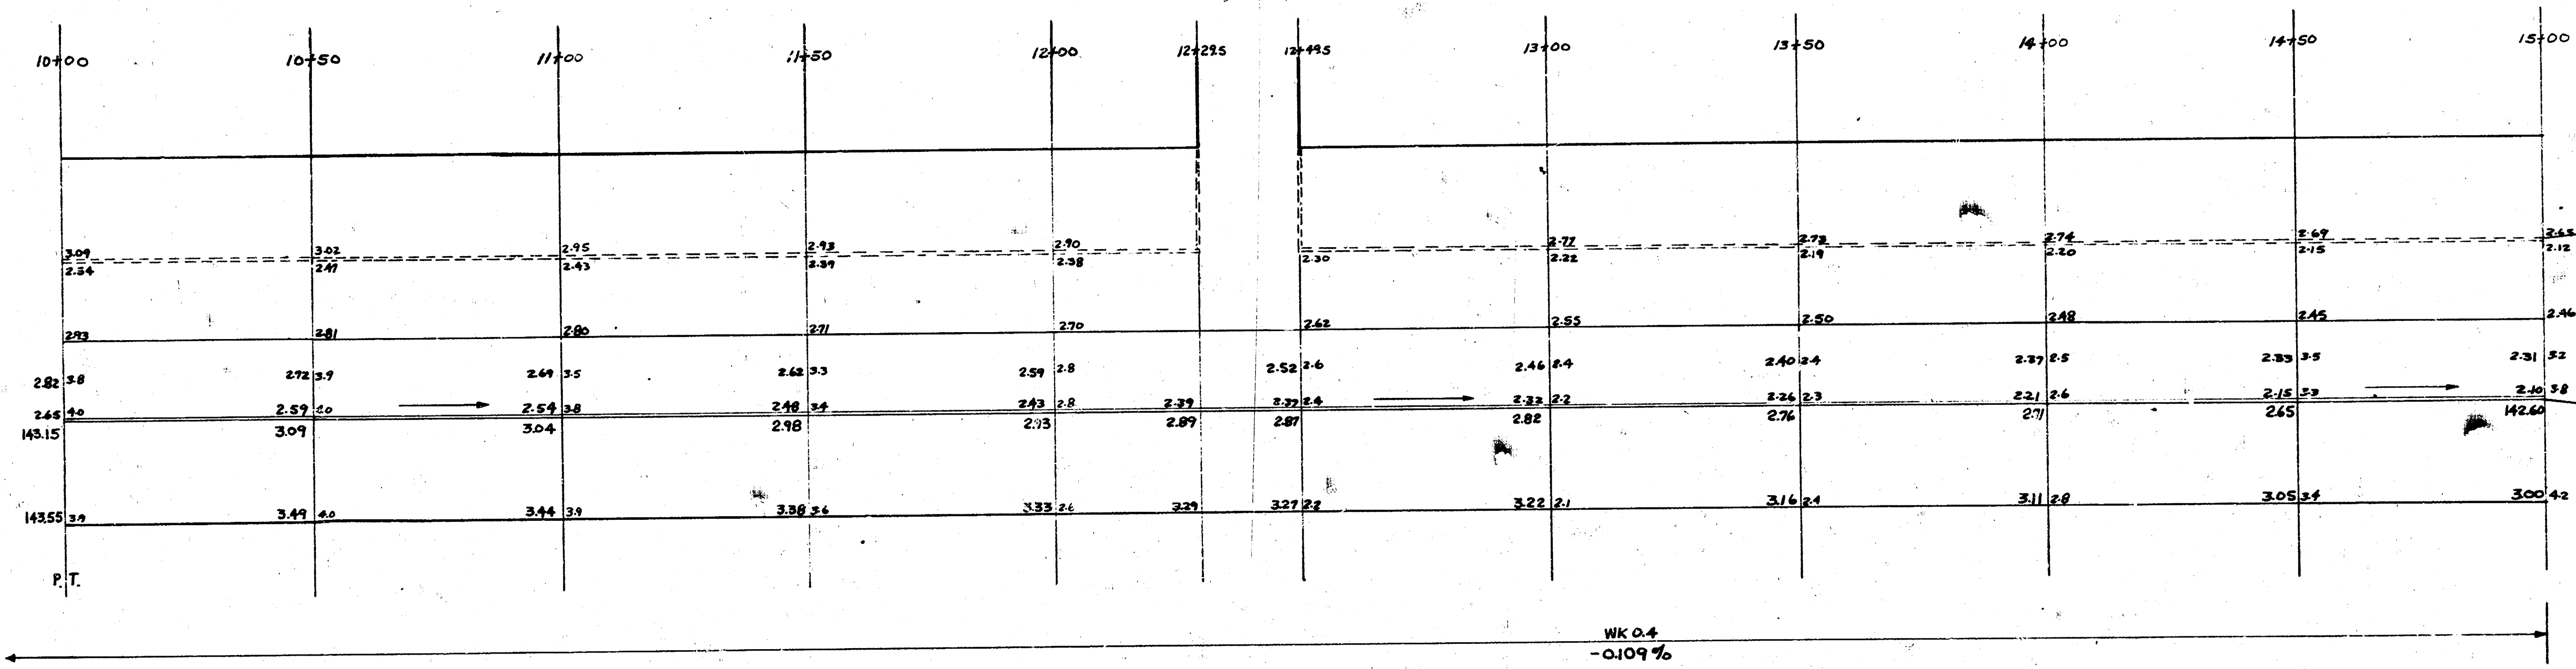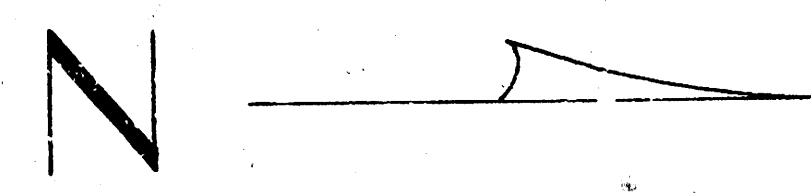

HARRY ST.

E 1/2 MISSION ROAD

