Oliver st. E. ½ - N.L. Waterman to N.L. Lewis
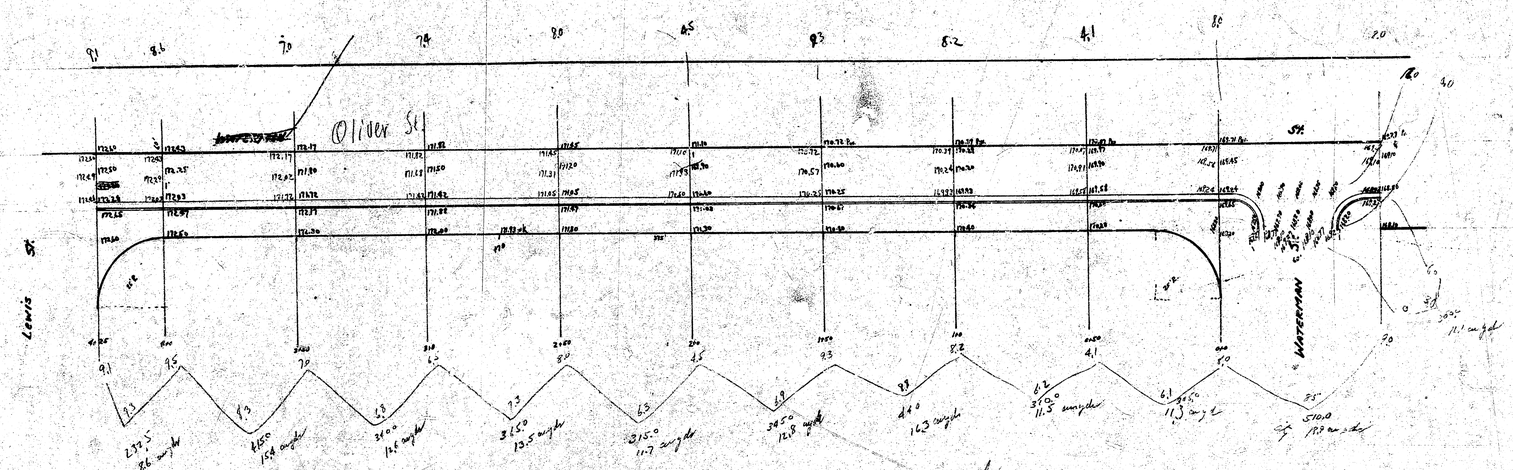
1st slab on E side of Oliver
Bff. elev. 163.65 ¼ in Globe S.W. Waterman E. curb Oliver