


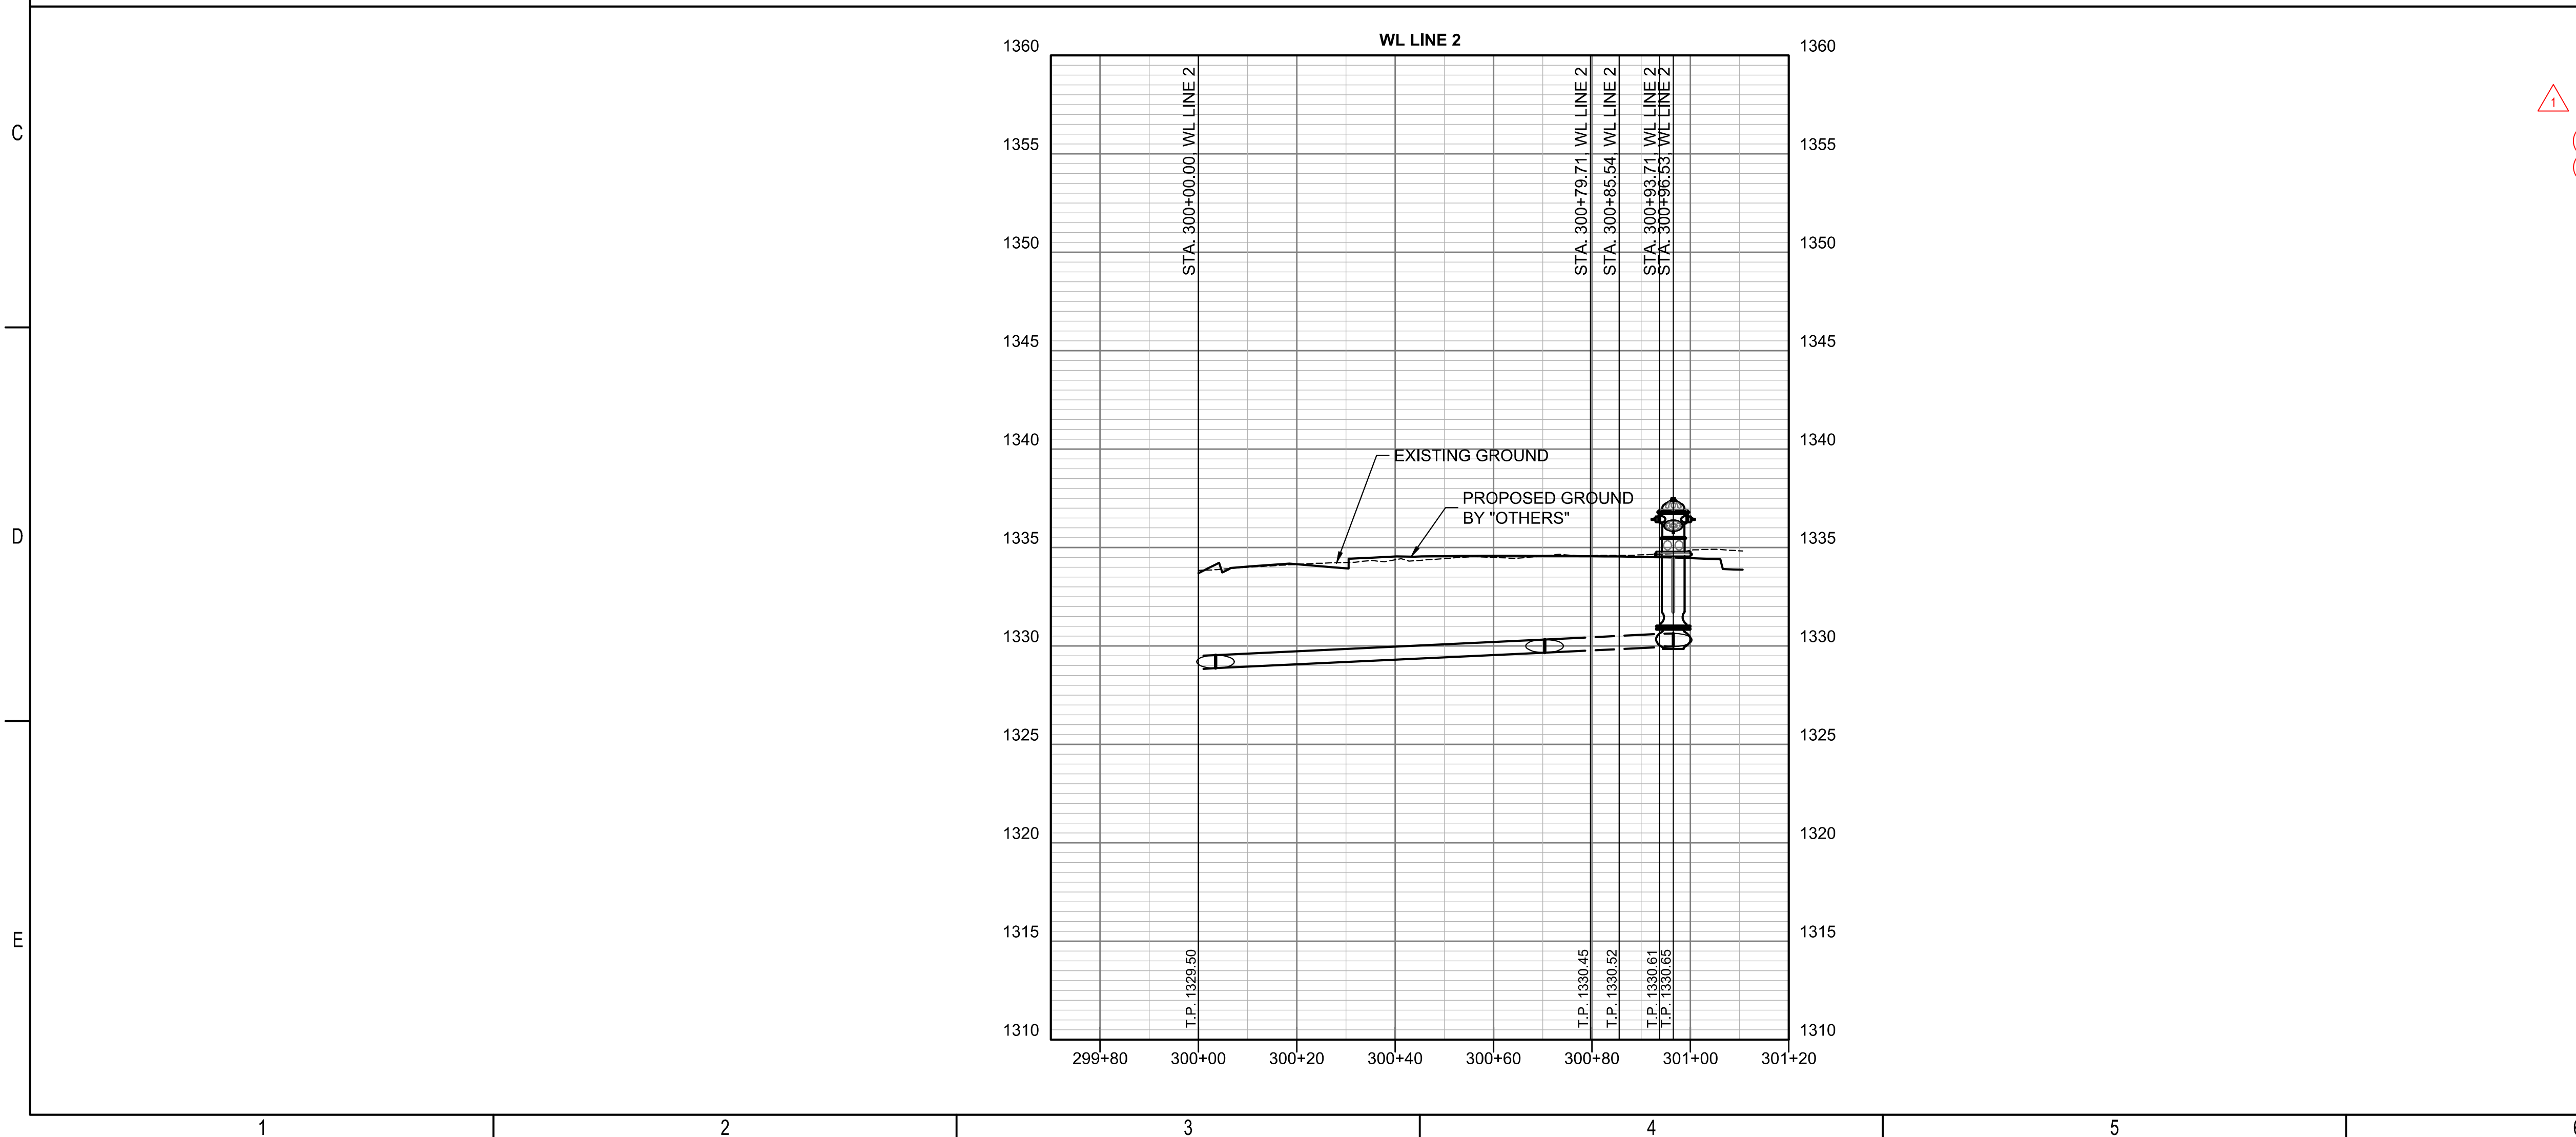

WATERLINE IMPROVEMENTS
TO SERVE
FIRST FURLONG ADDITION

CITY OF WICHITA, KANSAS
PAUL GUNZELMAN, P.E.-CITY ENGINEER
CITY OF WICHITA PROJECT NO. 448-2026-

Issue:		
1	ADDENDUM	8-18-26
JOB NO.	250624-002	
DATE	JULY 2026	
PM		RMM
DESIGNED BY		HJW
DRAWN BY		BJH
CHECKED BY		HJW
WATERLINE 2		
13 13 OF 16		

SAVED 8/19/2026 9:53:42 AM BY HUNTER.WILES
PLOTTED 8/19/2026 9:56:19 AM BY HUNTER WILES
C:\DC\ACCD\DCSPEC HUB\250624-000 - ASCOT SENIOR LIVING\PROJECT
FILES\030 DESIGN\SS-WTR\WATER\250624-002-WTR.DWG