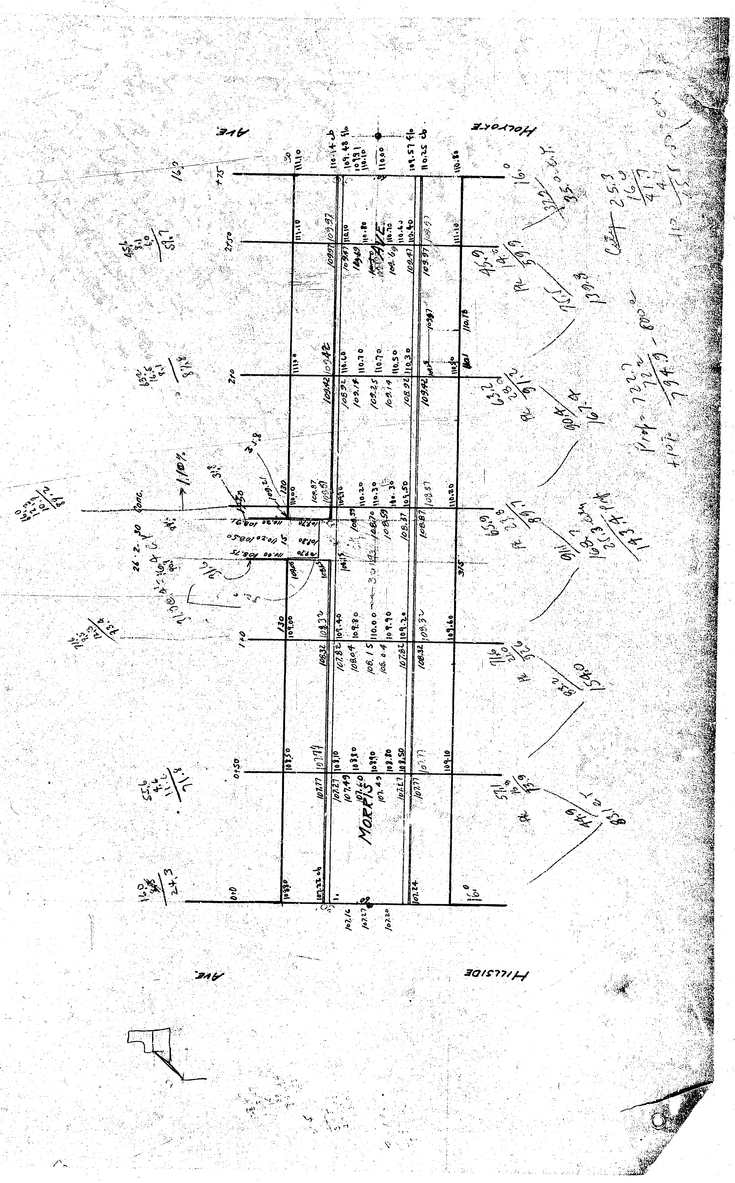Morris St. – e.l. Hillside to w.l. Holyoke