


1941

MORRIS-EL HOLYOKE TO W.L. RUTAN
30' CONC. WITH INTEGRAL CURB

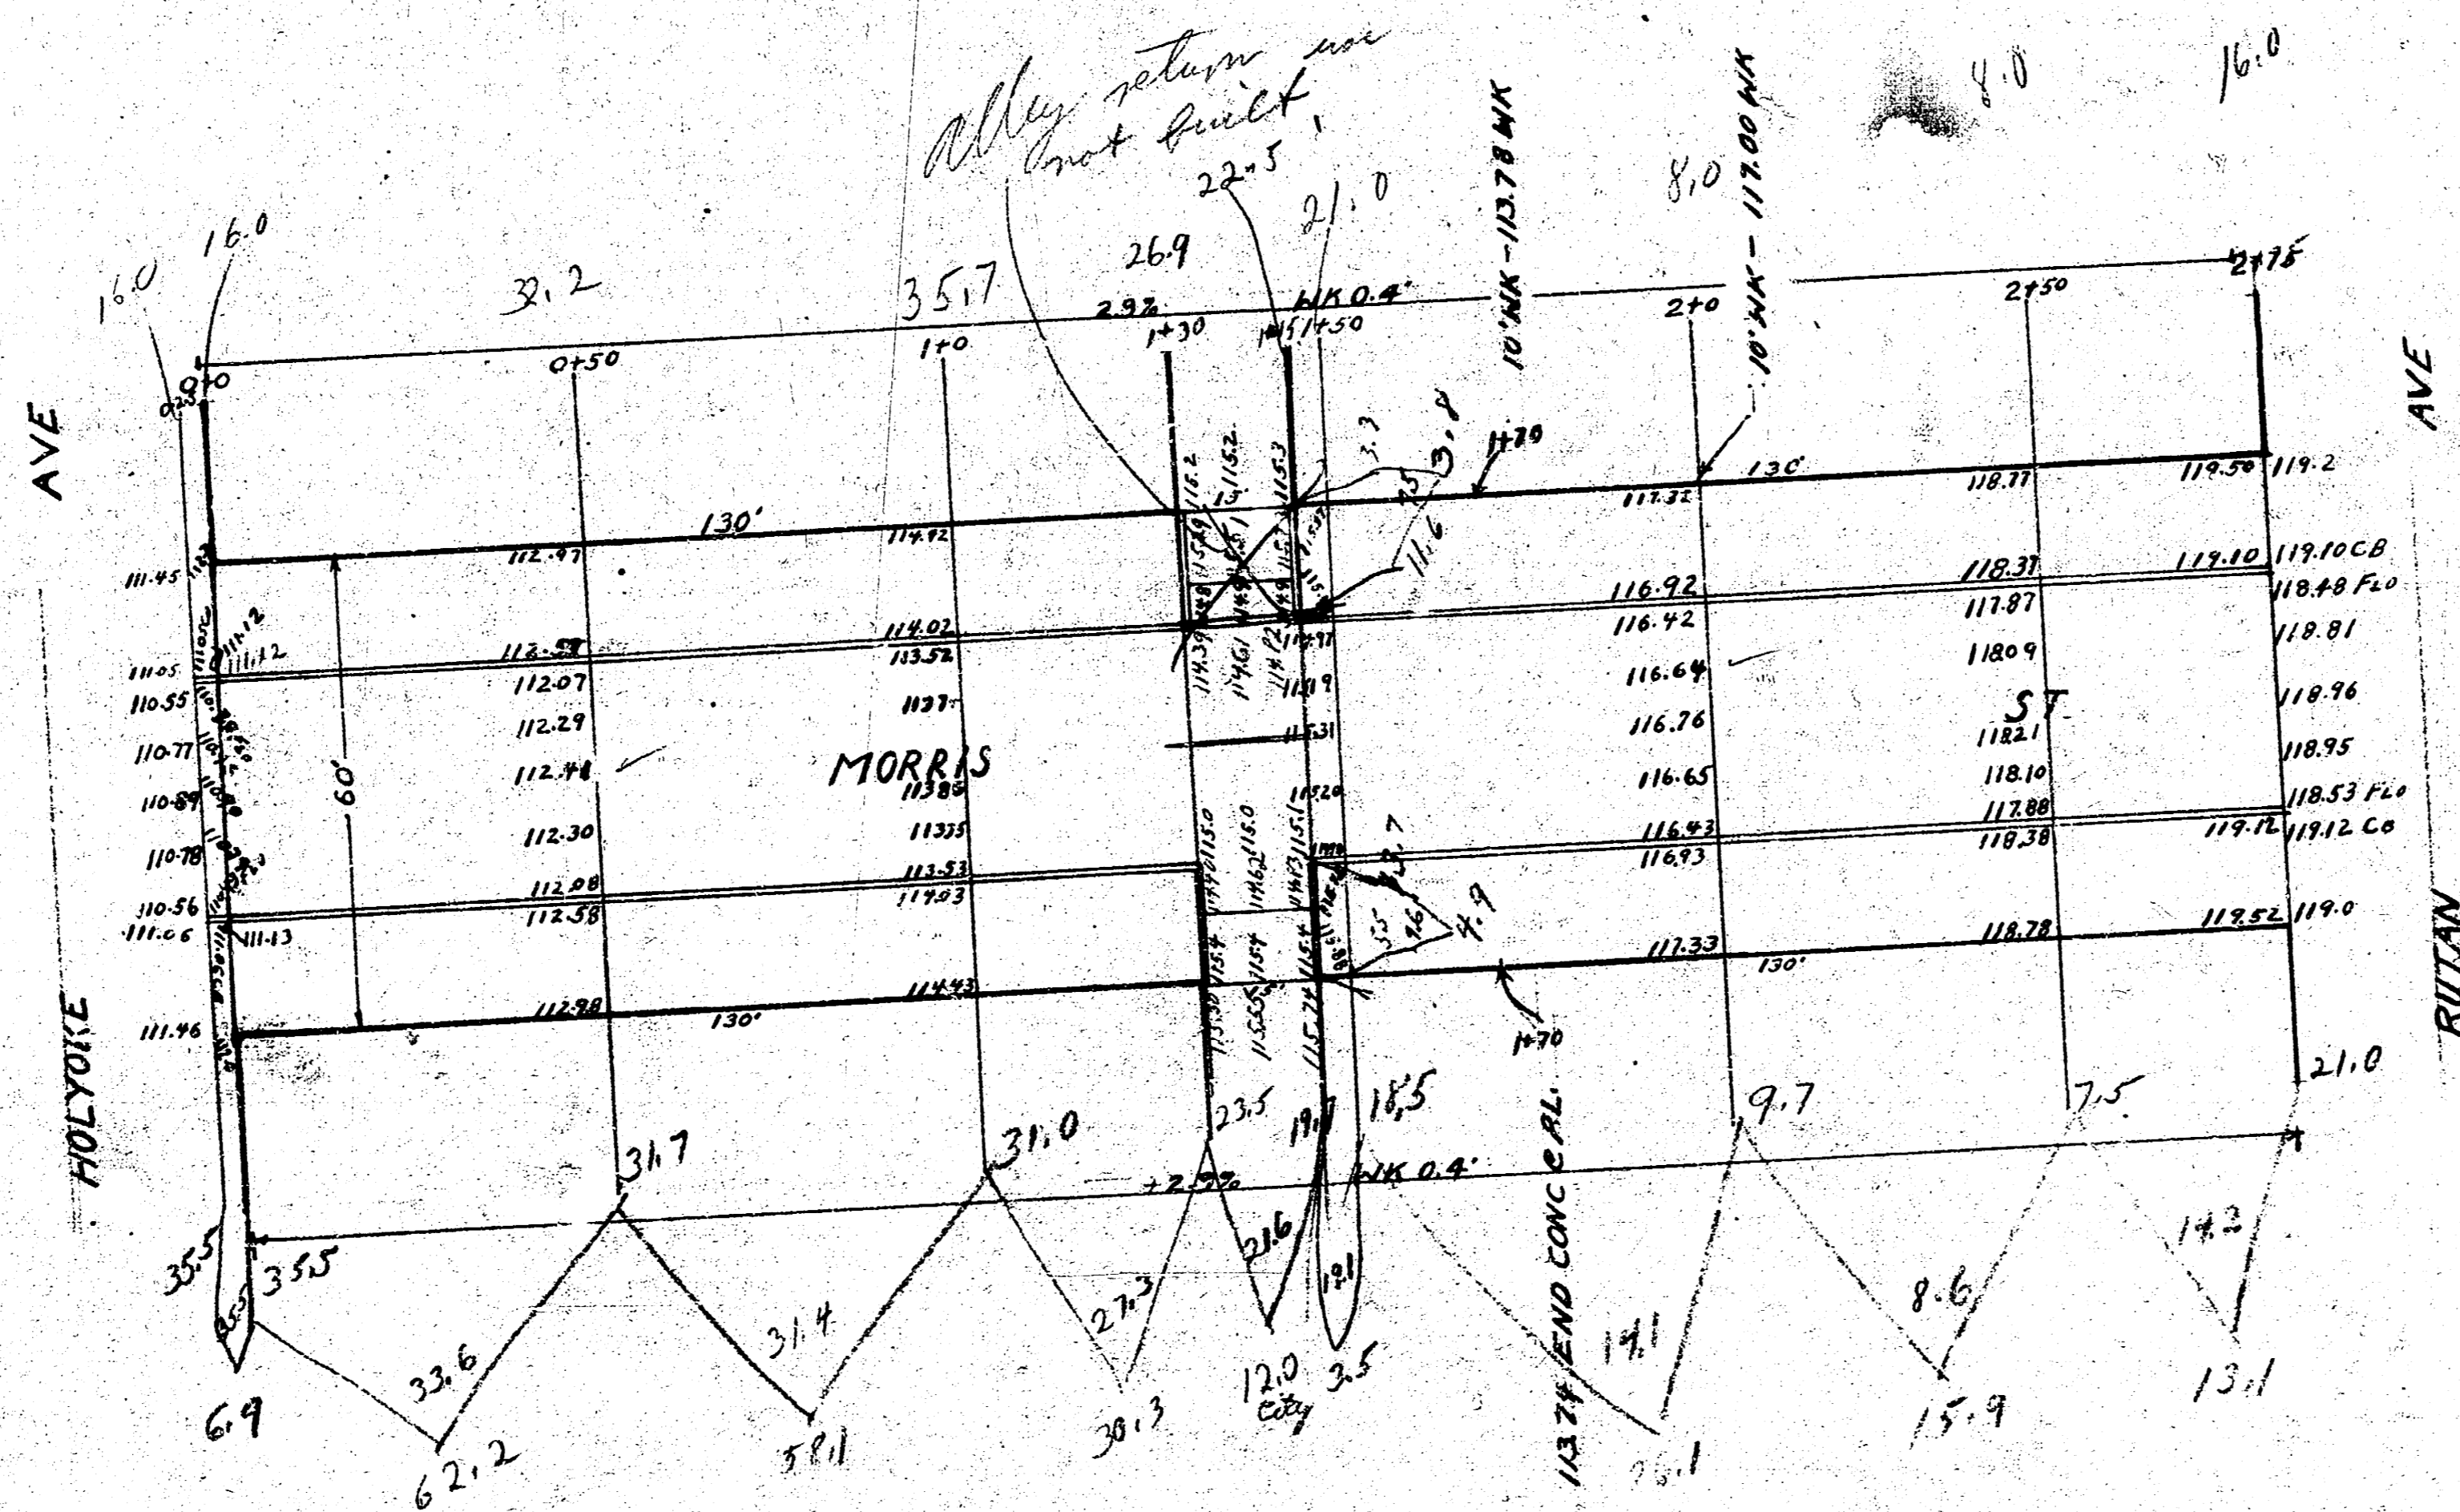

BIX 12638 RIM N.H. N. MORRIS ALLEY BETWEEN RUTAN + VASSAR

Property	City
62.2	3.2
54.1	4.9
30.3	12.6
35.5	21.3
26.1	6.9
15.9	28.2
13.1	
209.2	

PROPERTY	CITY	CU YD + 11% = TOTAL
209.2	20.9	230.1
28.2	2.1	30.3
		GRAND TOTAL 260.4