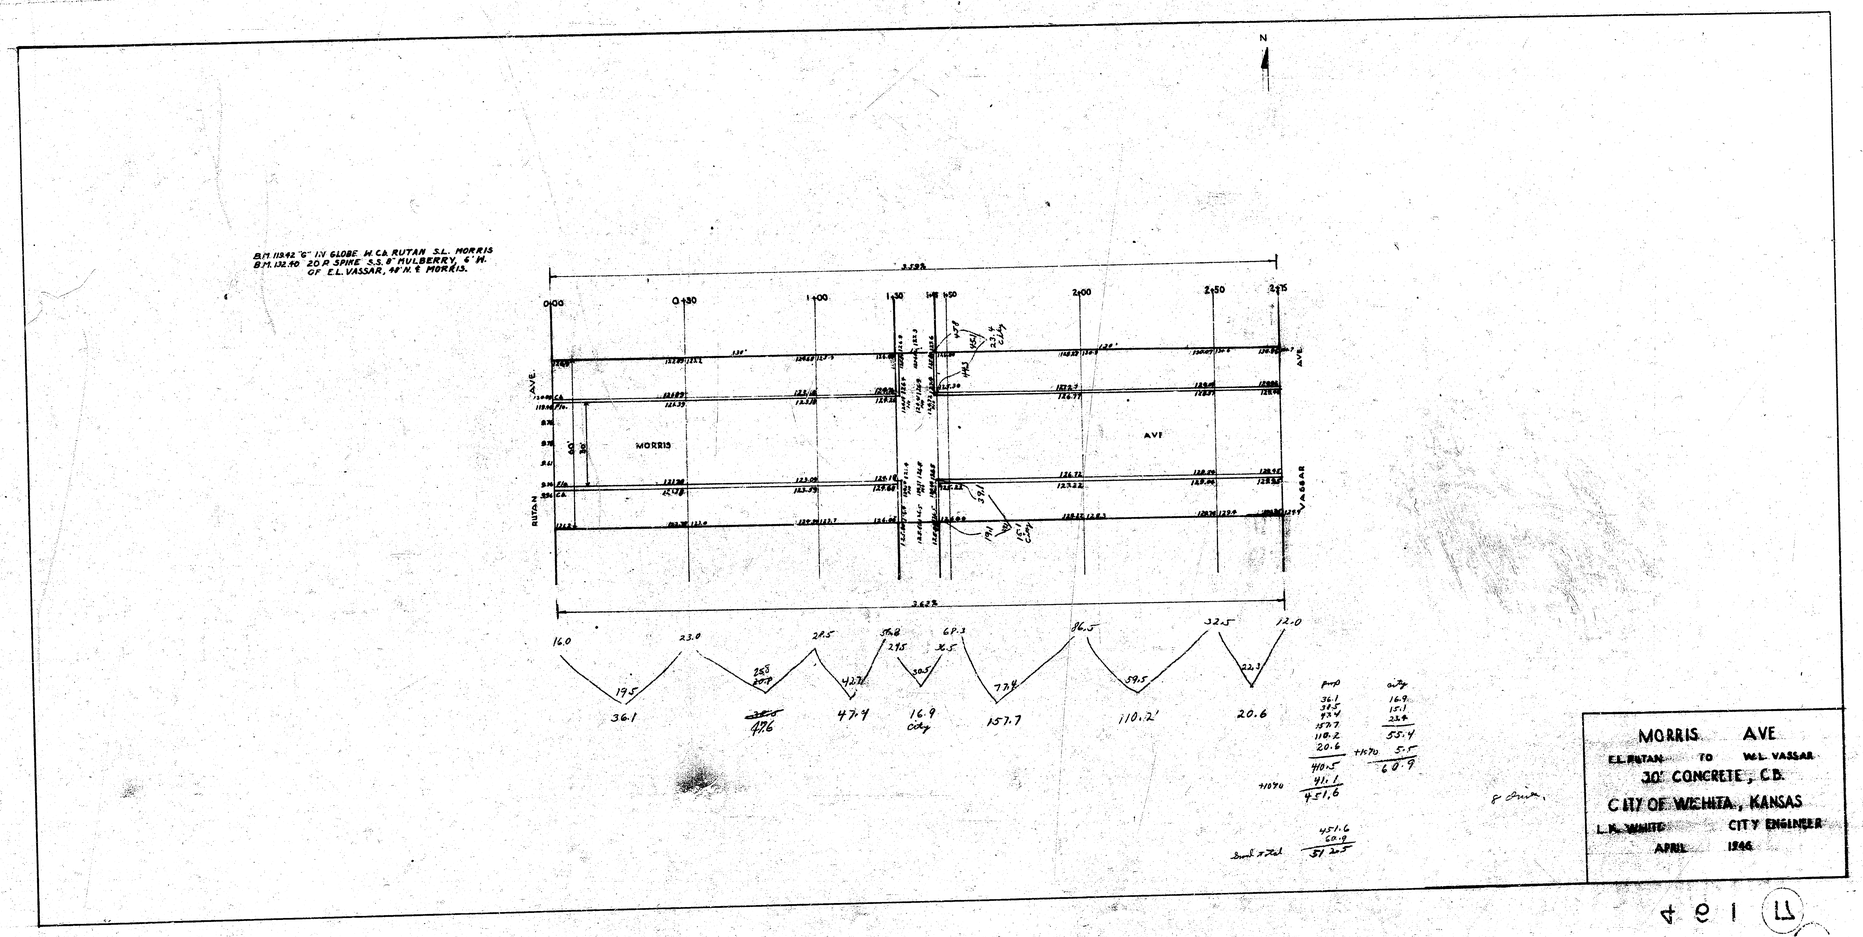
B.M. 119.42 "G" IN GLOBE W. CA. RUTAN S.L. MORRIS
B.M. 132.40 20 P. SPIKE S.S. 8" MULBERRY, 6' W. OF E.L. VASSAR, 48' N. ℄ MORRIS.
N
MORRIS
AVE
RUTAN
VASSAR
0+00
0+30
1+00
1+30
2+00
2+50
2+75
16.0
23.0
28.5
56.8
68.3
86.5
32.5
12.0
36.1
47.6
47.4
16.9 city
157.7
110.2'
20.6
pump
36.1
38.5
43.4
157.7
110.2
20.6
410.5
+1070
41.1
451.6
city
16.9
15.1
23.4
55.4
+1070
5.5
60.9
451.6
60.9
512.5
8 Drive.
MORRIS AVE
E.L. RUTAN TO W.L. VASSAR
30' CONCRETE, C.B.
CITY OF WICHITA, KANSAS
L.K. WHITE CITY ENGINEER
APRIL 1946

4 0 1 (F)