CHM-80


B. M.-"R" IN RITCHIE N. CO. MORRIS, E.L. MISSION RD.-160.56

SCALE: 1"=20'

- EXCAVATION -

CITY	DROP
0.0	426.3

±10% 62.6 / 426.7 YDS.³ EXC.

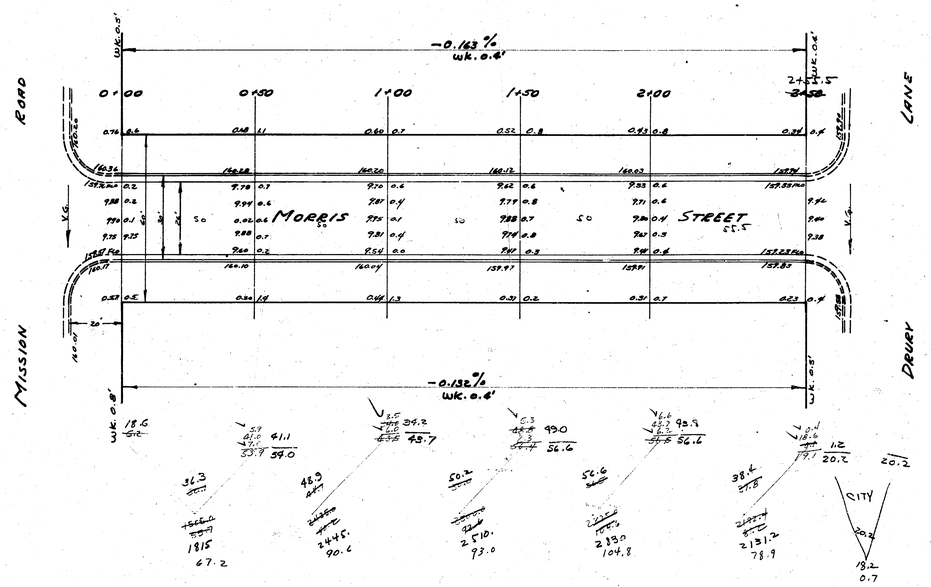

K. WHITE LICENSED 55 KANSAS PROFESSIONAL ENGINEER

MORRIS

E.L. MISSION TO W.L. DRURY

26-2-30 P.C.

CITY OF WICHITA, KANSAS

C.K. WHITE CITY ENGINEER

JULY 1952 PROJ. NO. C12-70

L 5 1 ⑥