



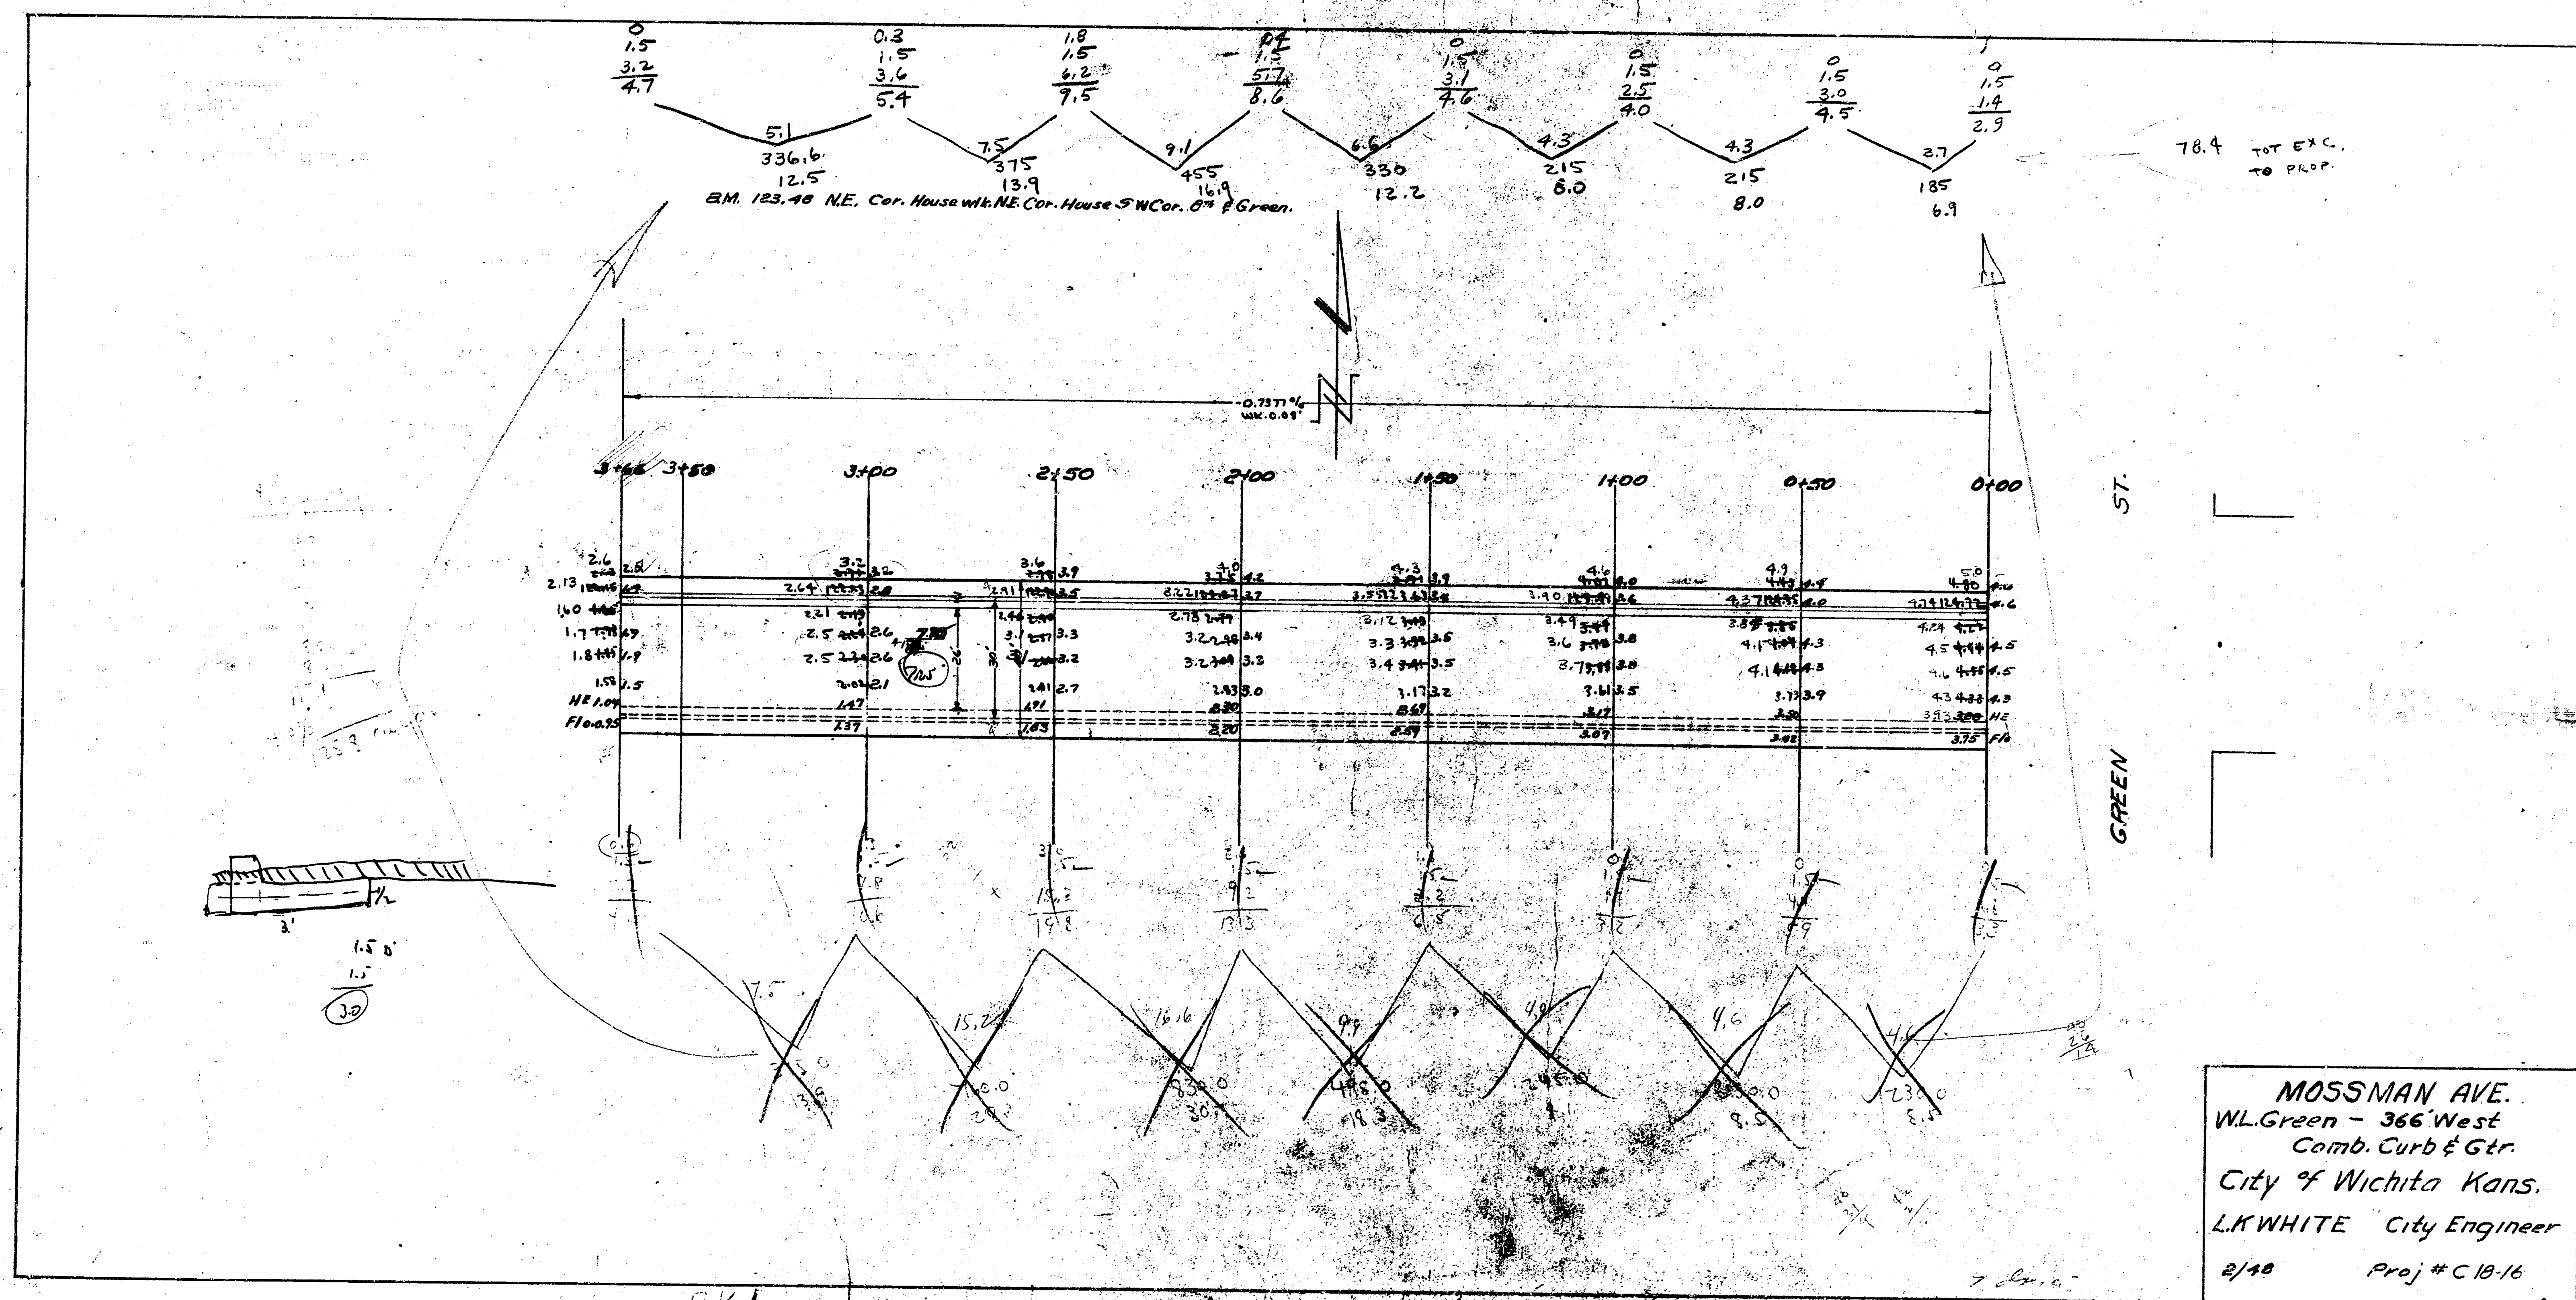

B.M. 123.48 NE. Cor. House with NE Cor. House SW Cor. 6" # Green.

Property

189
281
307
188
9.1
8.5
177.1
+10% 117
128.8 cu yds

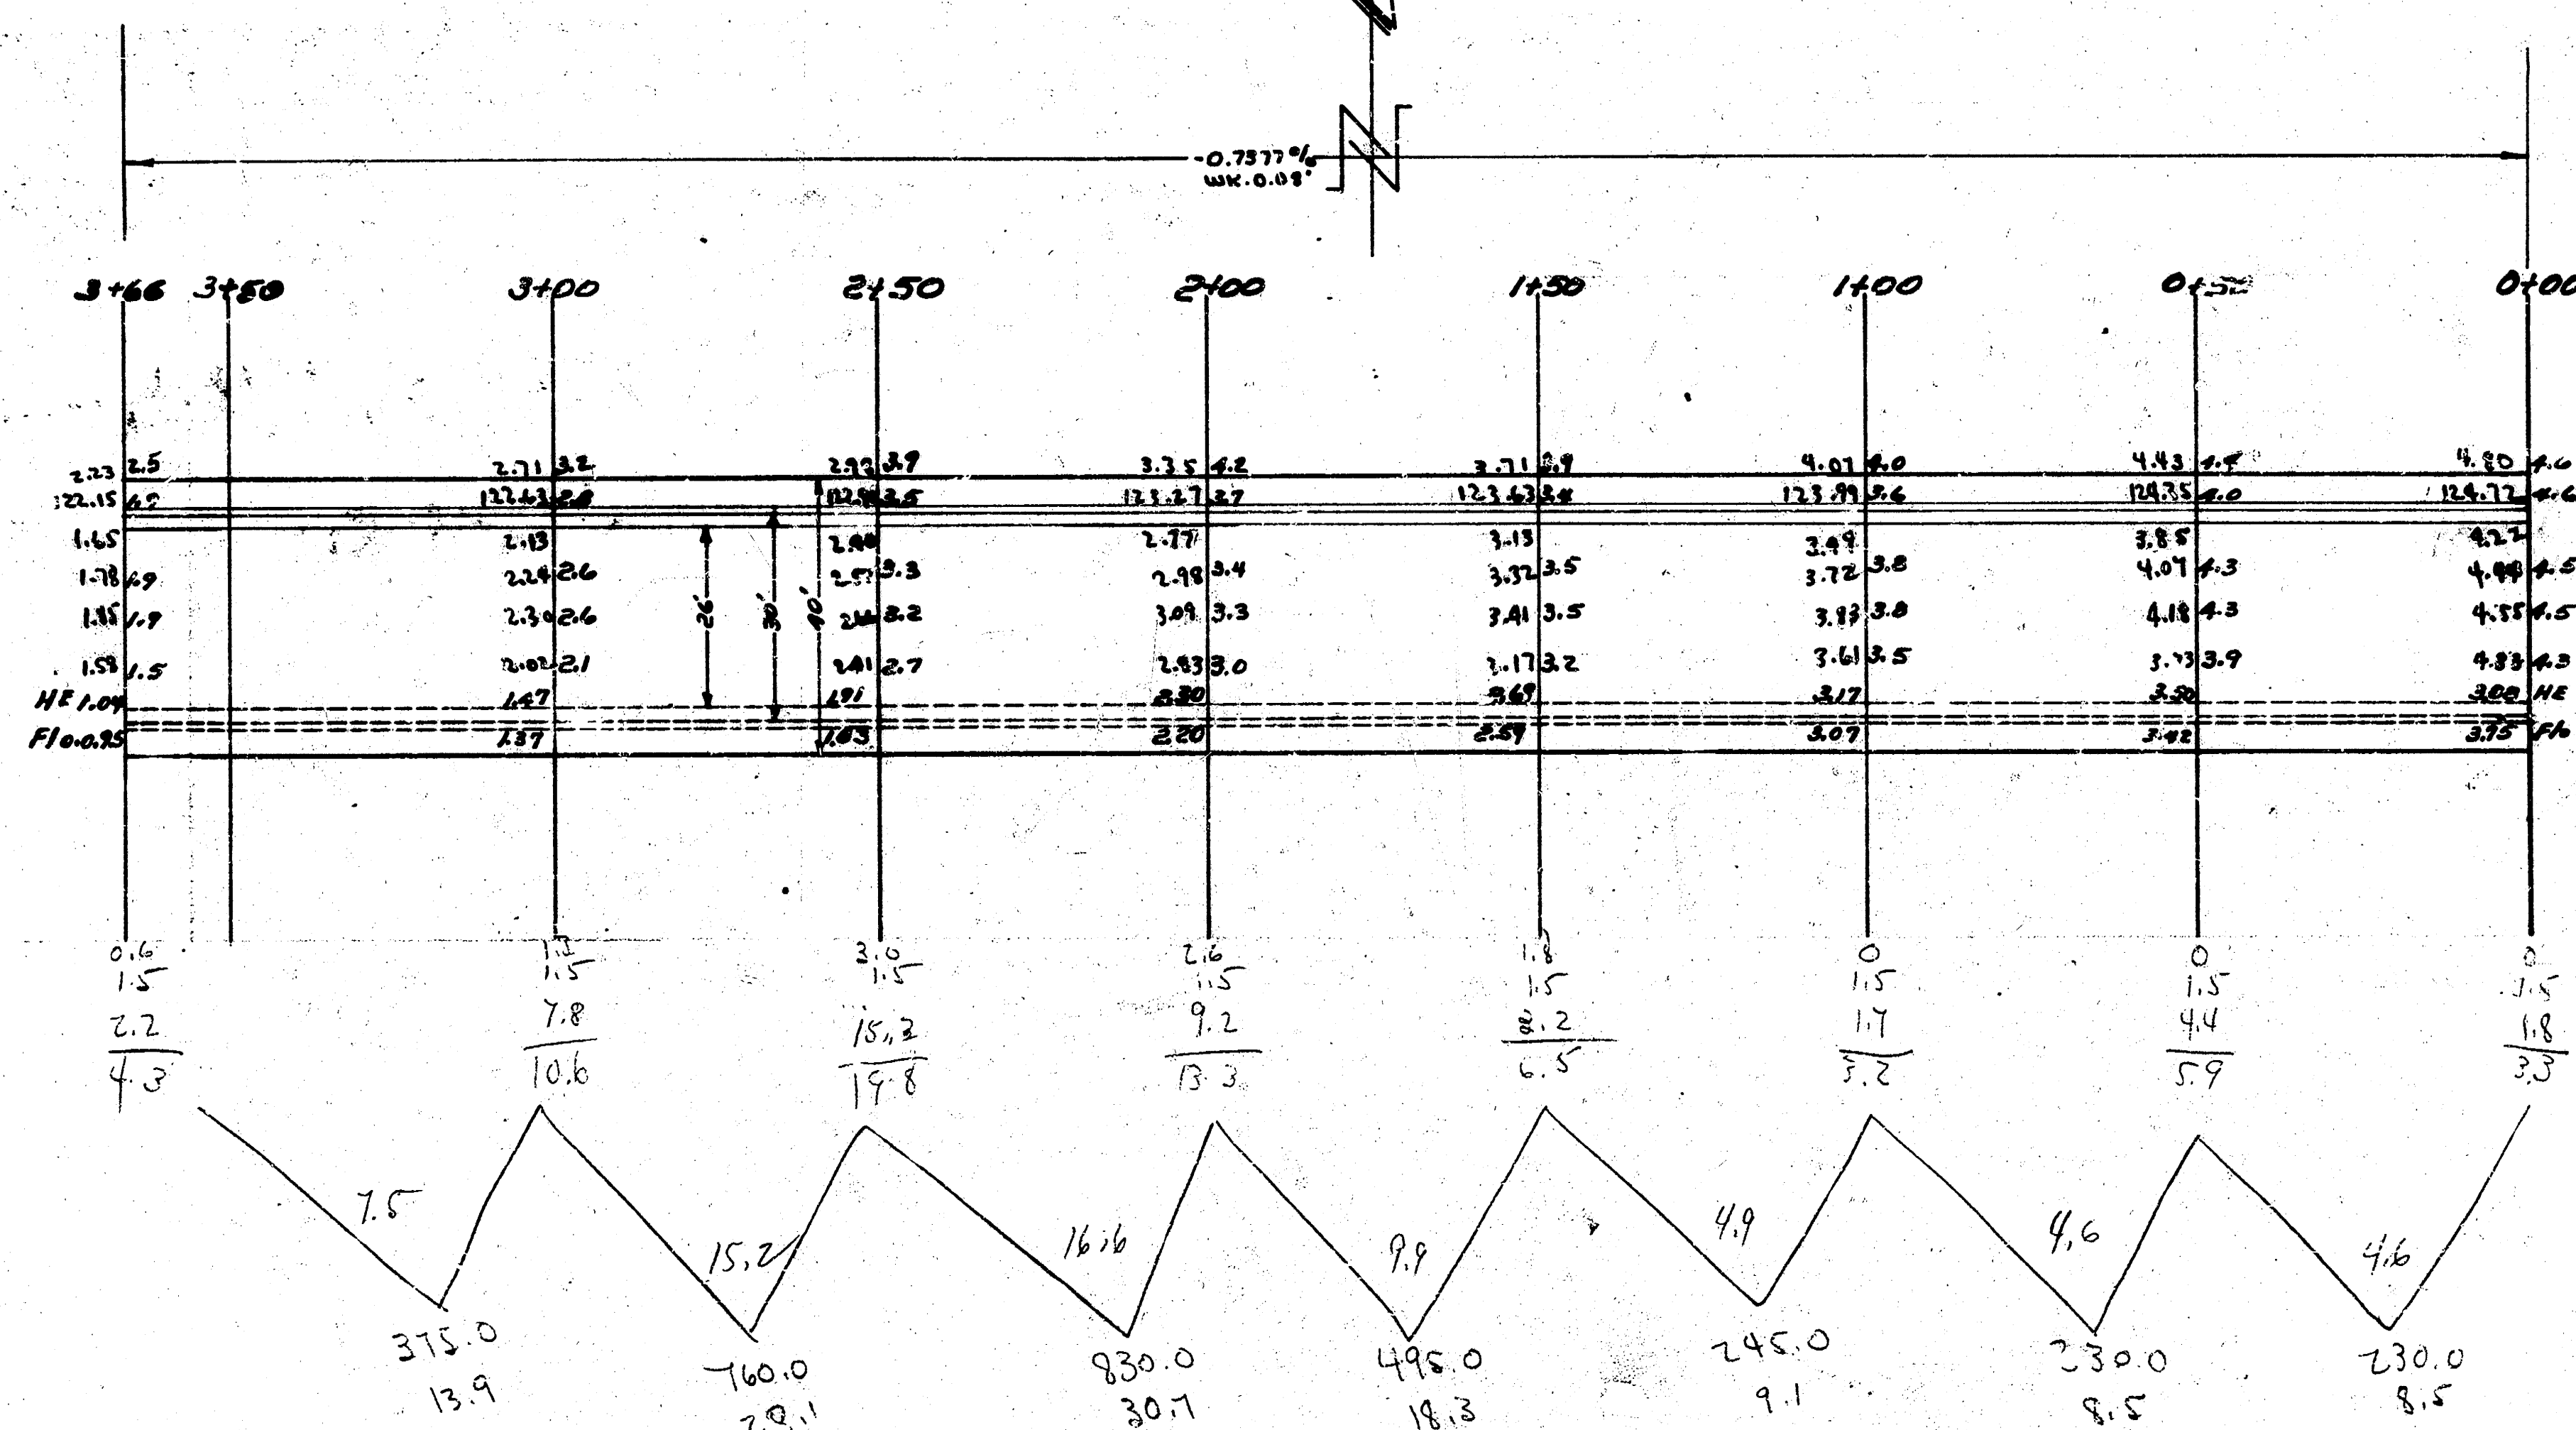

ST.

GREEN

MOSSMAN AVE.
WL Green - 366' West
Comb. Curb & Gtr.
City of Wichita Kans.
LK WHITE City Engineer
2/40 Proj # C 10-16

BK1

4 15 3 e