


PAVING PLAN 1943
MOSSMAN AVE. - 100' W. WL. VOLUTSIA to 200' E. EL. VOLUTSIA
30' Conc. - Int. Curb

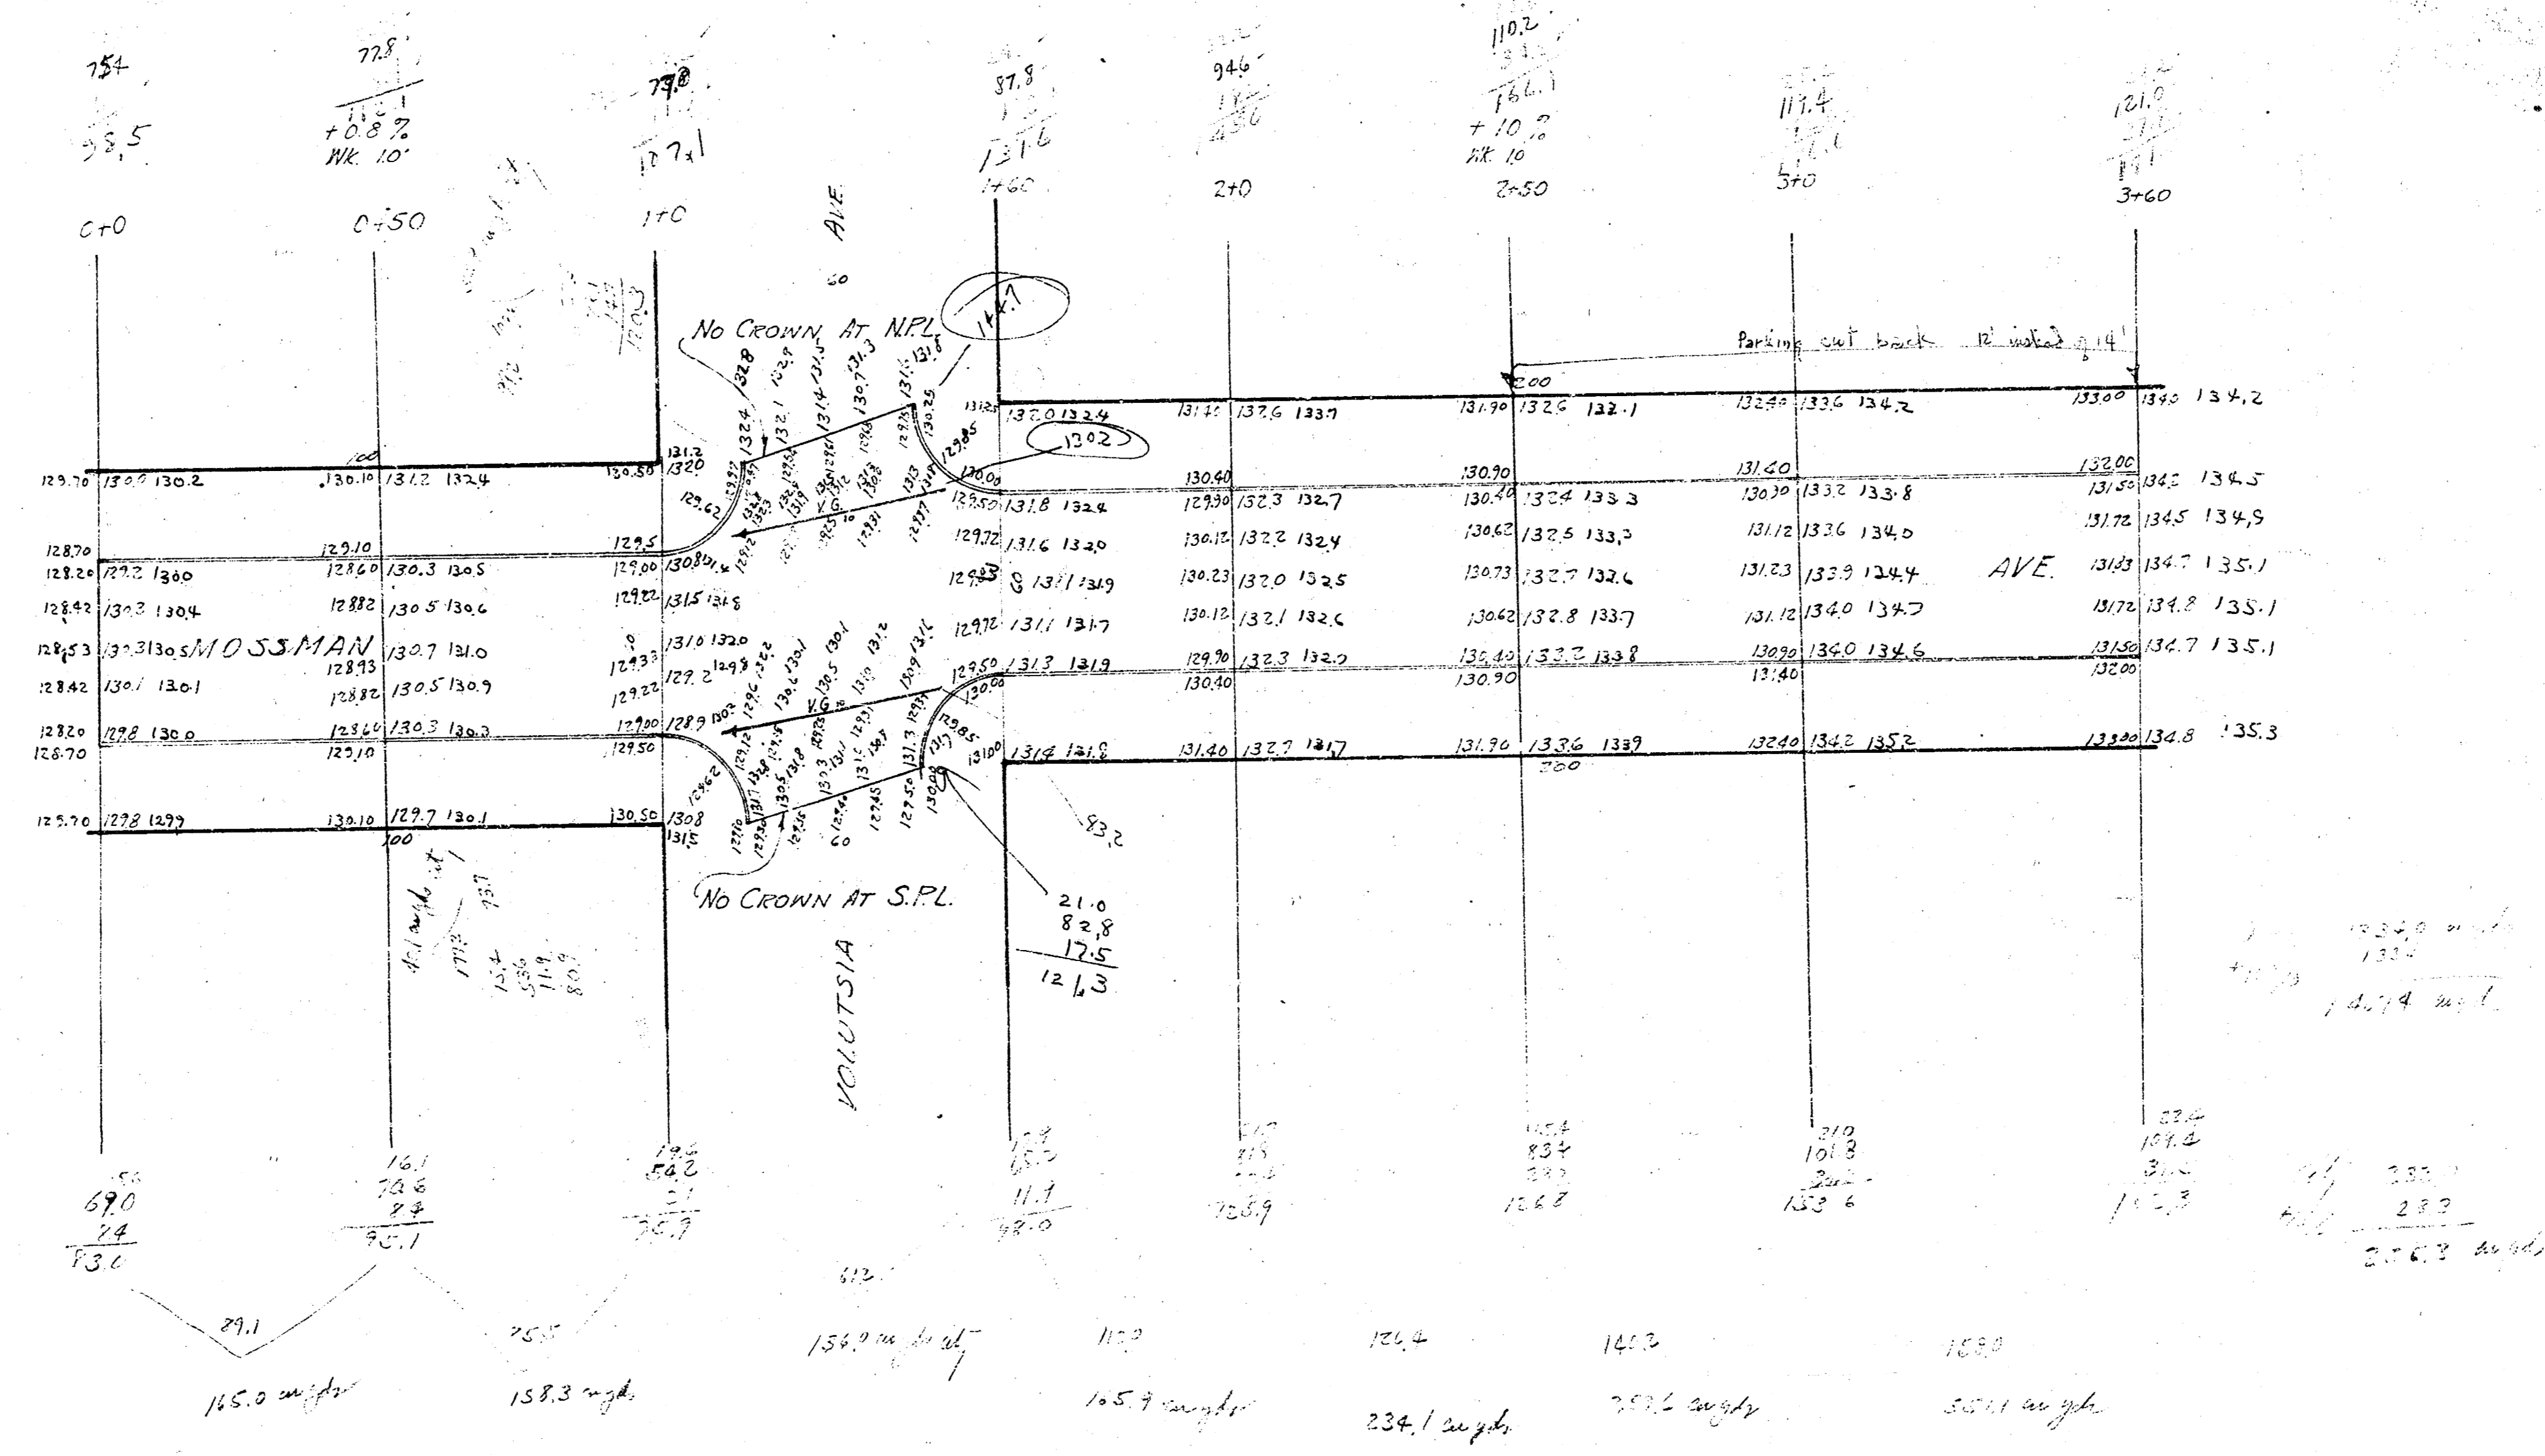

B.M. Elev. 131.90 Sta. 66. ch. 10 F.P. SW cor. Volutsia & 9th