


B.M. 130.00 E. of Volutsia S.L. Mossman

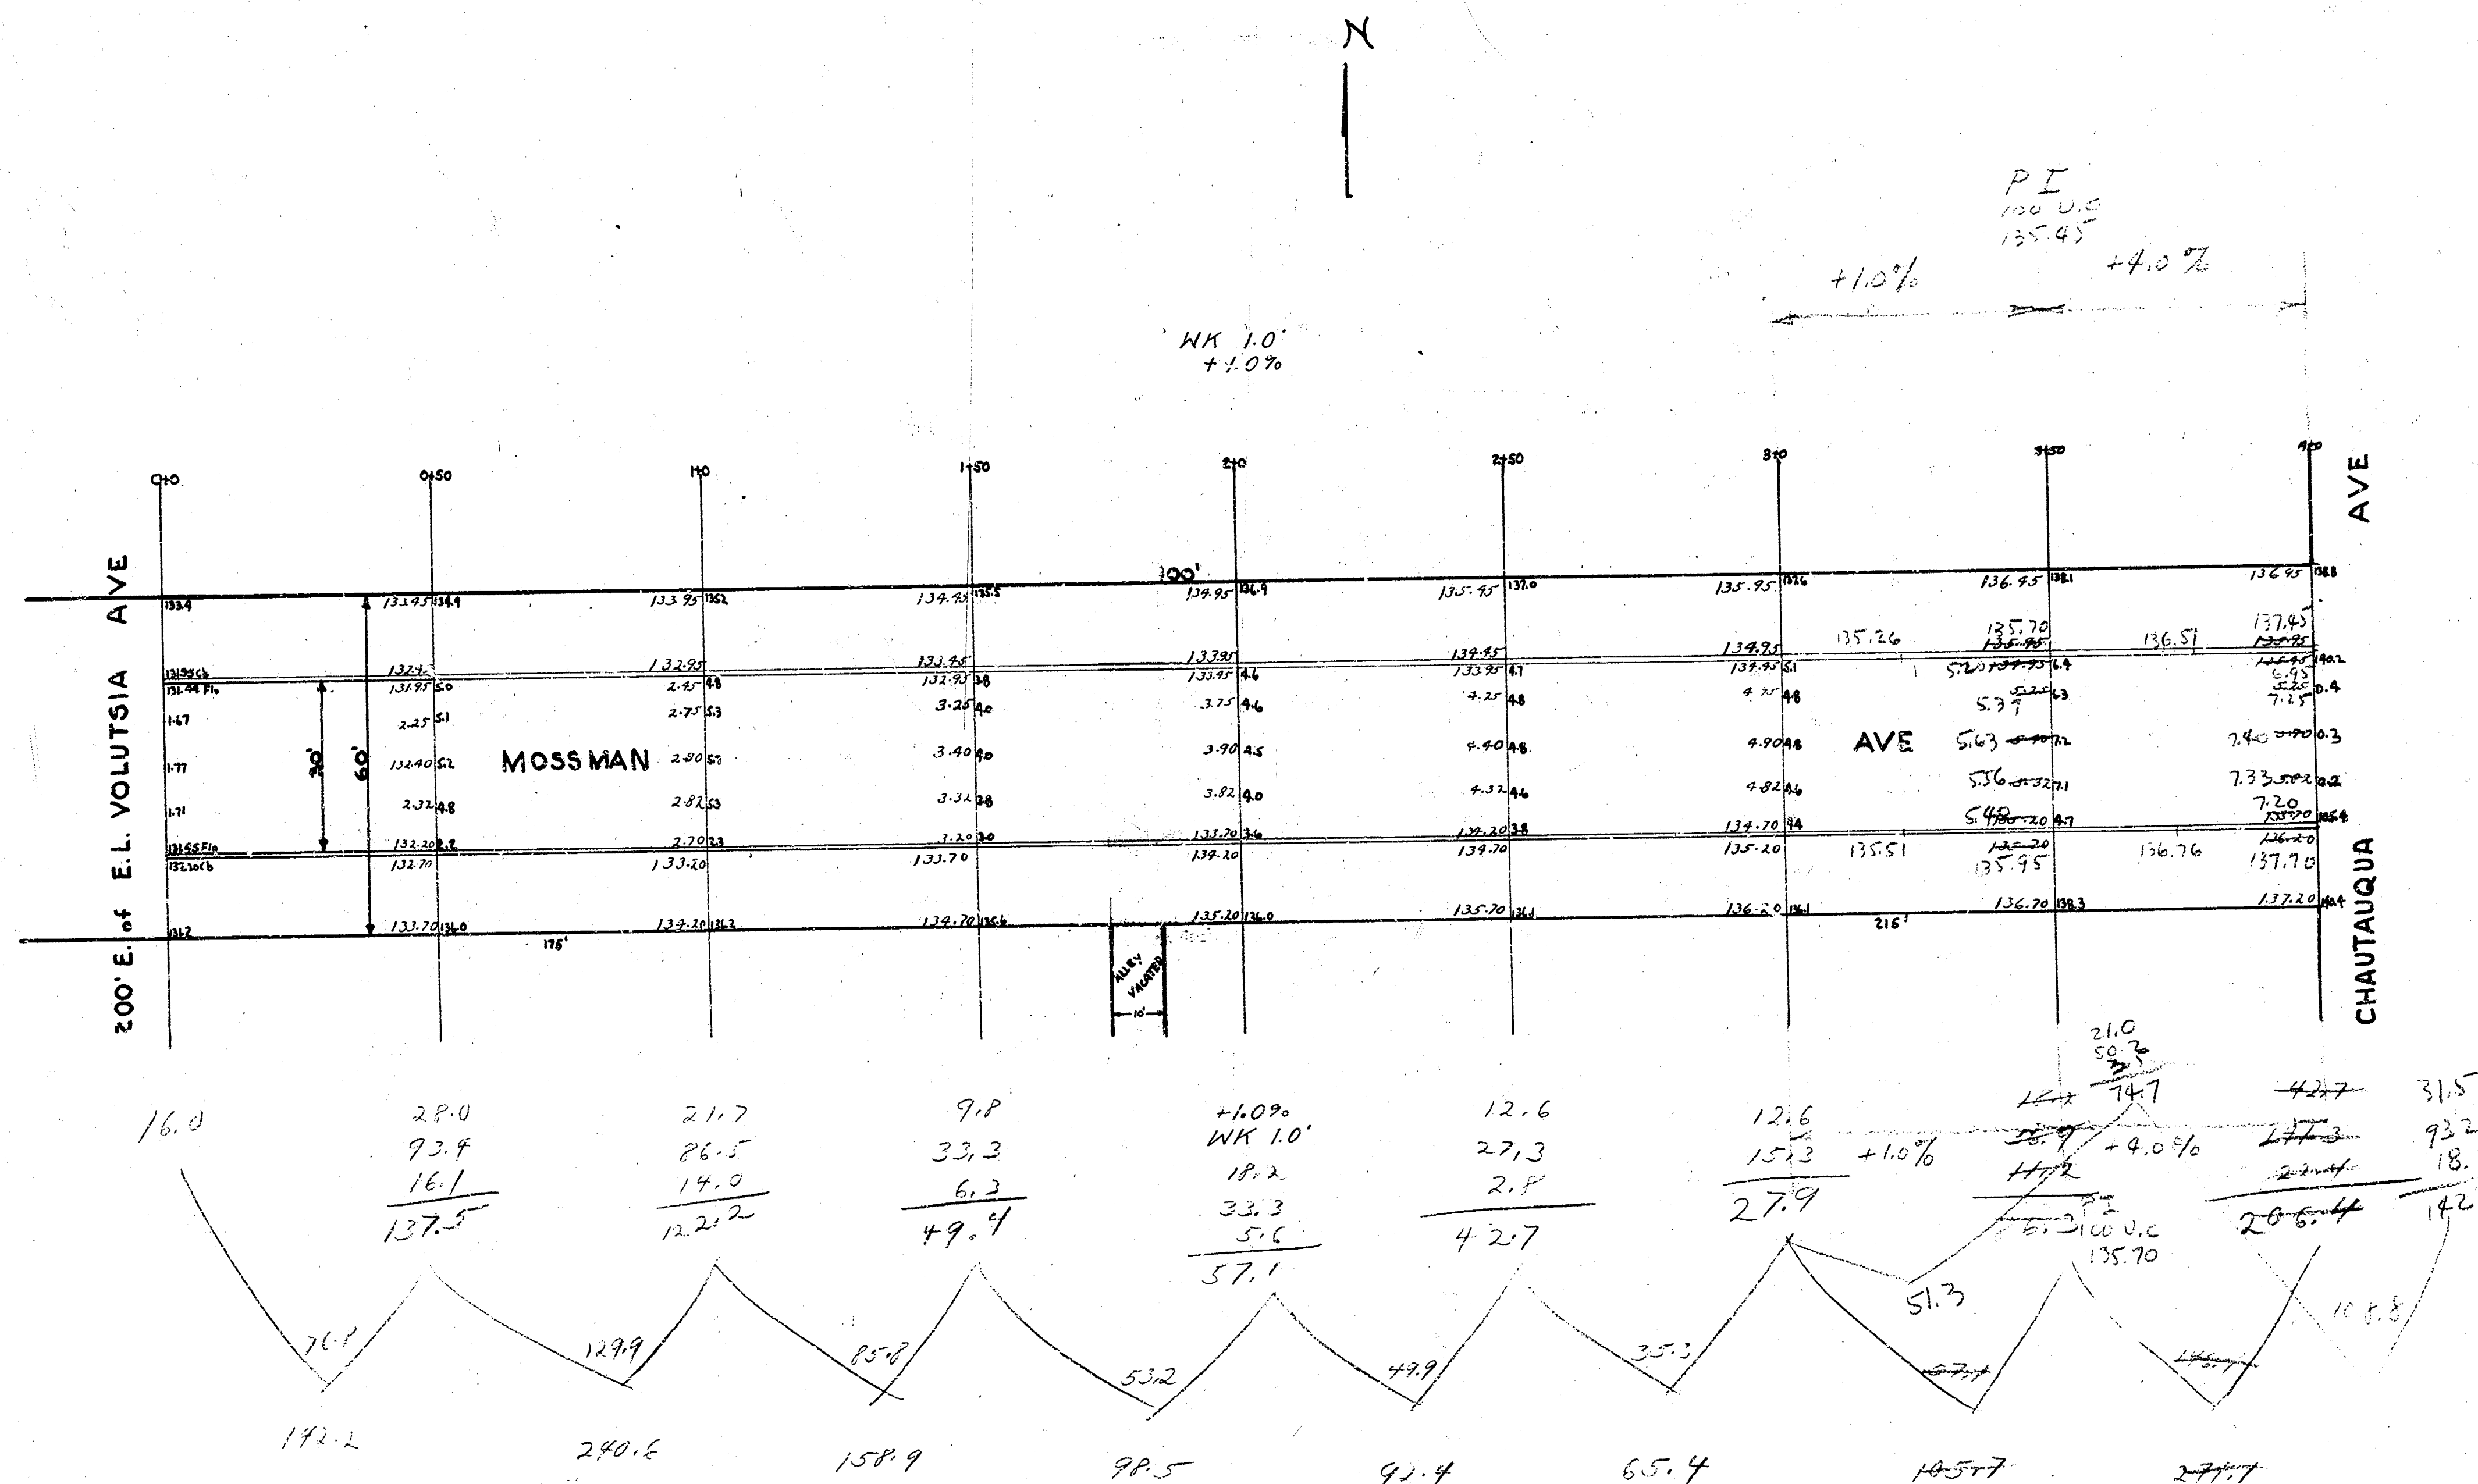

1174.8
 4103.0
 117.5
 1292.3

MOSSMAN AVE
 200' E. of E.L. VOLUTSIA TO W.L. CHAUTAUQUA
 30' CONCRETE & C.B.
 CITY OF WICHITA, KANSAS
 L.K. WHITE CITY ENGINEER
 AUG. 1946