



26 Drives


STATIONING ON E

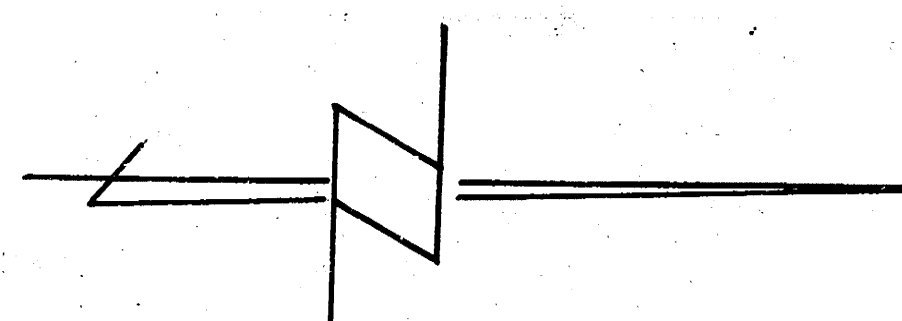

Change st gate to 0.6 mT side only

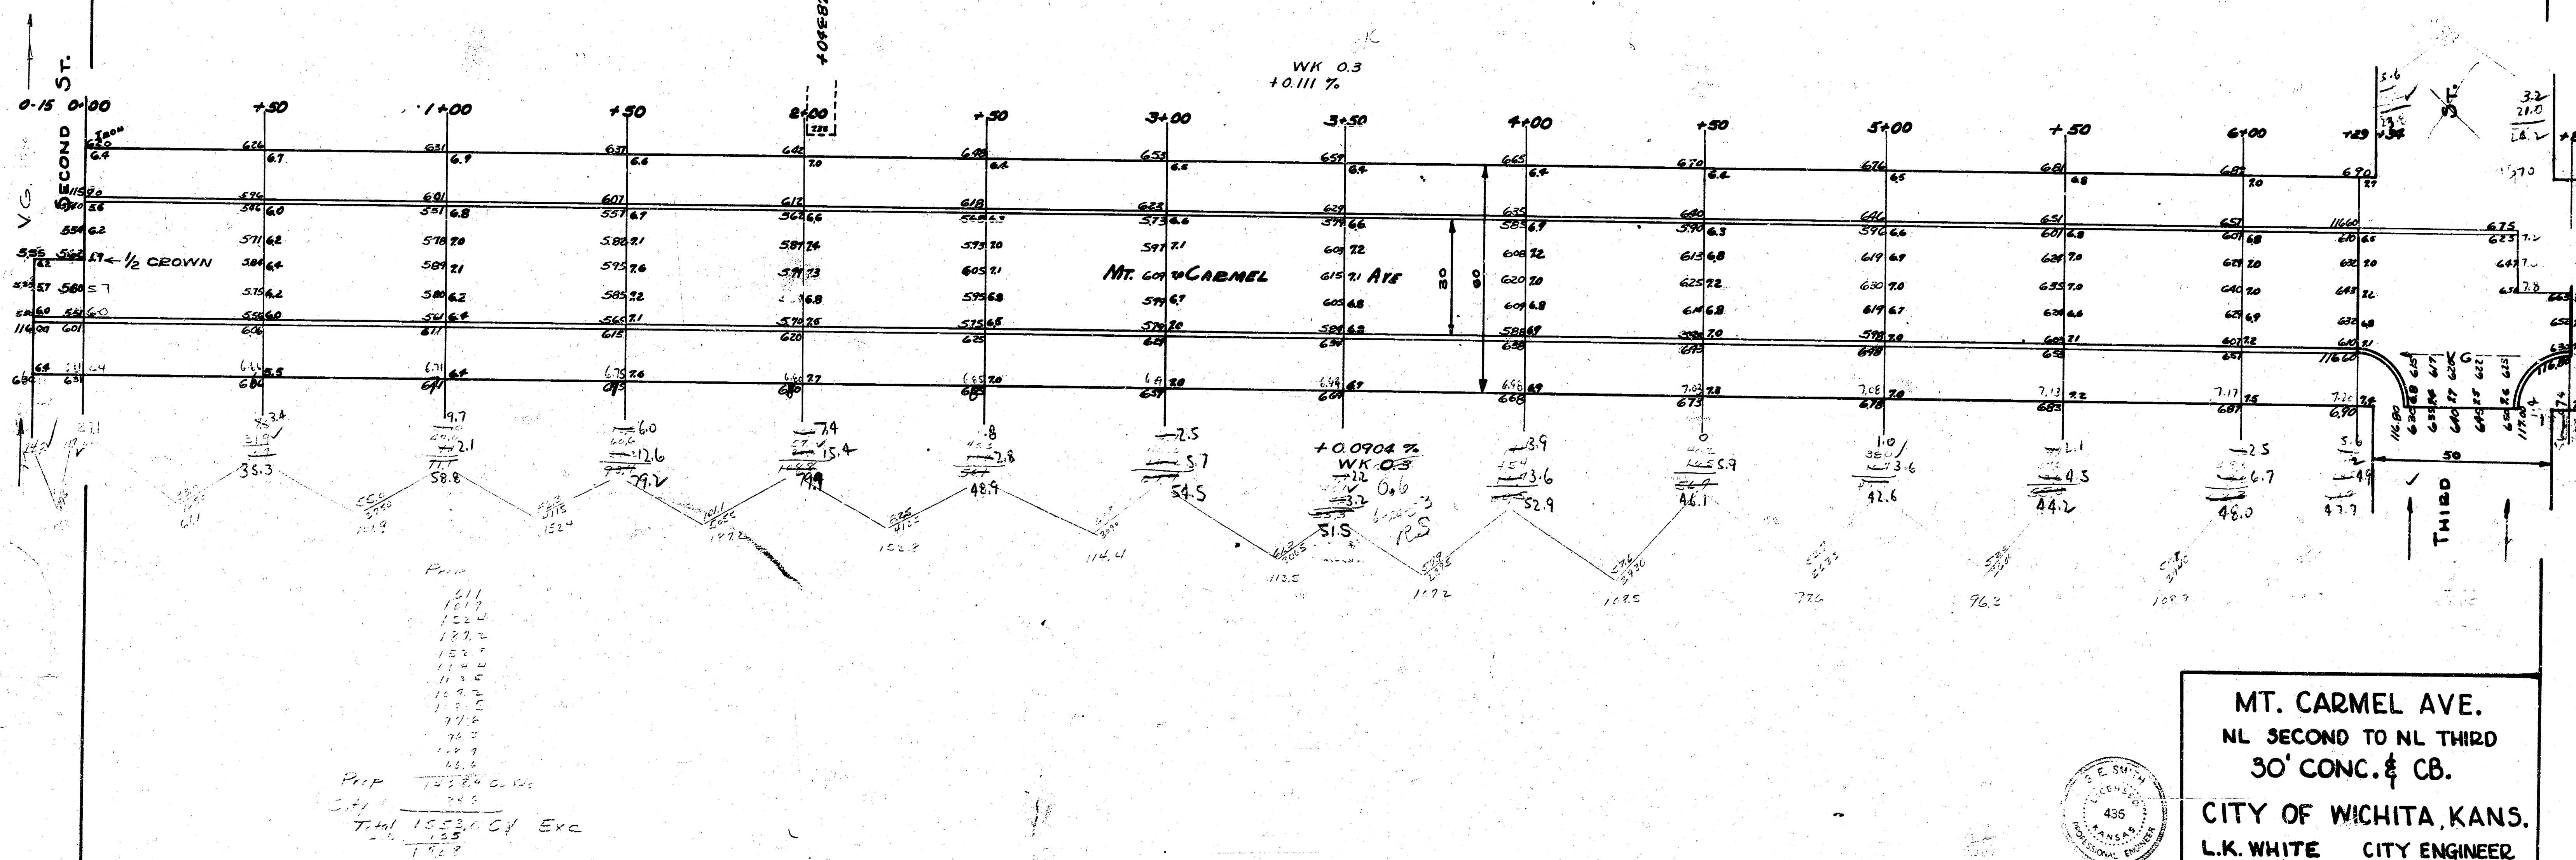

MT. CARMEL AVE.
NL SECOND TO NL THIRD
30' CONC. & CB.
CITY OF WICHITA, KANS.
L.K. WHITE CITY ENGINEER
JAN. 1952 PROJ. NO. C11-309

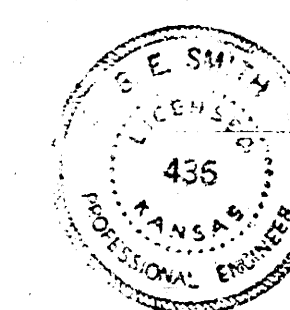

2 3 1 18