
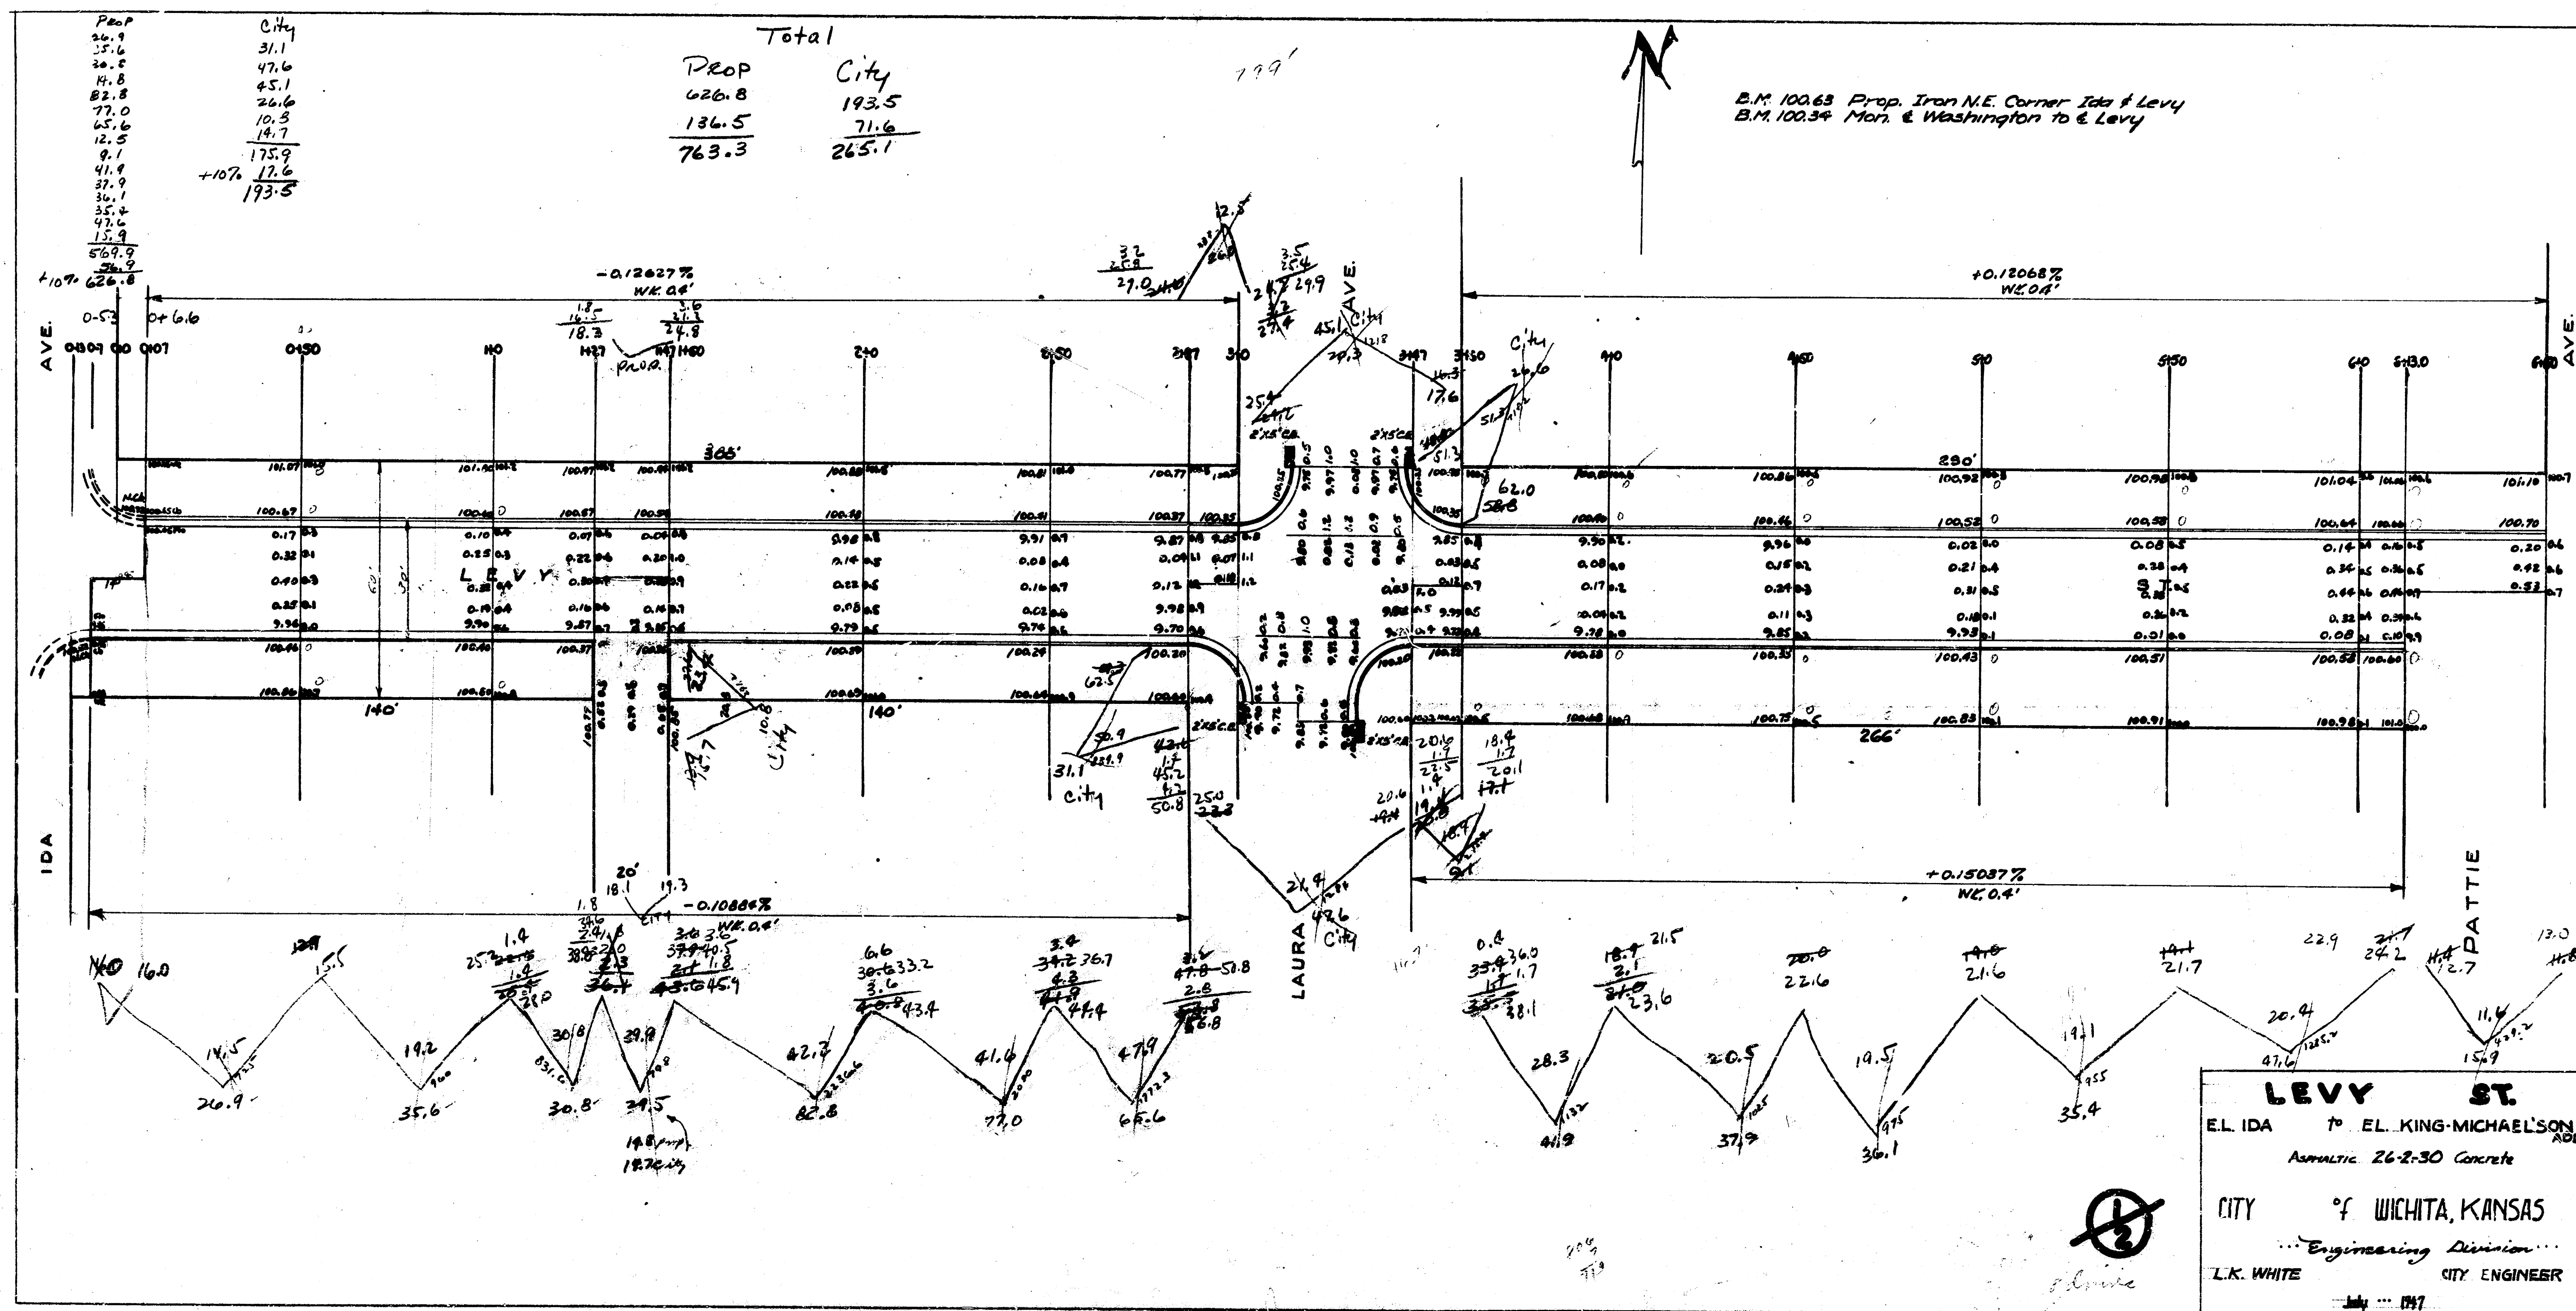


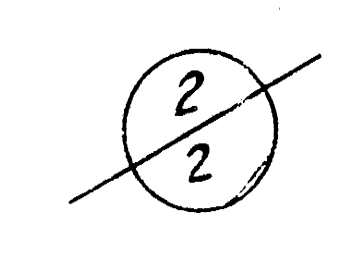


$$\begin{array}{r} \text{City} \\ 7.7 \\ 17.5 \\ 14.7 \\ \hline 25.2 \\ \hline 65.1 \\ +10\% \quad 6.5 \\ \hline 71.6 \end{array}$$

152