


B.M. 106.45 Iron in thimble @ Glen & Munnell

Notes: E of Munnell West is 2.57' South of E Munnell East

Remove Valley Gutter & Return, Install to new grade using 10' Radius

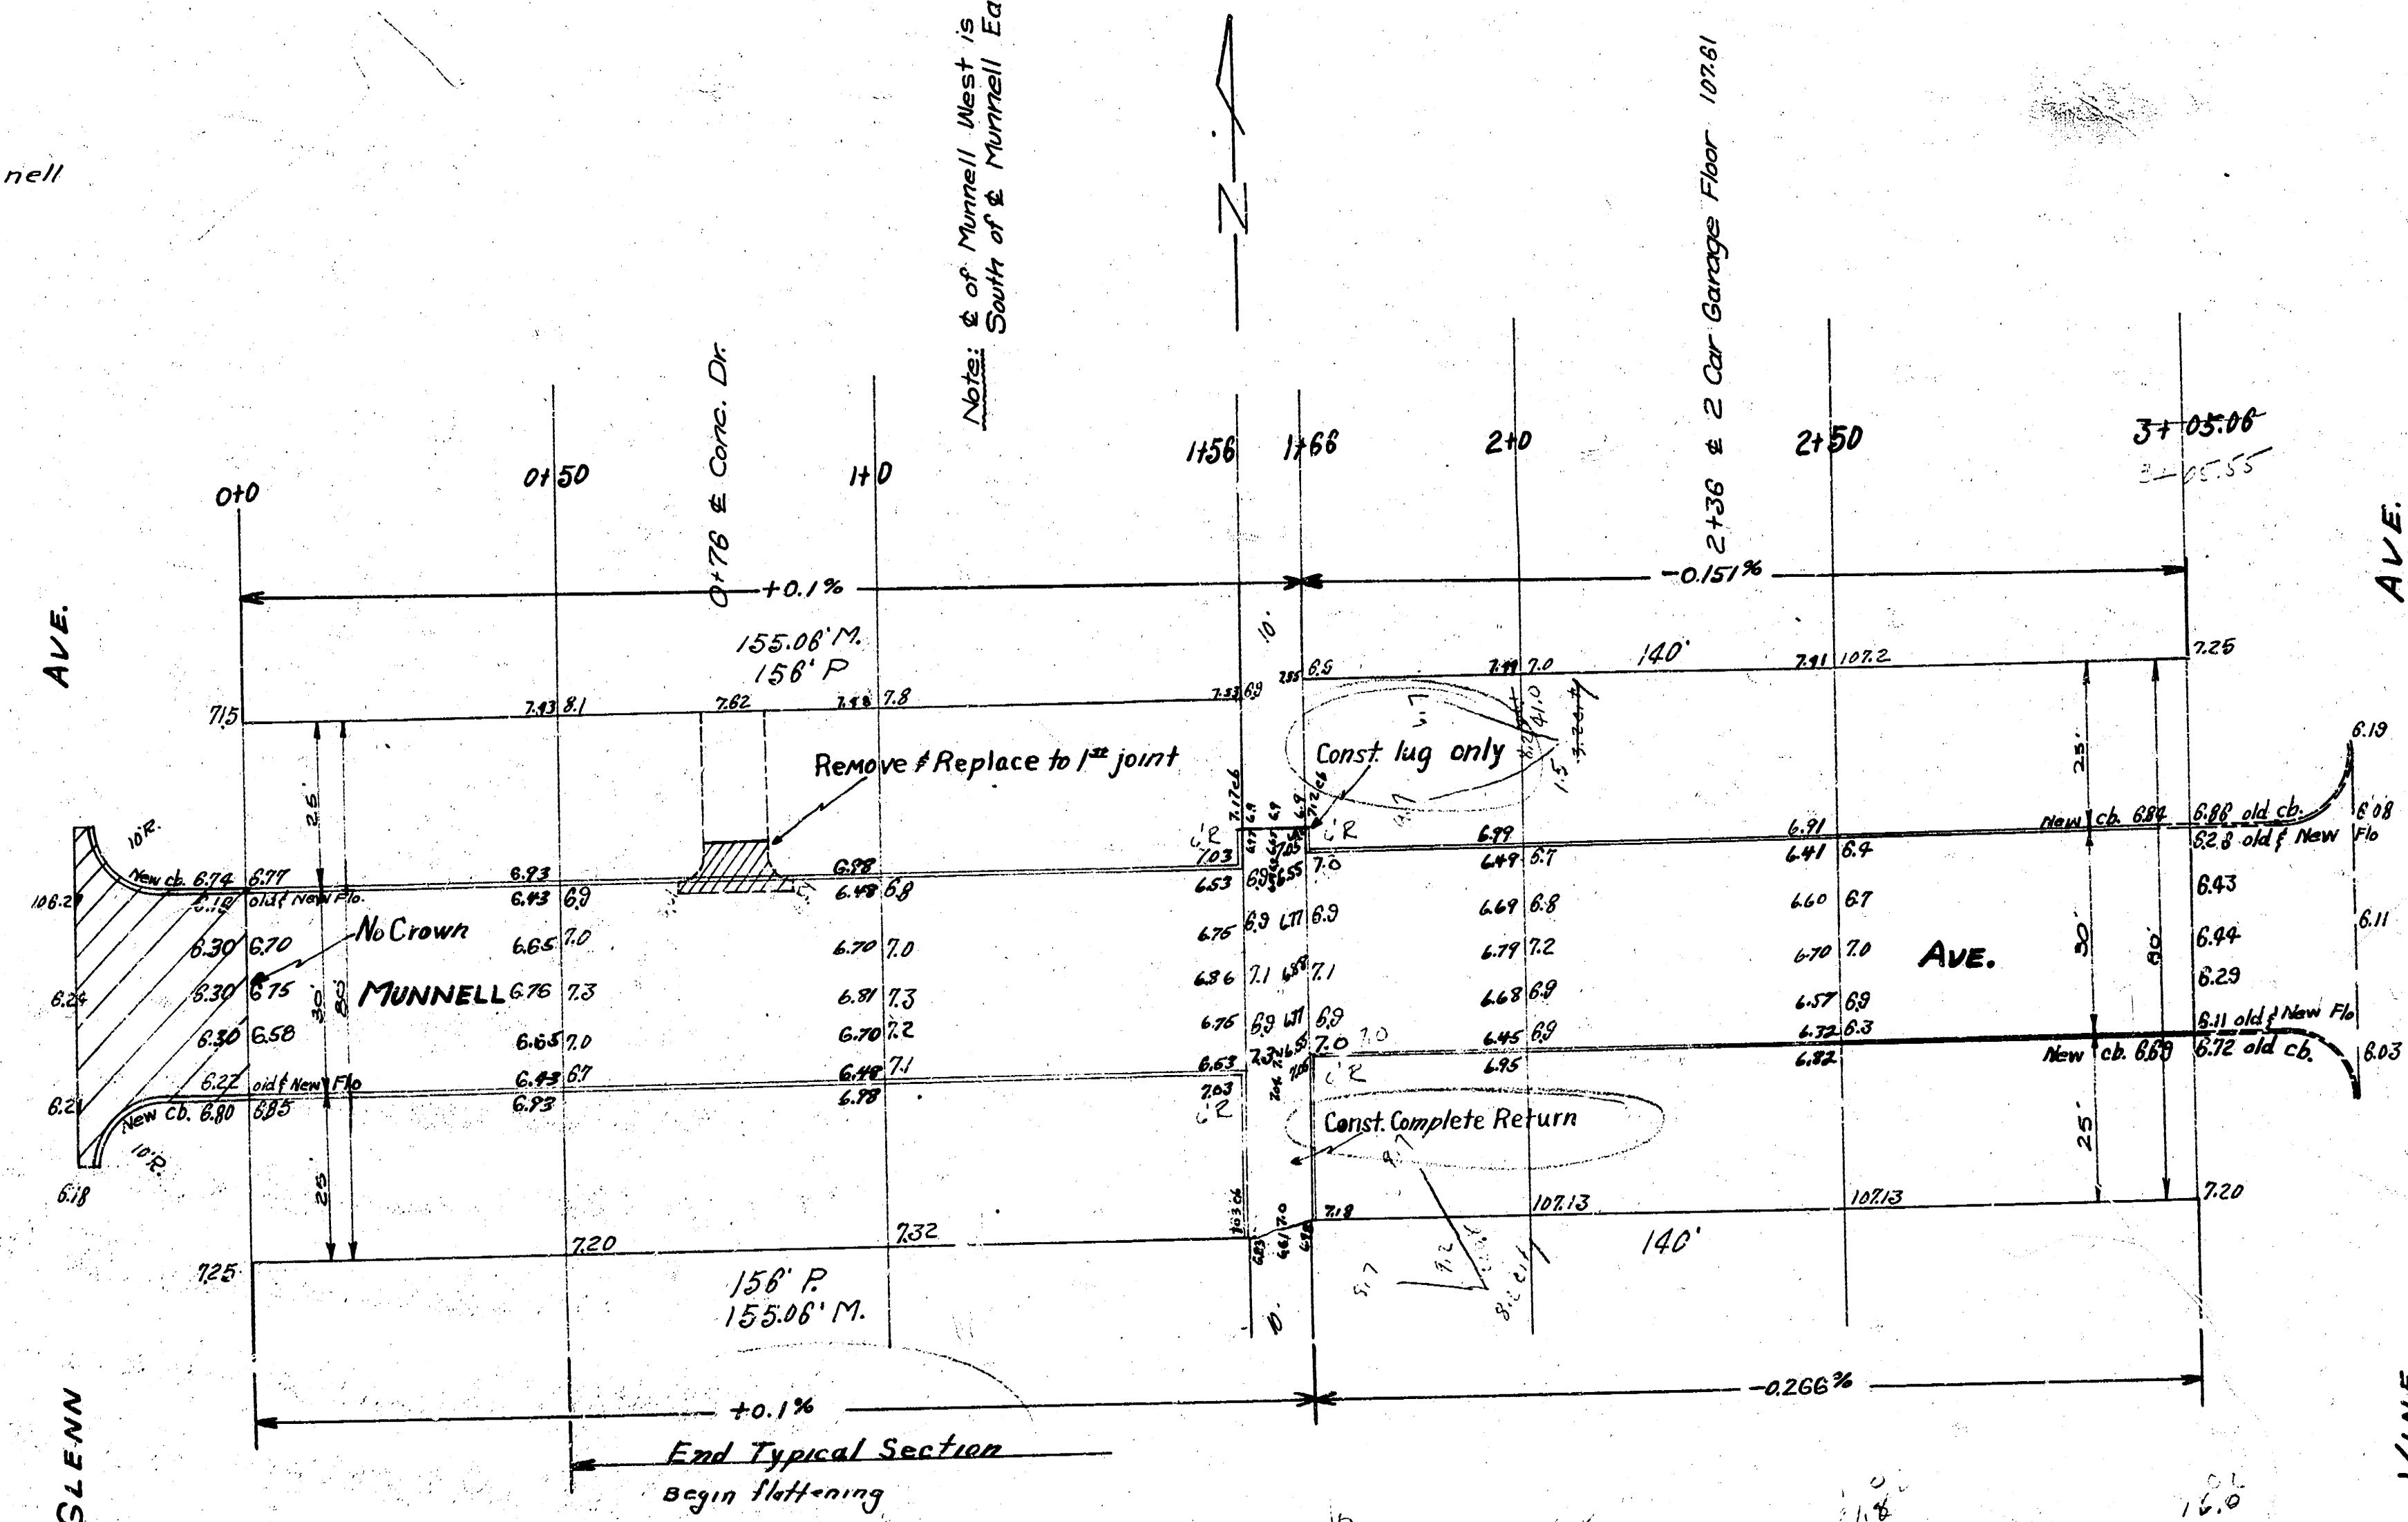

P.O.P.

58.3
64.7
33.2
43.0
34.2

304.3

110.7

22.5 + 24.5

E.T.Y.

5.2
9.2
7.0

20.4

110.8

22.9 + 24.5

TOTAL

336.9

354.3

24.5 + 24.5

MUNNELL AVE.
E.L. GLENN & W.L. VINE
30' CONC. & CB.
CITY OF WICHITA, KANSAS
L. K. WHITE CITY ENGINEER
MAY 1949 PROJ. NO. C19-77