



18-179-Y
SEALED
8-23-58
CHAS. J. JOHNSON

D.M. 128.07 RR SPIKE E.S. HLP. NW. OTT + LYNNURST
BASE LINE = 500' STREET R/W.

SCALE 1"=20'

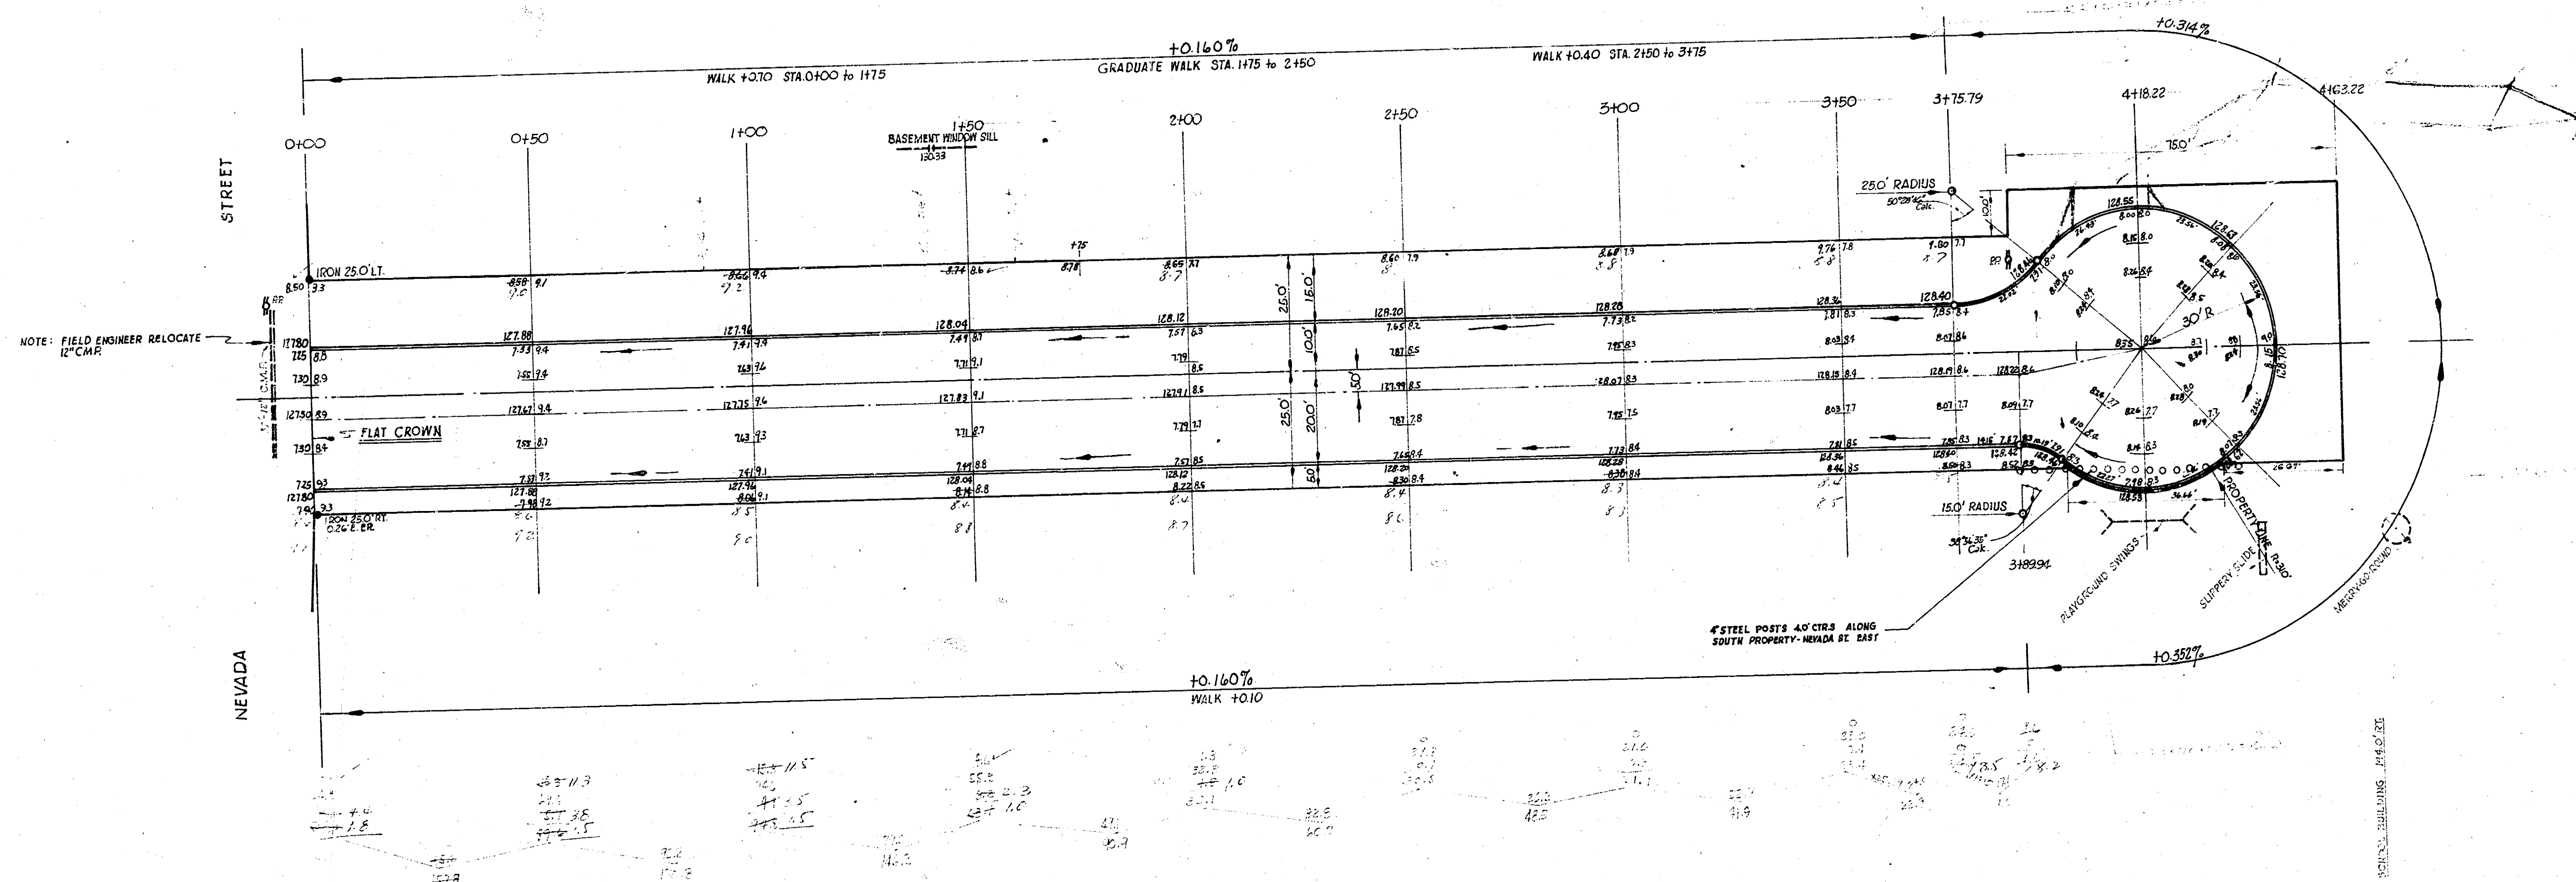

EXCAVATION TOTAL	
PROPERTY	CITY
72.0	0
+10% 78.6	
427.6 C.V.	0 C.V.

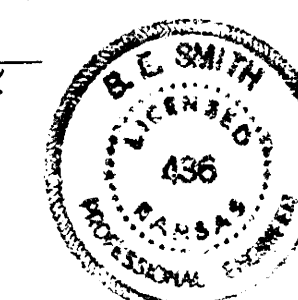

NEVADA COURT
EL. NEVADA STREET TO and INCLUDING CUL-DE-SAC
30' CONCRETE
CITY OF WICHITA, KANSAS
B.E. SMITH CITY ENGINEER
DATE: SEPT. 1958 PROJ. NO. C18-14A