



NEVADA STREET
N. L. Douglas Ave. to & incl. Cul-de-sac
Proj. No. DAKS 575127

TYPICAL SECTIONS OF 30' CONCRETE PAVEMENT

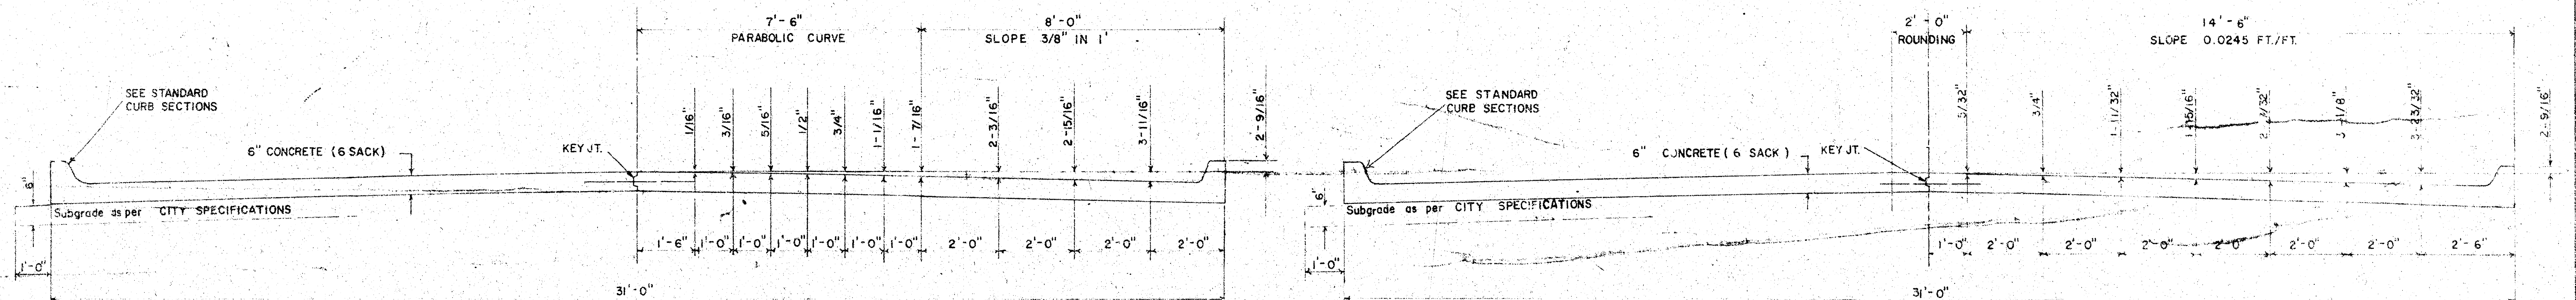


TYPICAL SECTION WITH STANDARD CROWN

TYPICAL SECTION WITH ALTERNATE CROWN

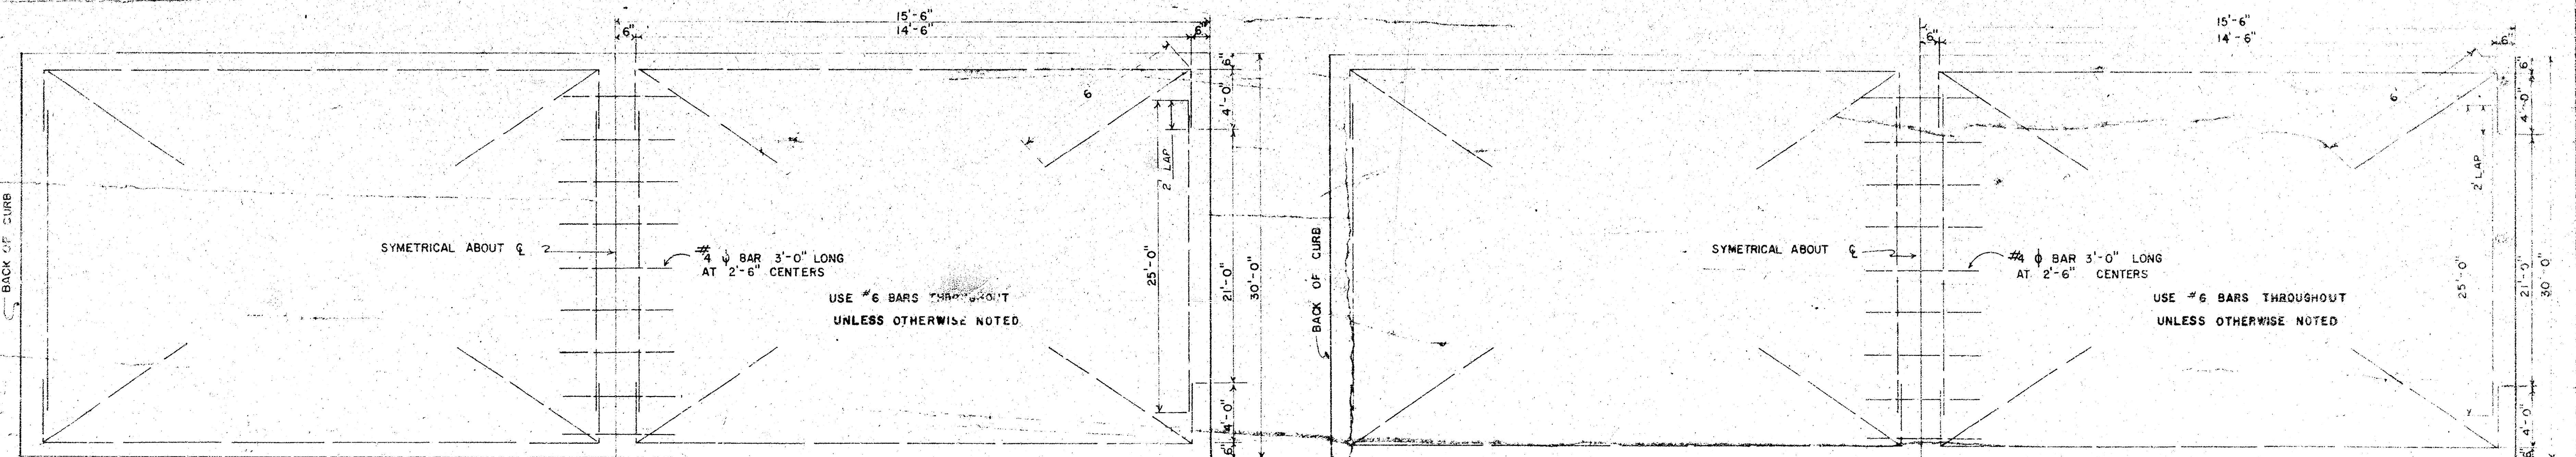


STEEL PATTERN


STEEL PATTERN

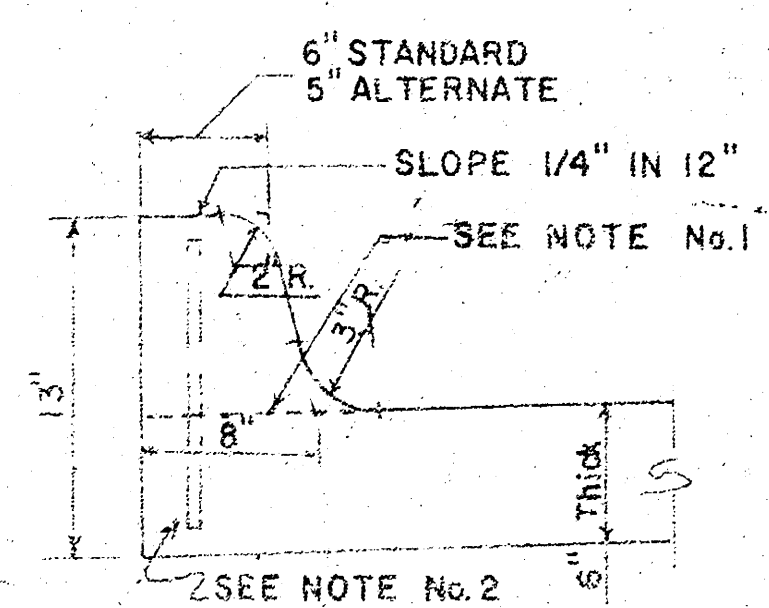


INTEGRAL CURB

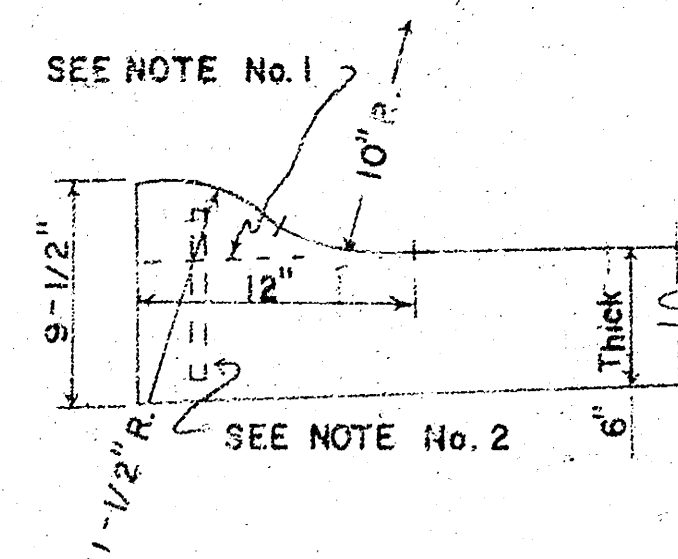

ROLL-TYPE

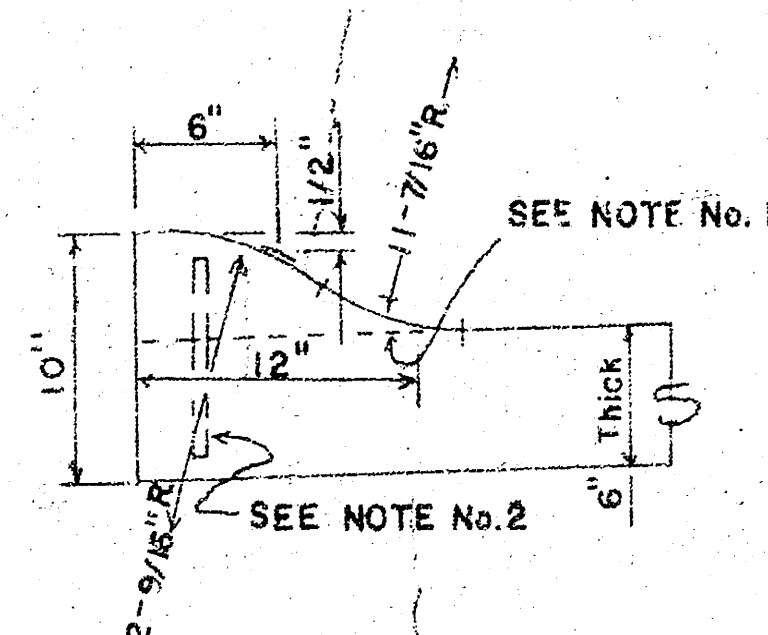

ALTERNATE ROLL-TYPE

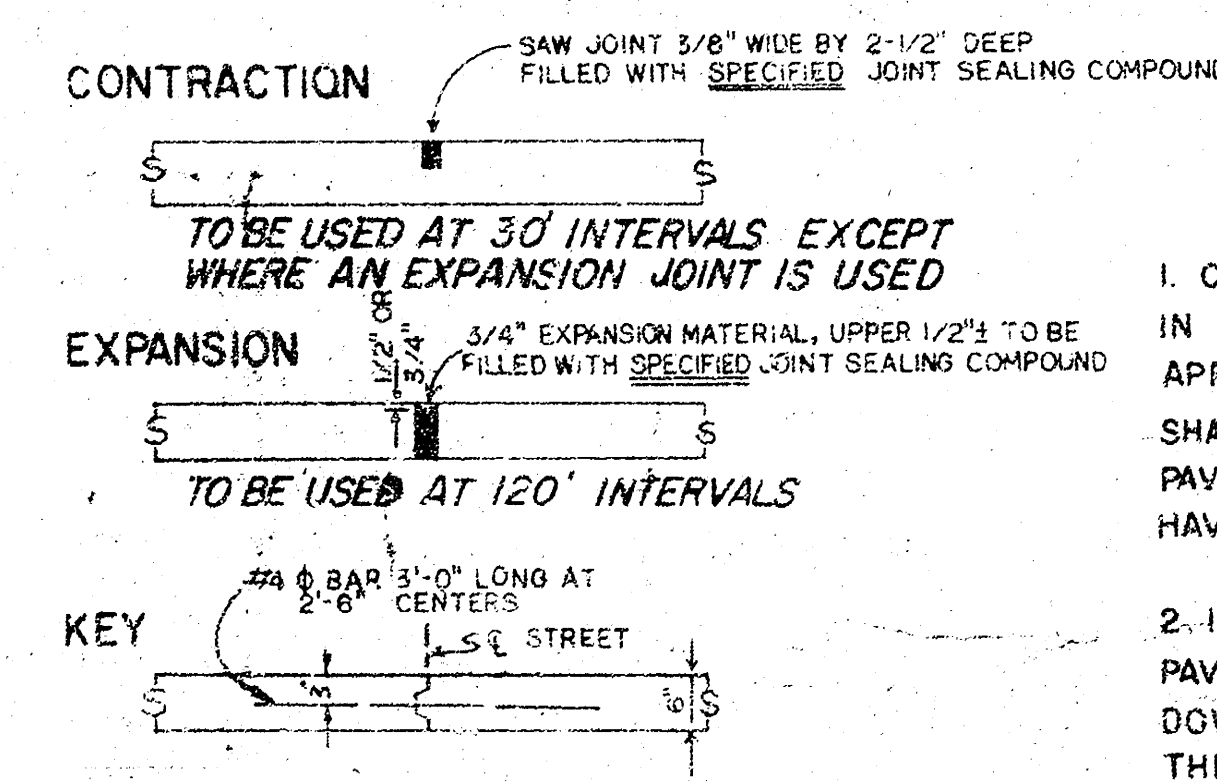

JOINT DETAILS


GENERAL NOTES

- CONTRACTION JOINTS MAY BE CONSTRUCTED IN INTEGRAL CURB BY SAWING WITH AN APPROVED CONCRETE SAW. THE SAW CUT SHALL EXTEND THROUGH THE CURB TO THE PAVEMENT. SAWED CONTRACTION JOINTS SHALL HAVE A MAXIMUM SPACING OF 10'.
- INTEGRAL CURB SHALL BE TIED TO THE PAVEMENT BASE WITH SHORT DEFORMED DOWEL BARS SPACED AT 2'-6" INTERVALS. THESE DOWEL BARS SHALL NOT BE LESS THAN 1/2" OR MORE THAN 3/4" IN DIAMETER.

CITY OF WICHITA, KANSAS
Department of Public Works Engineering Division
R.W. Linn City Engineer
Date: Project No. DAKS 575127

B.M. = 117.94 R.R. Spk. N. Side P. Pole @ S. Side Douglas, Approx. 100' E. of Nevada
Baseline is E.L. Nevada

NORTH
Scale: 1" = 20'

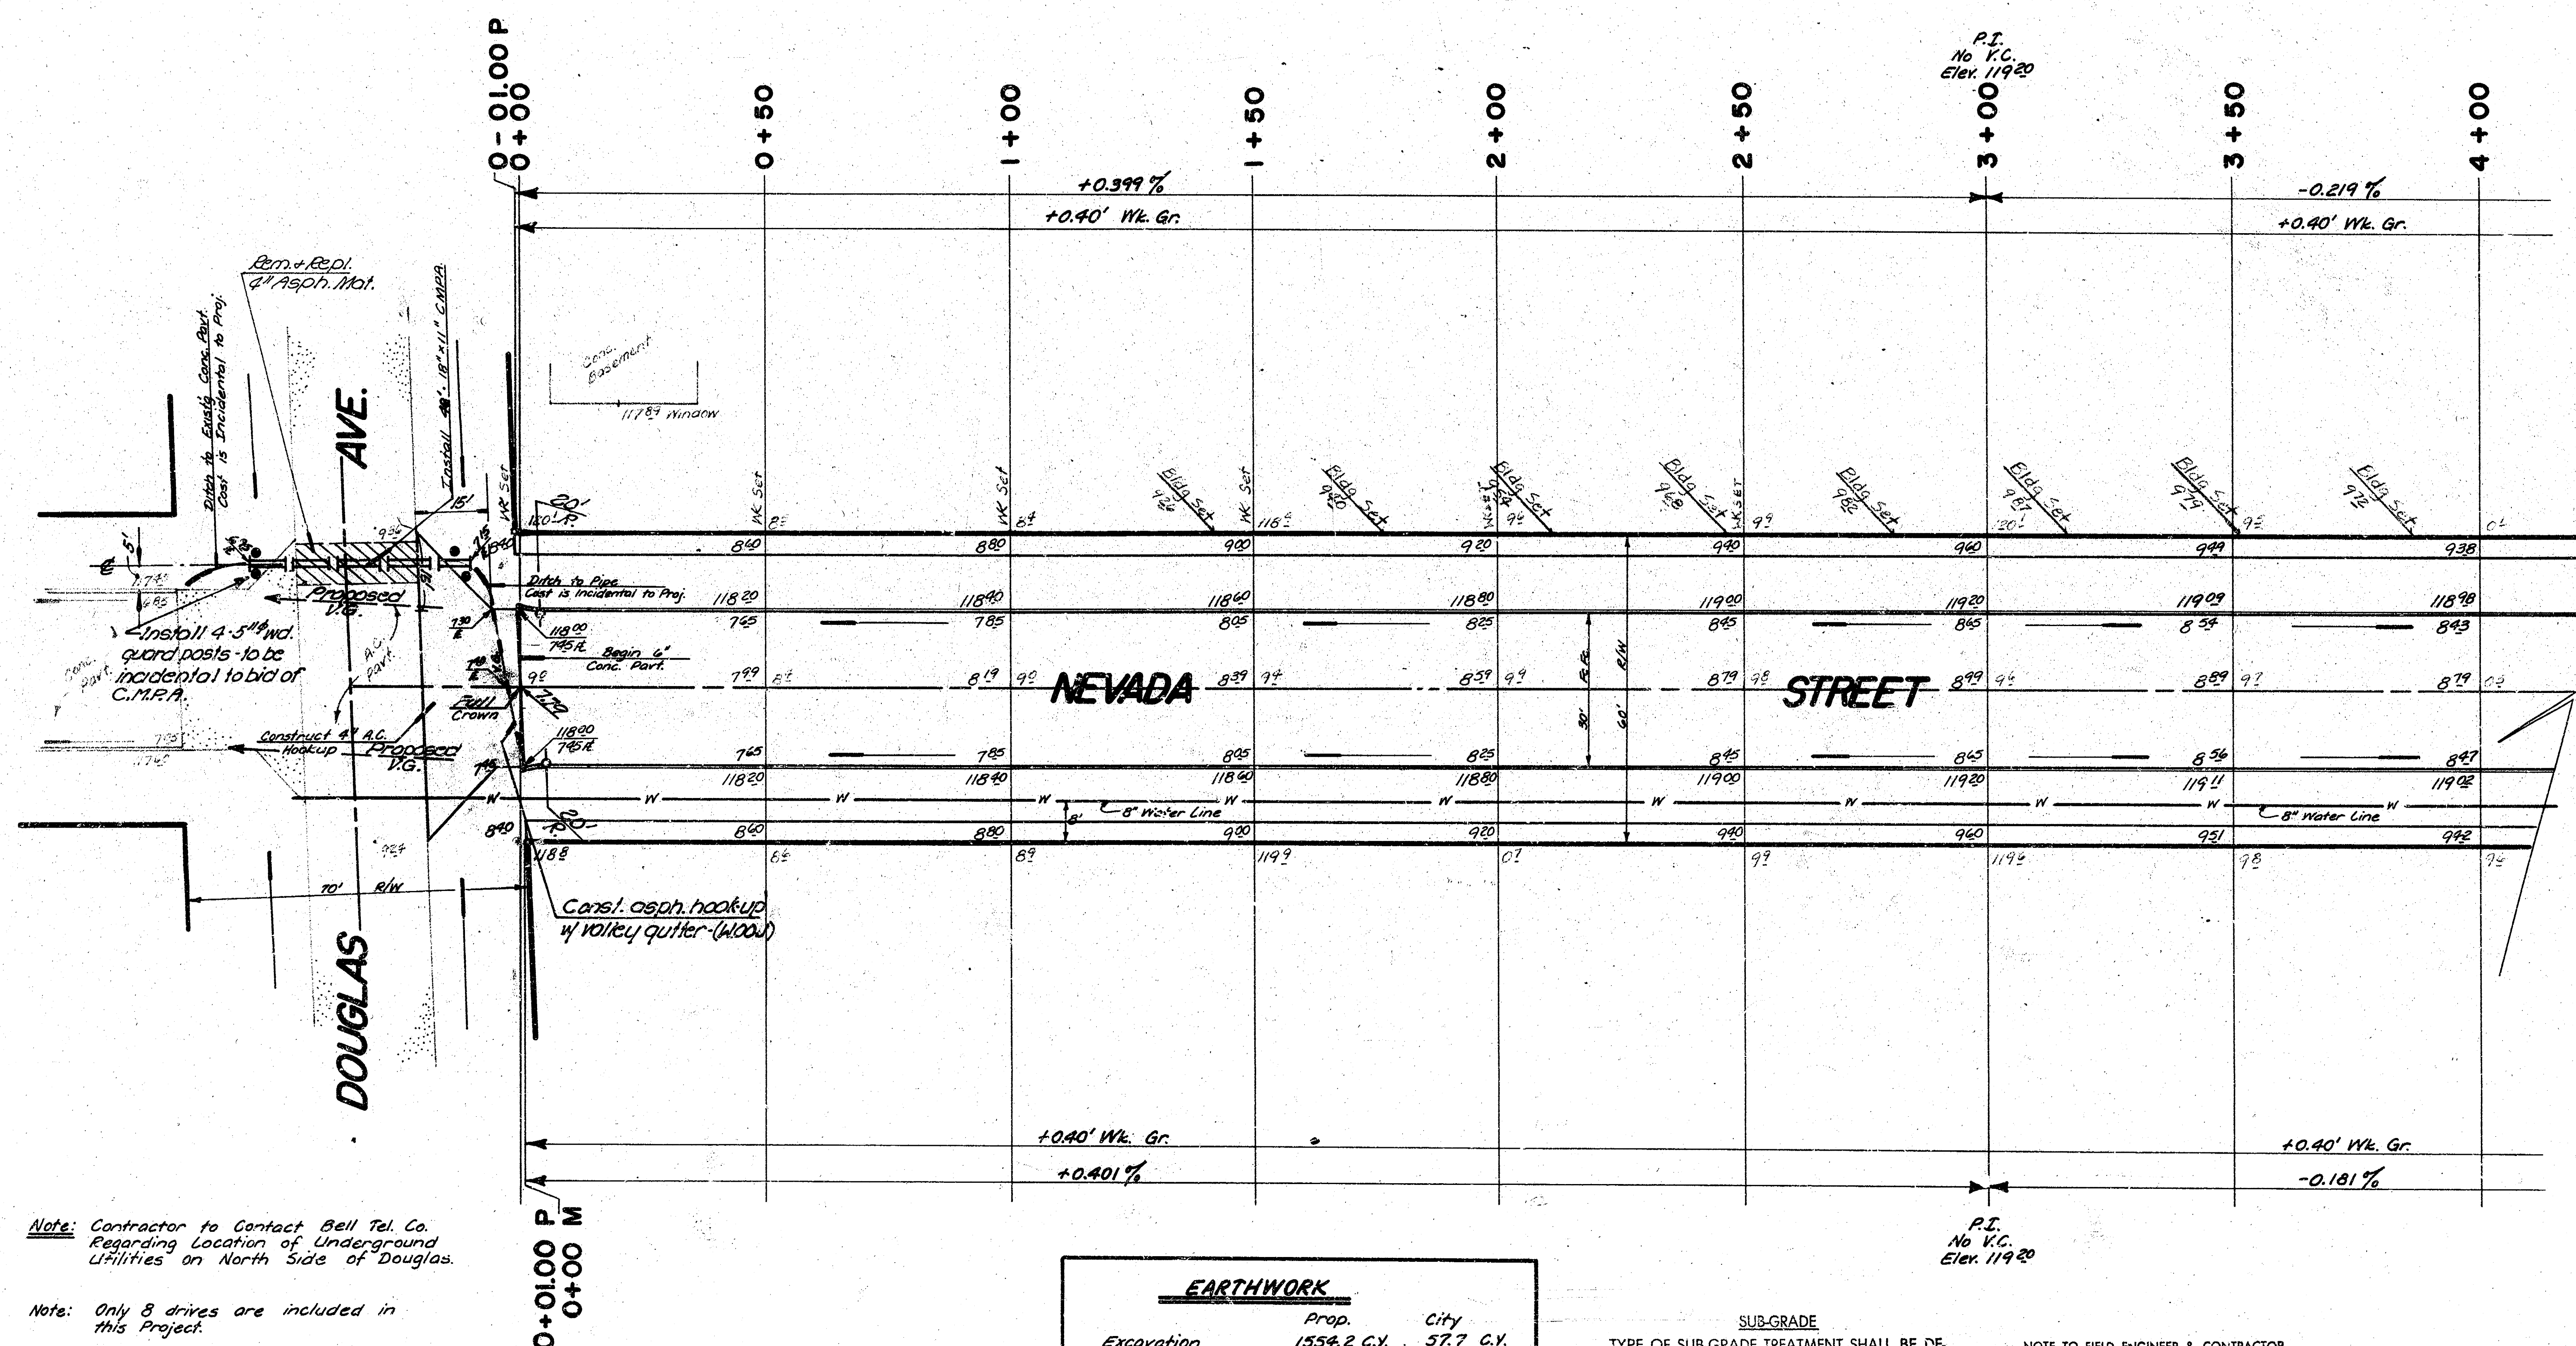

Note: Contractor to Contact Bell Tel. Co. Regarding Location of Underground Utilities on North Side of Douglas.


Note: Only 8 drives are included in this Project.

EARTHWORK			
	Prop.	City	
Excavation	1554.2 C.Y.	57.7 C.Y.	
+10%	155.4 C.Y.	5.8 C.Y.	
Total	1709.6 C.Y.	63.5 C.Y.	
Compacted Fill	5.9 C.Y.		
+10%	0.6 C.Y.		
Total	6.5 C.Y.		
Manipulation = 2506.3 S.Y.			

SUB-GRADE
TYPE OF SUB-GRADE TREATMENT SHALL BE DETERMINED BY THE FIELD ENGINEER. SUB-GRADE TREATMENT MAY CONSIST OF LIME TREATMENT, CEMENT TREATMENT, SUB-GRADE MODIFICATION, OR ANY COMBINATION OF THESE.

NOTE TO FIELD ENGINEER & CONTRACTOR
Grade parking and clear right-of-way for proposed sidewalk. Compact fill in sidewalk area. TO BE CONSTRUCTED BY "OTHERS".

NEVADA STREET
N.L. Douglas to & Incl. Cul-De-Sac
(30' Fc-Fc, 6" Conc. Pavt. w/ Integral Curb.)
CITY of WICHITA, KANSAS
R.W. Linn — City Engineer
Proj. No. DAKS575127
Date _____


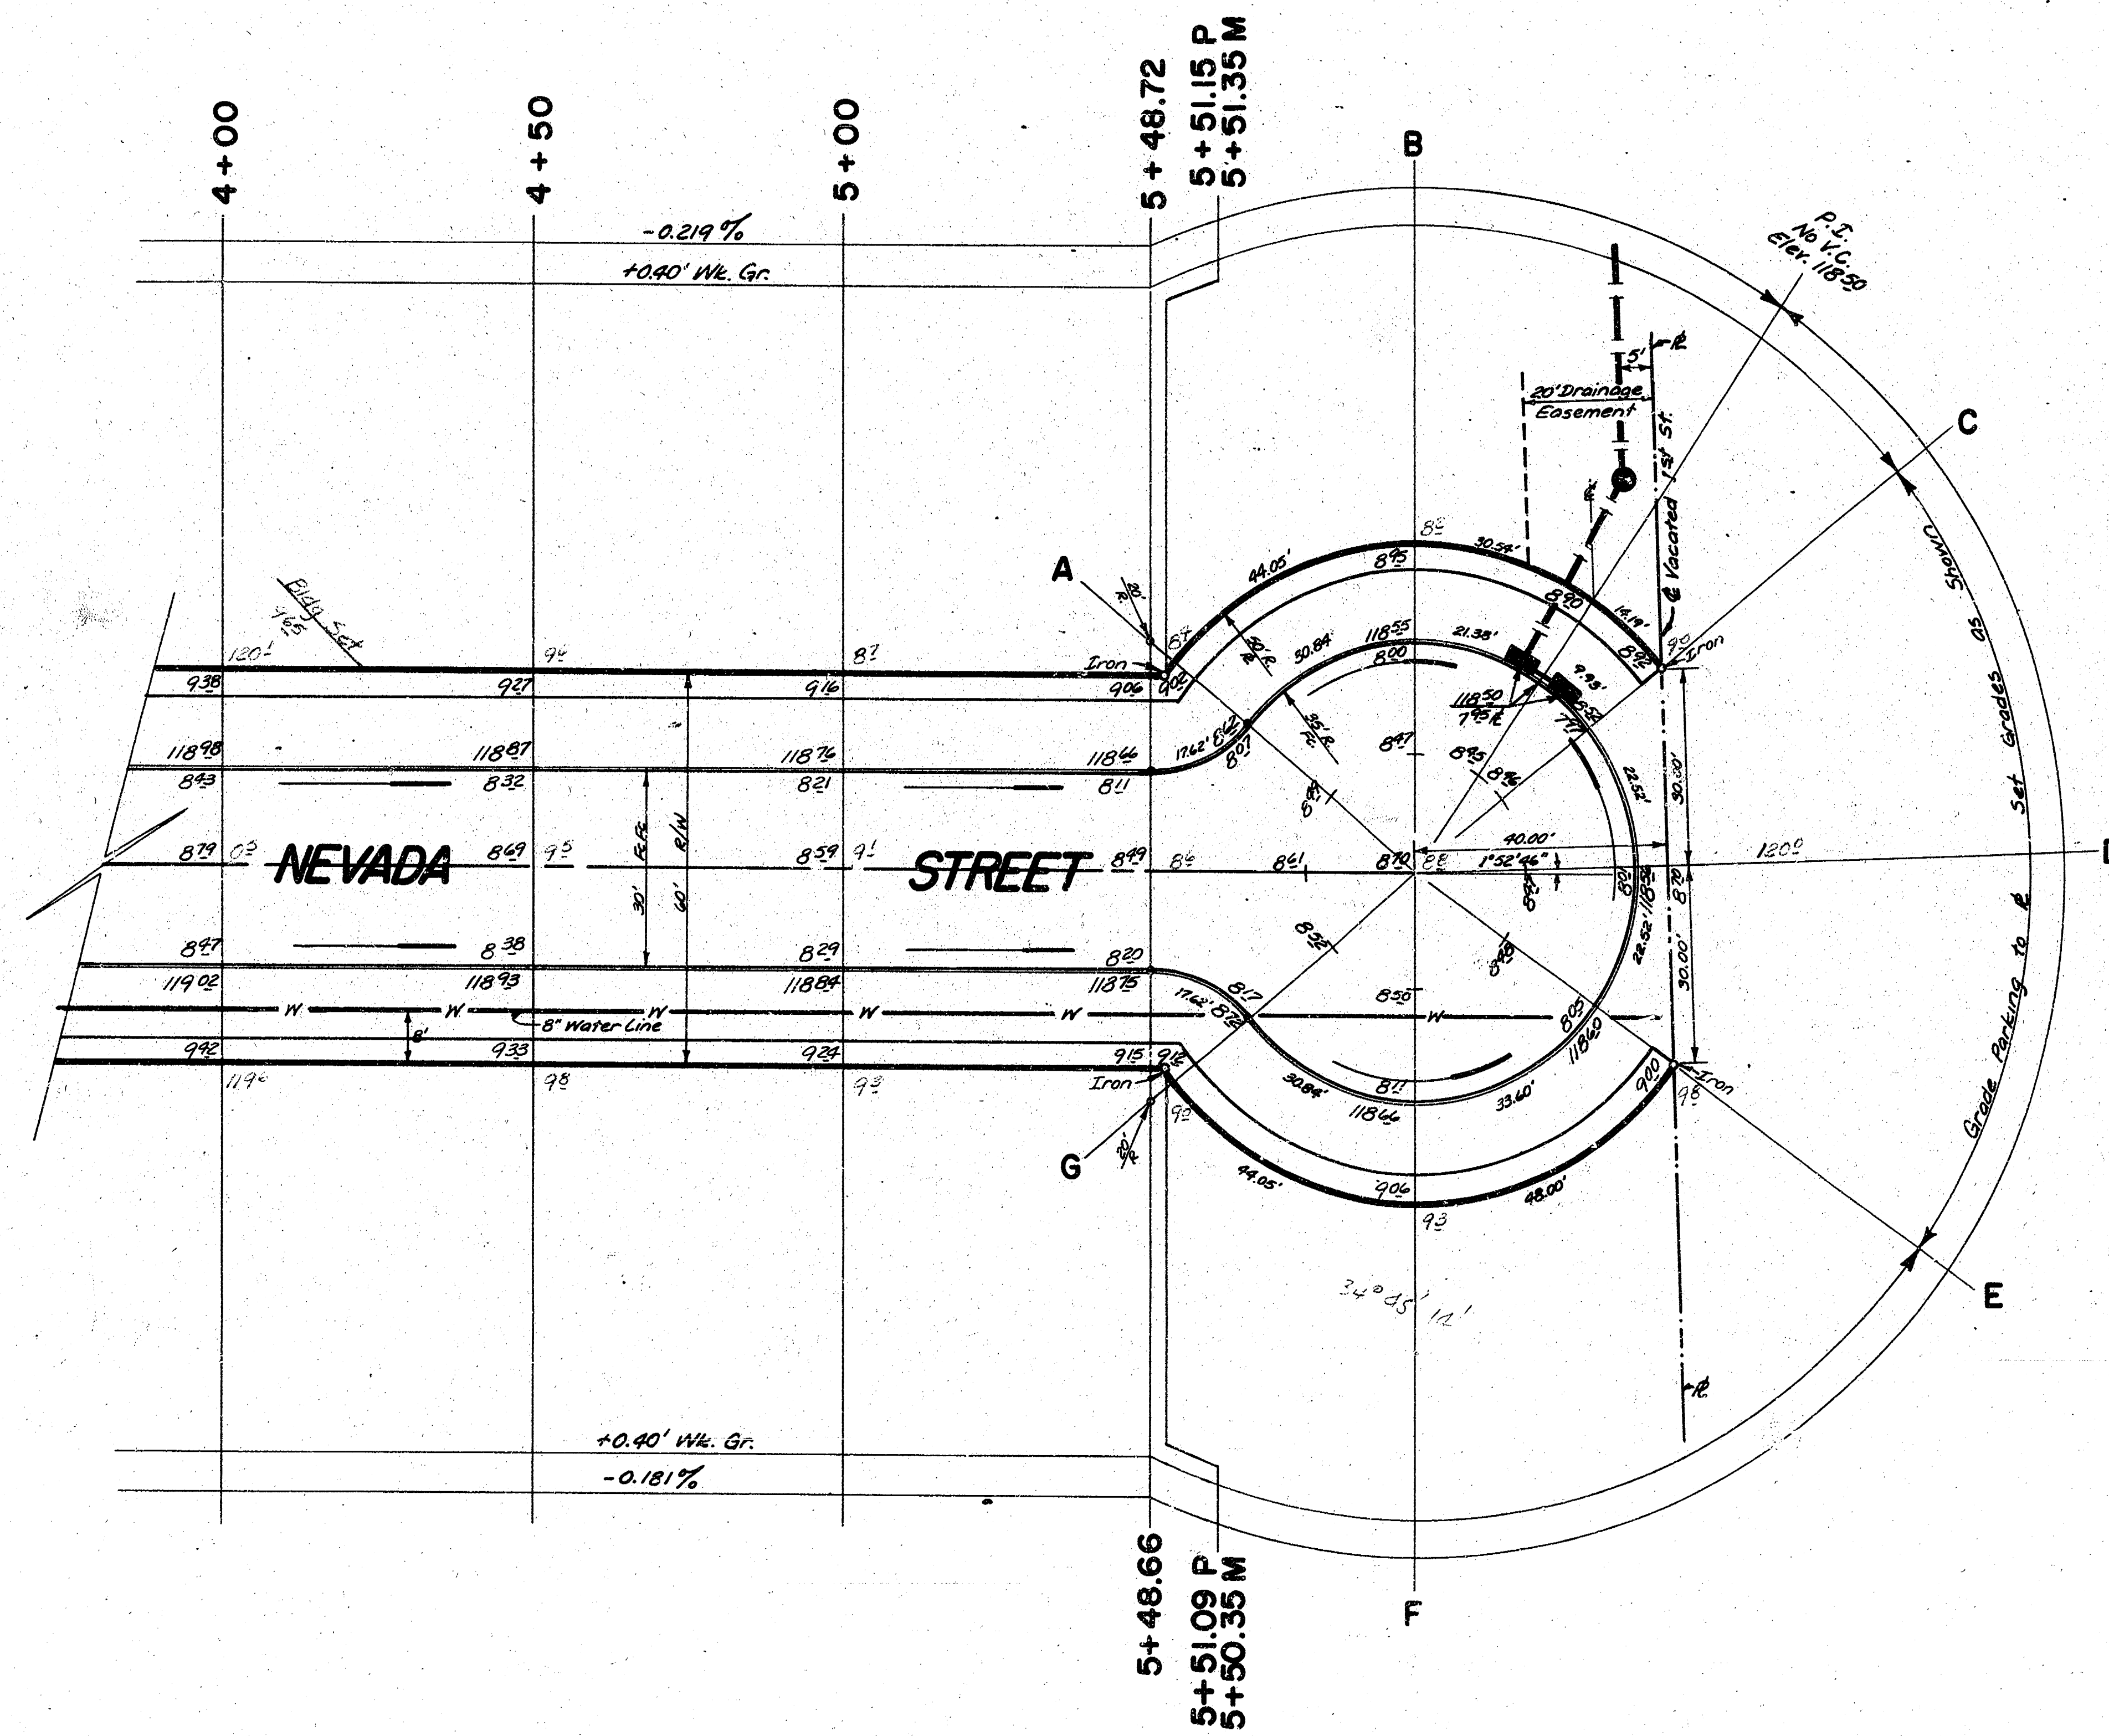


NORTH
Scale: 1" = 20'

B.M. = 117.94 R.R. Spk. N.S. RR S. Side Douglas, Approx. 100' E. of Nevada

SCALE:
Plan: 1" = 20'
Profile: 1" = 20' Horiz.
1" = 2' Vert.

NORTH

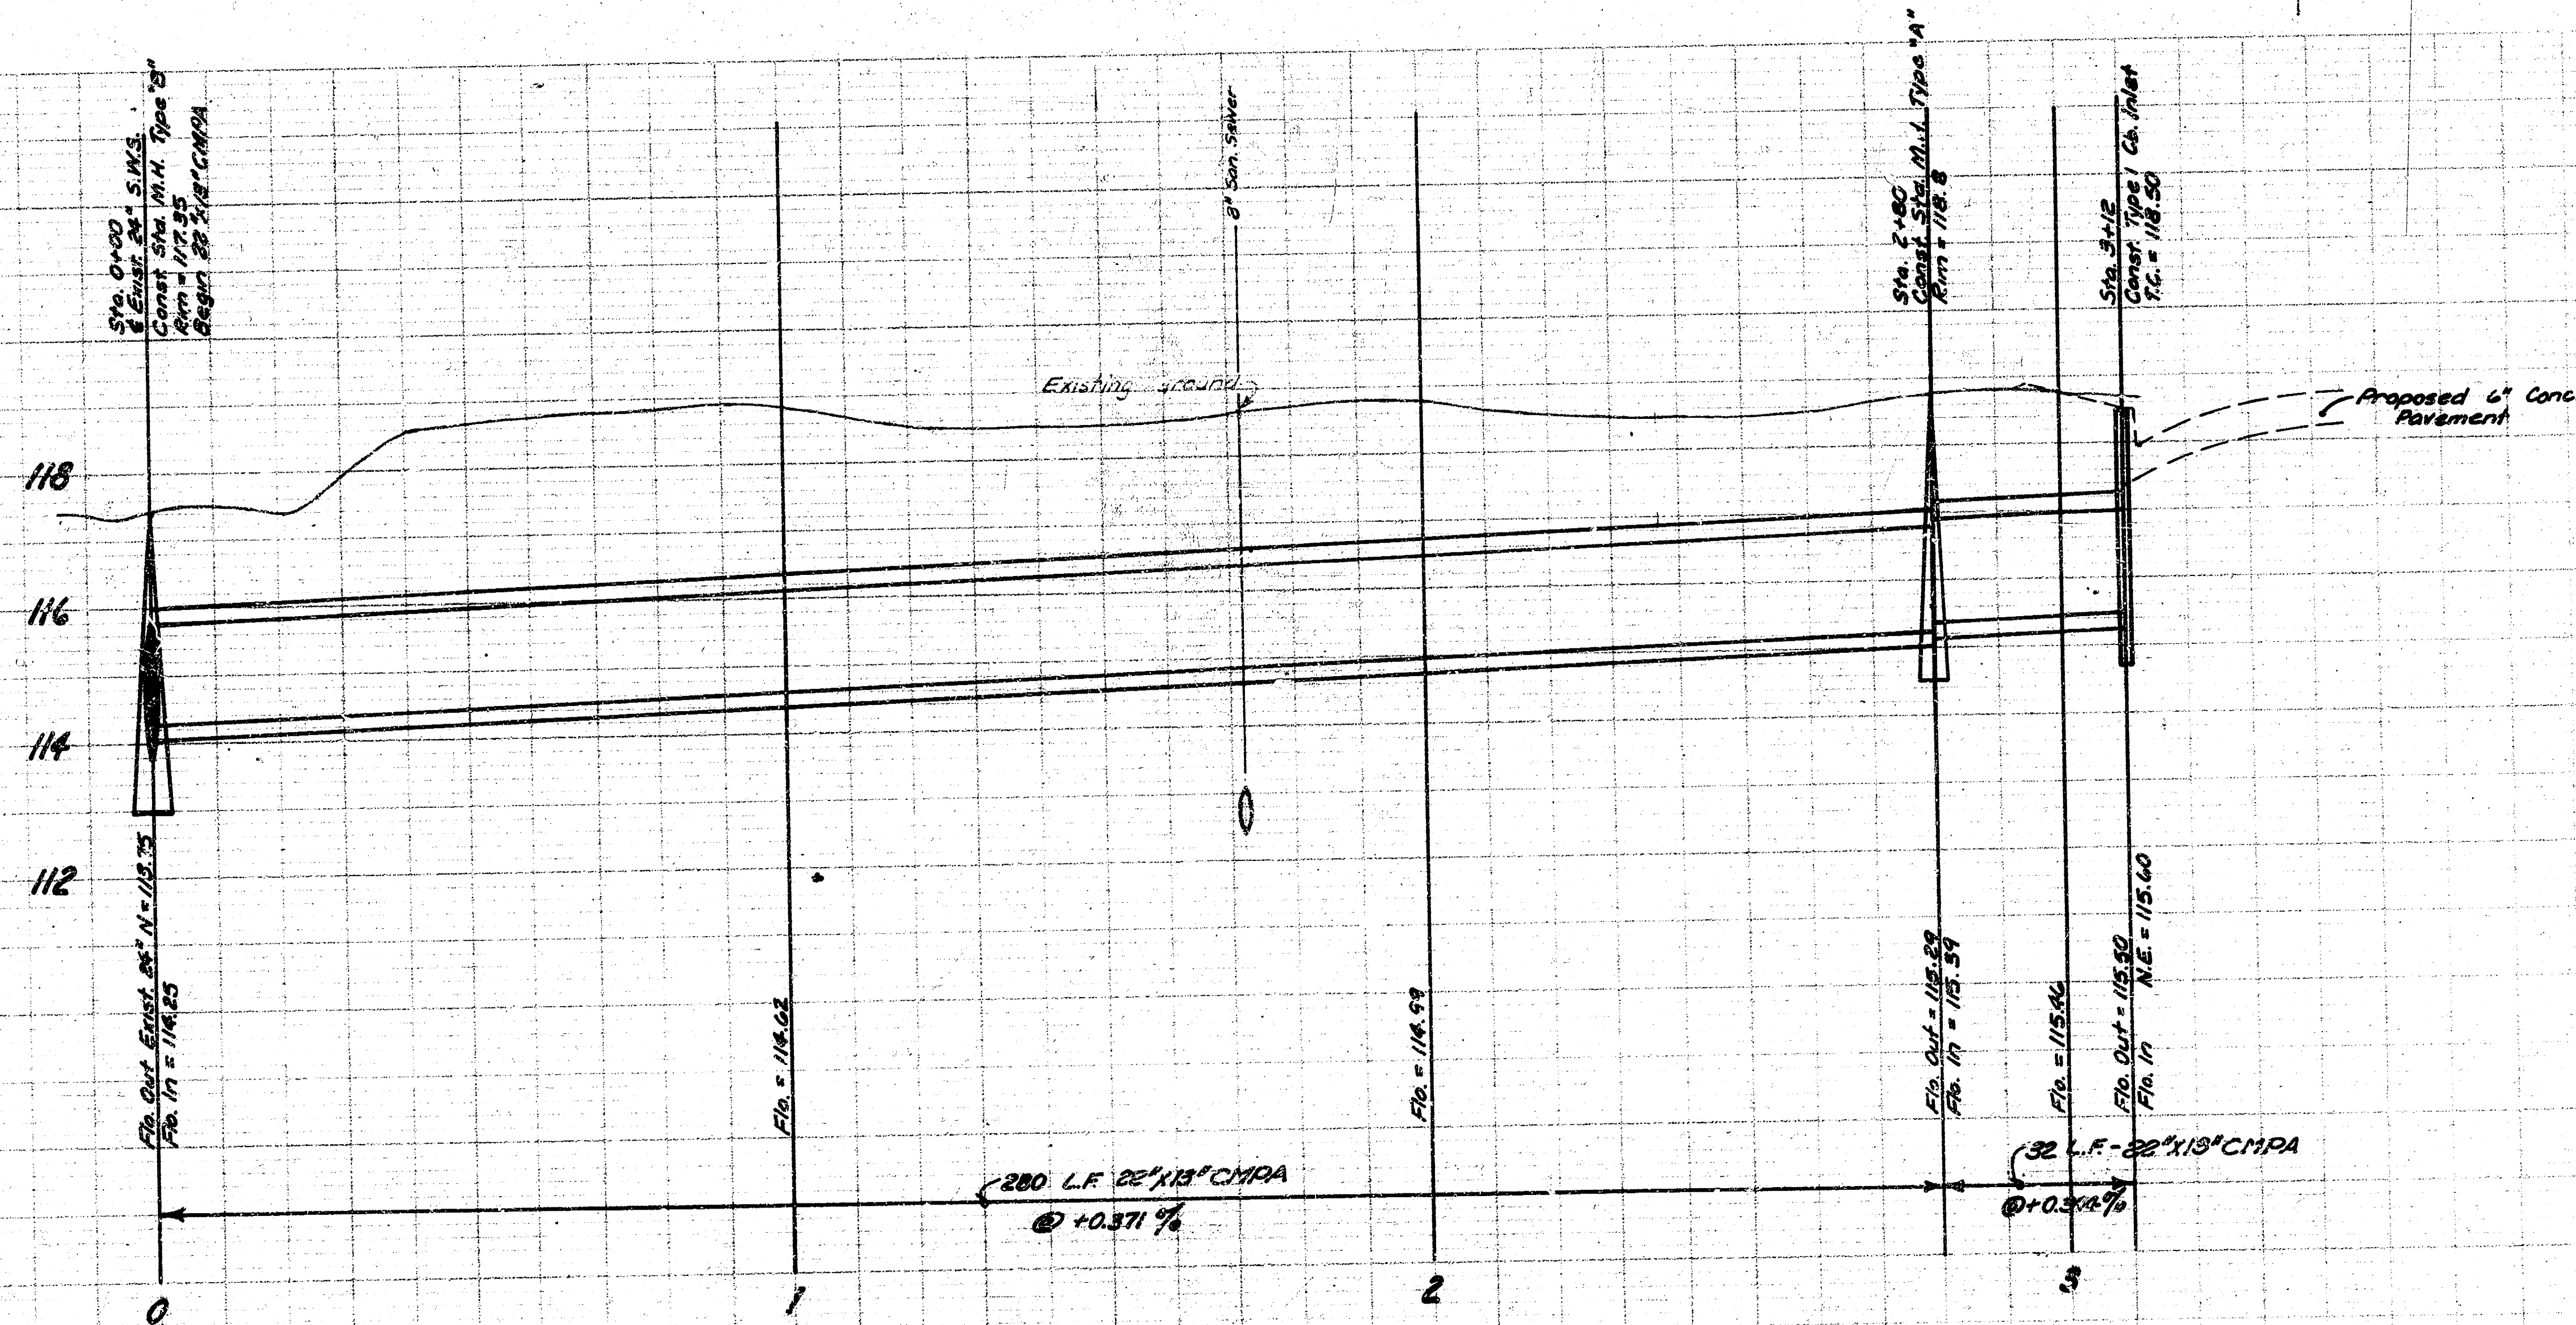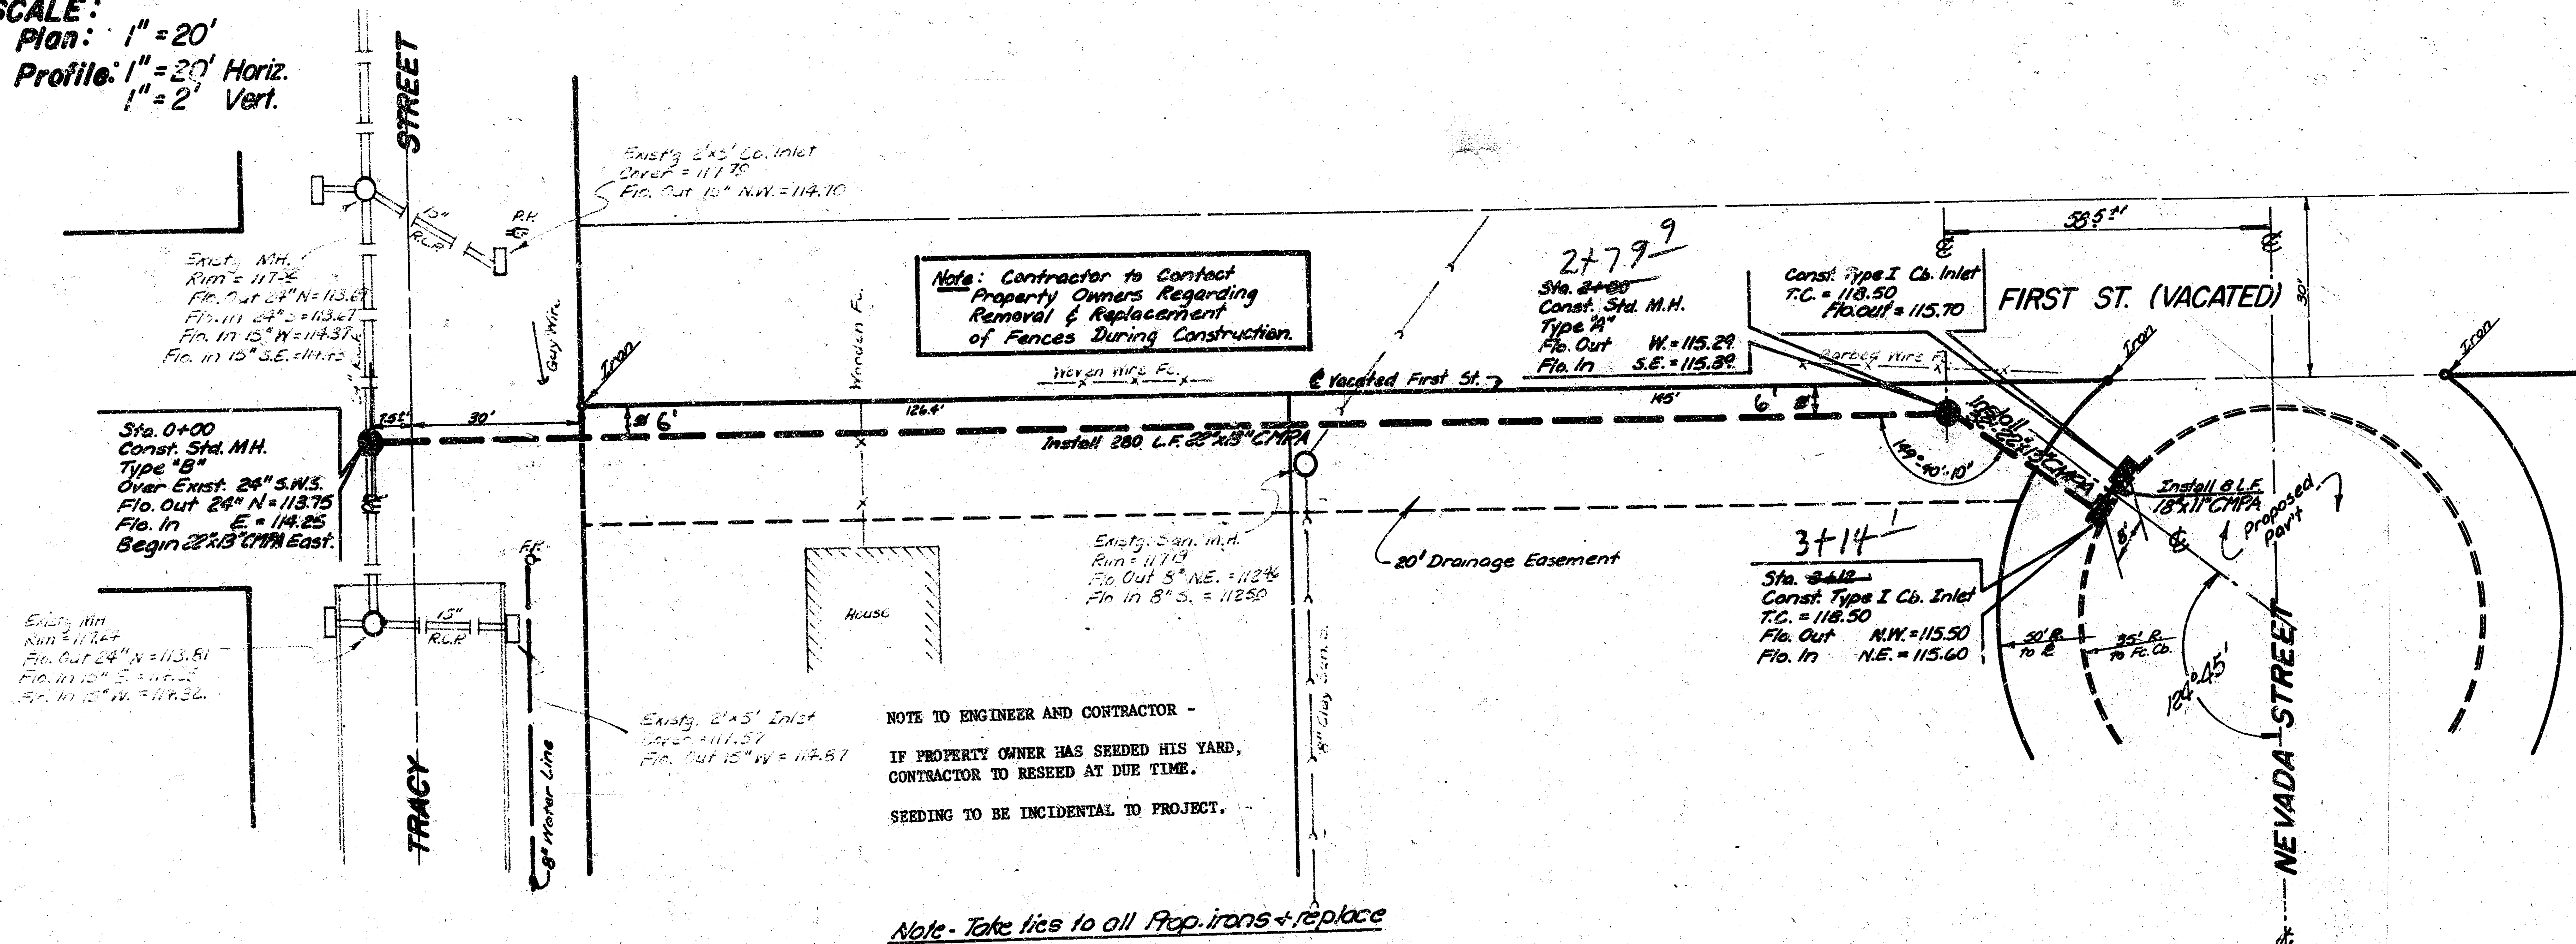

DRAINAGE in CONNECTION with
NEVADA STREET
N. L. Douglas to & incl. Cul-de-sac

CITY OF WICHITA, KANSAS
R.W. Linn — City Engineer
Proj. No. DAKD575127
Date _____

FILMED FROM THE BEST AVAILABLE COPY