


B.M. = 117.94 R.R. Spk. N.S. PP S. Side Douglas, Approx. 100' E. of Nevada


NORTH

SCALE:
Plan: 1" = 20'
Profile: 1" = 20' Horiz.
1" = 2' Vert.

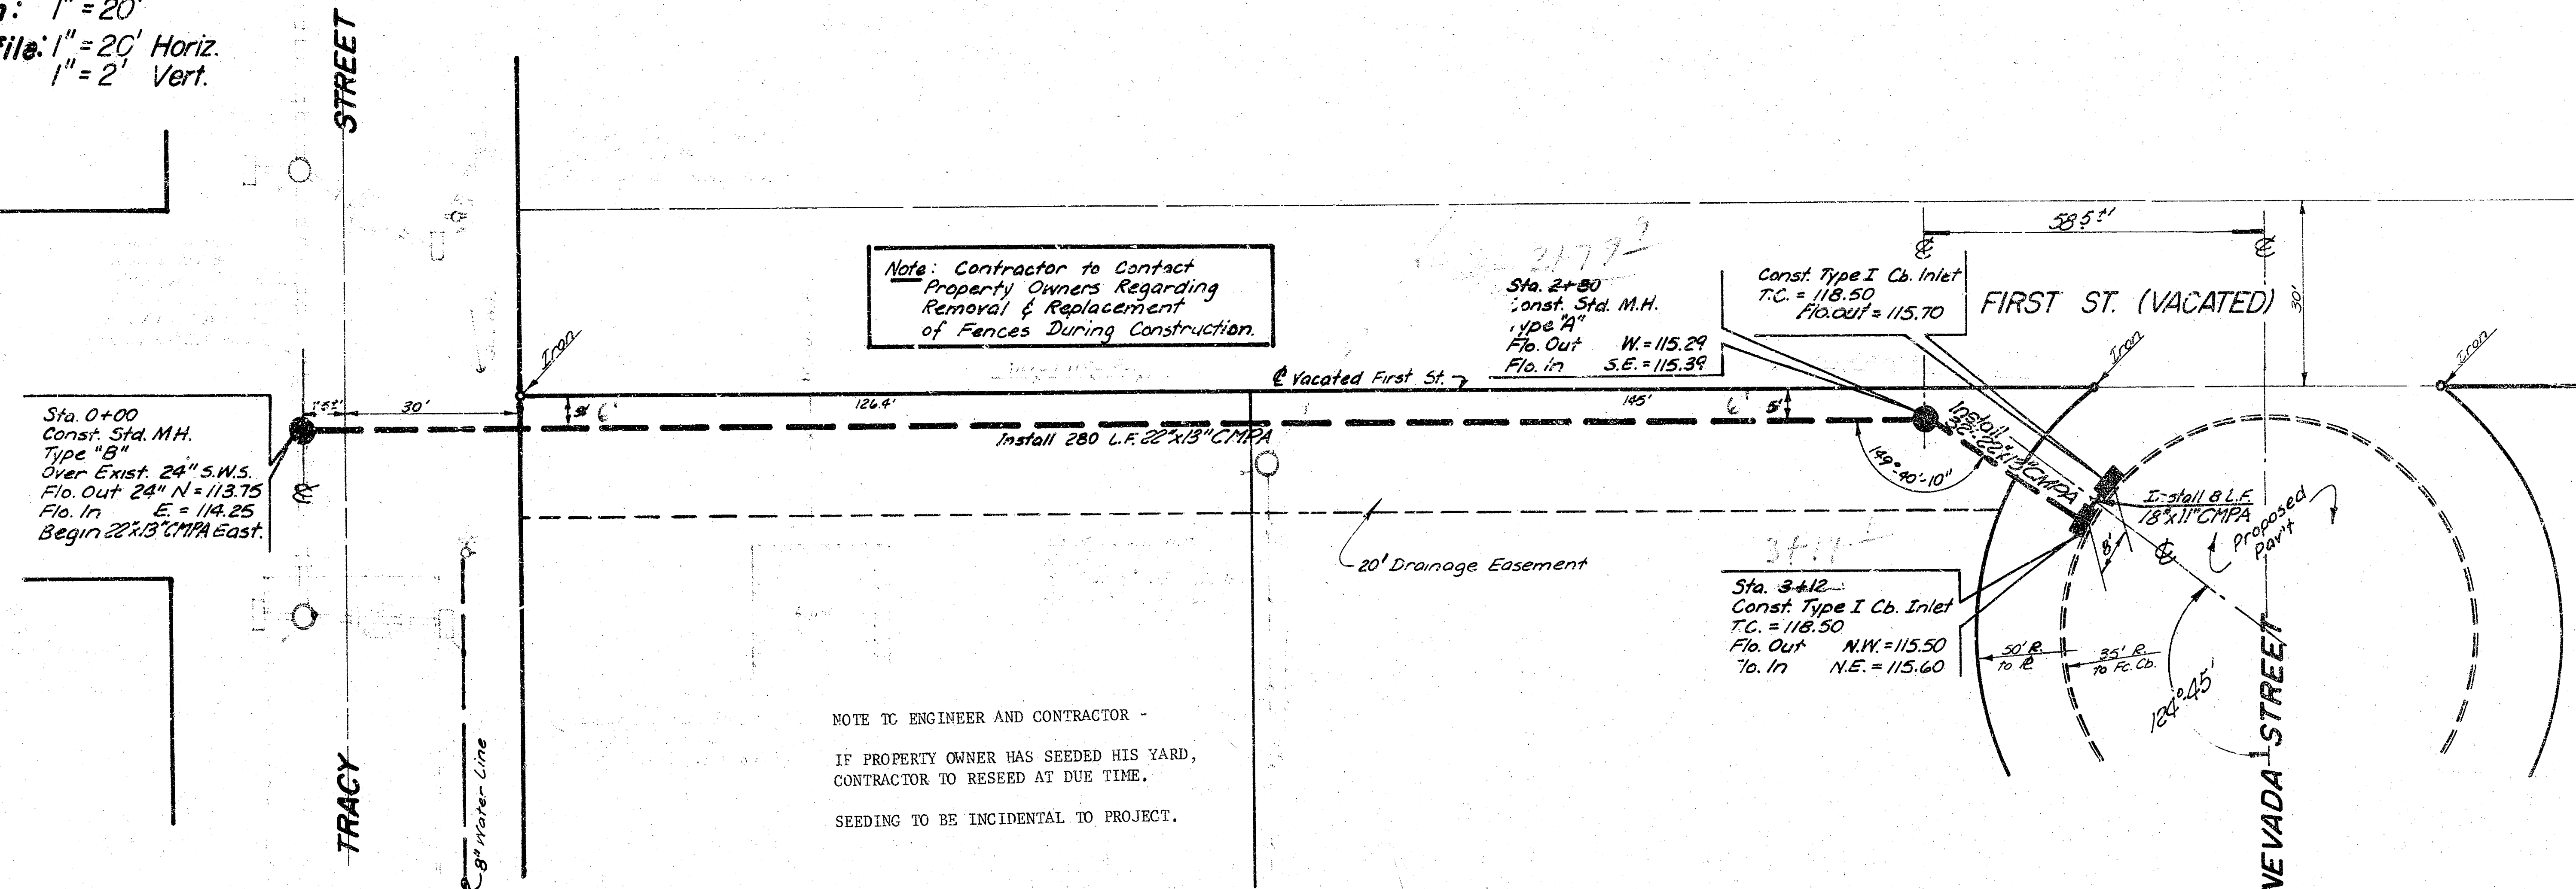

NOTE TO ENGINEER AND CONTRACTOR -
IF PROPERTY OWNER HAS SEEDED HIS YARD,
CONTRACTOR TO RESEED AT DUE TIME.
SEEDING TO BE INCIDENTAL TO PROJECT.

Note - Take ties to all Prop. irons & replace

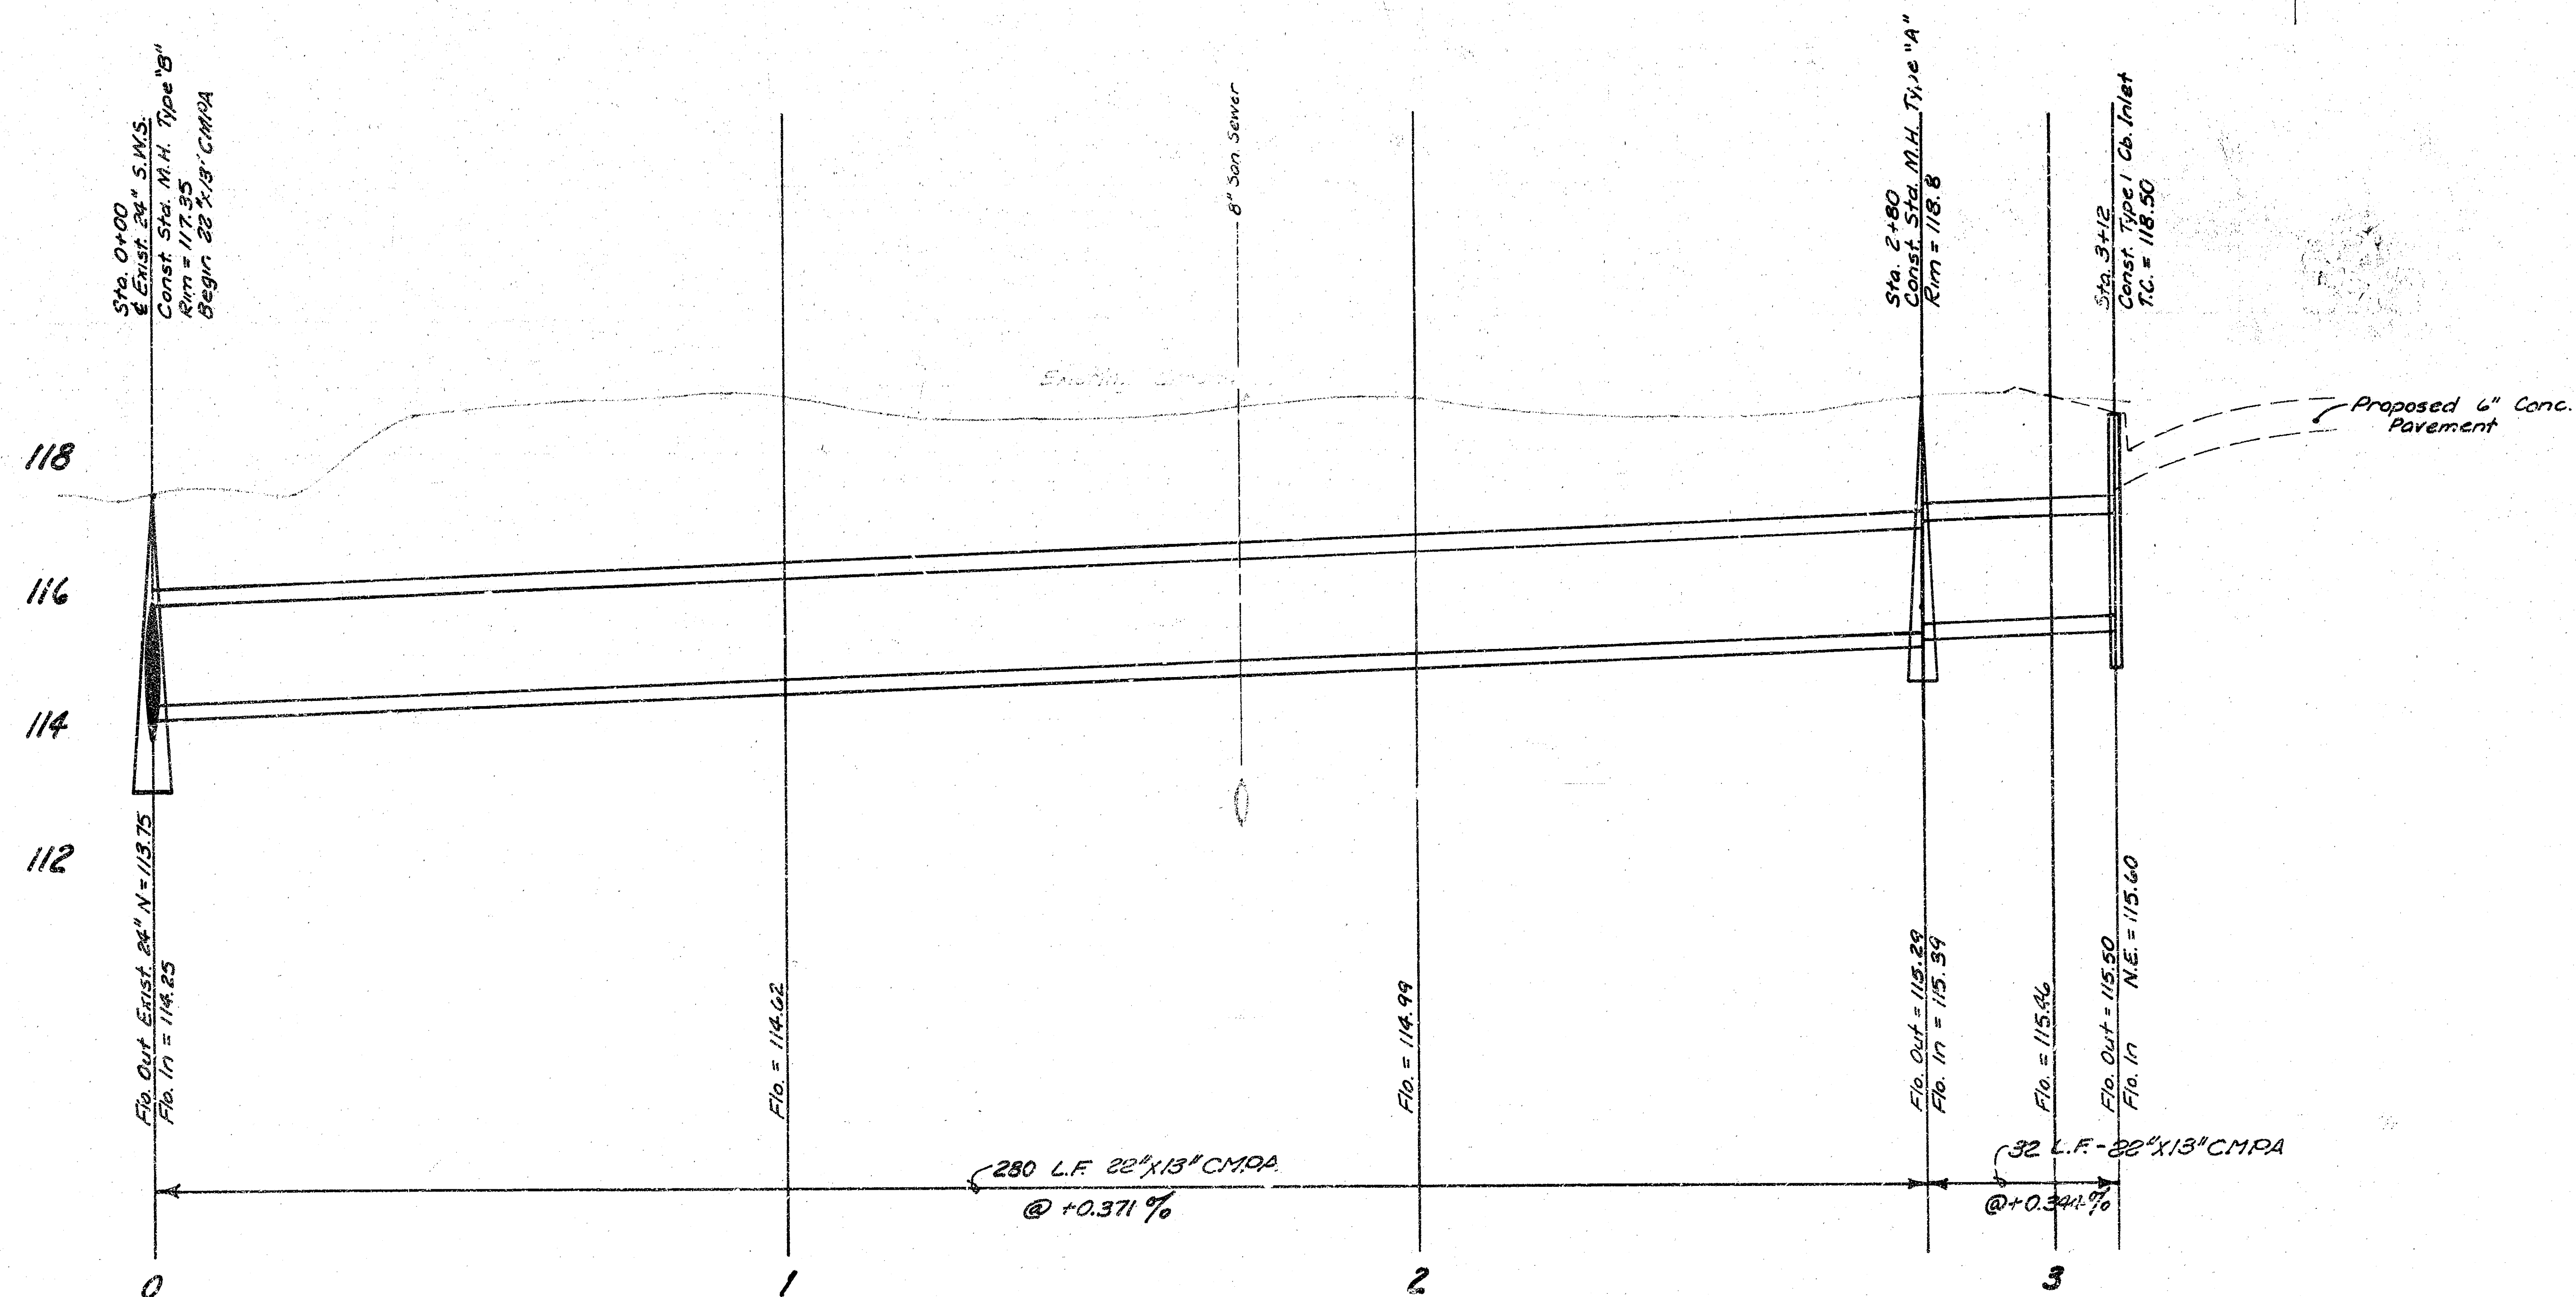

DRAINAGE in CONNECTION with
NEVADA STREET
N.L. Douglas to & incl. Cul-de-sac

CITY OF WICHITA, KANSAS

R.W. Linn — City Engineer
Proj. No. DAKD575127

Date _____

6/10

10 3 3 12