

PAVING PLAN
1942
N.Y. COURT
N.E. 3rd St
LOT 5-BLK B

1942
NEW YORK COURT - N.E. THIRD TO LOT 5-BLOCK-B

28-C.1.

27' Corb to Corb

Also to
Change grade
Build C.B. @ 3rd
C.H.M. 6-27-42


NOTE: STATIONS ARE ON &
OF PROPOSED PAVT.

Eliminate C.B.
Place 2-2x2 Grates
12" Lead to M.H.
7-9-42
C.H.M.

Prop. 607.3
50.7

361' 25.7
4102 26
25.5 w/g

B.M. 111.80' IN KEELER PLOT-22-111.80' SE COR N.Y. 3rd

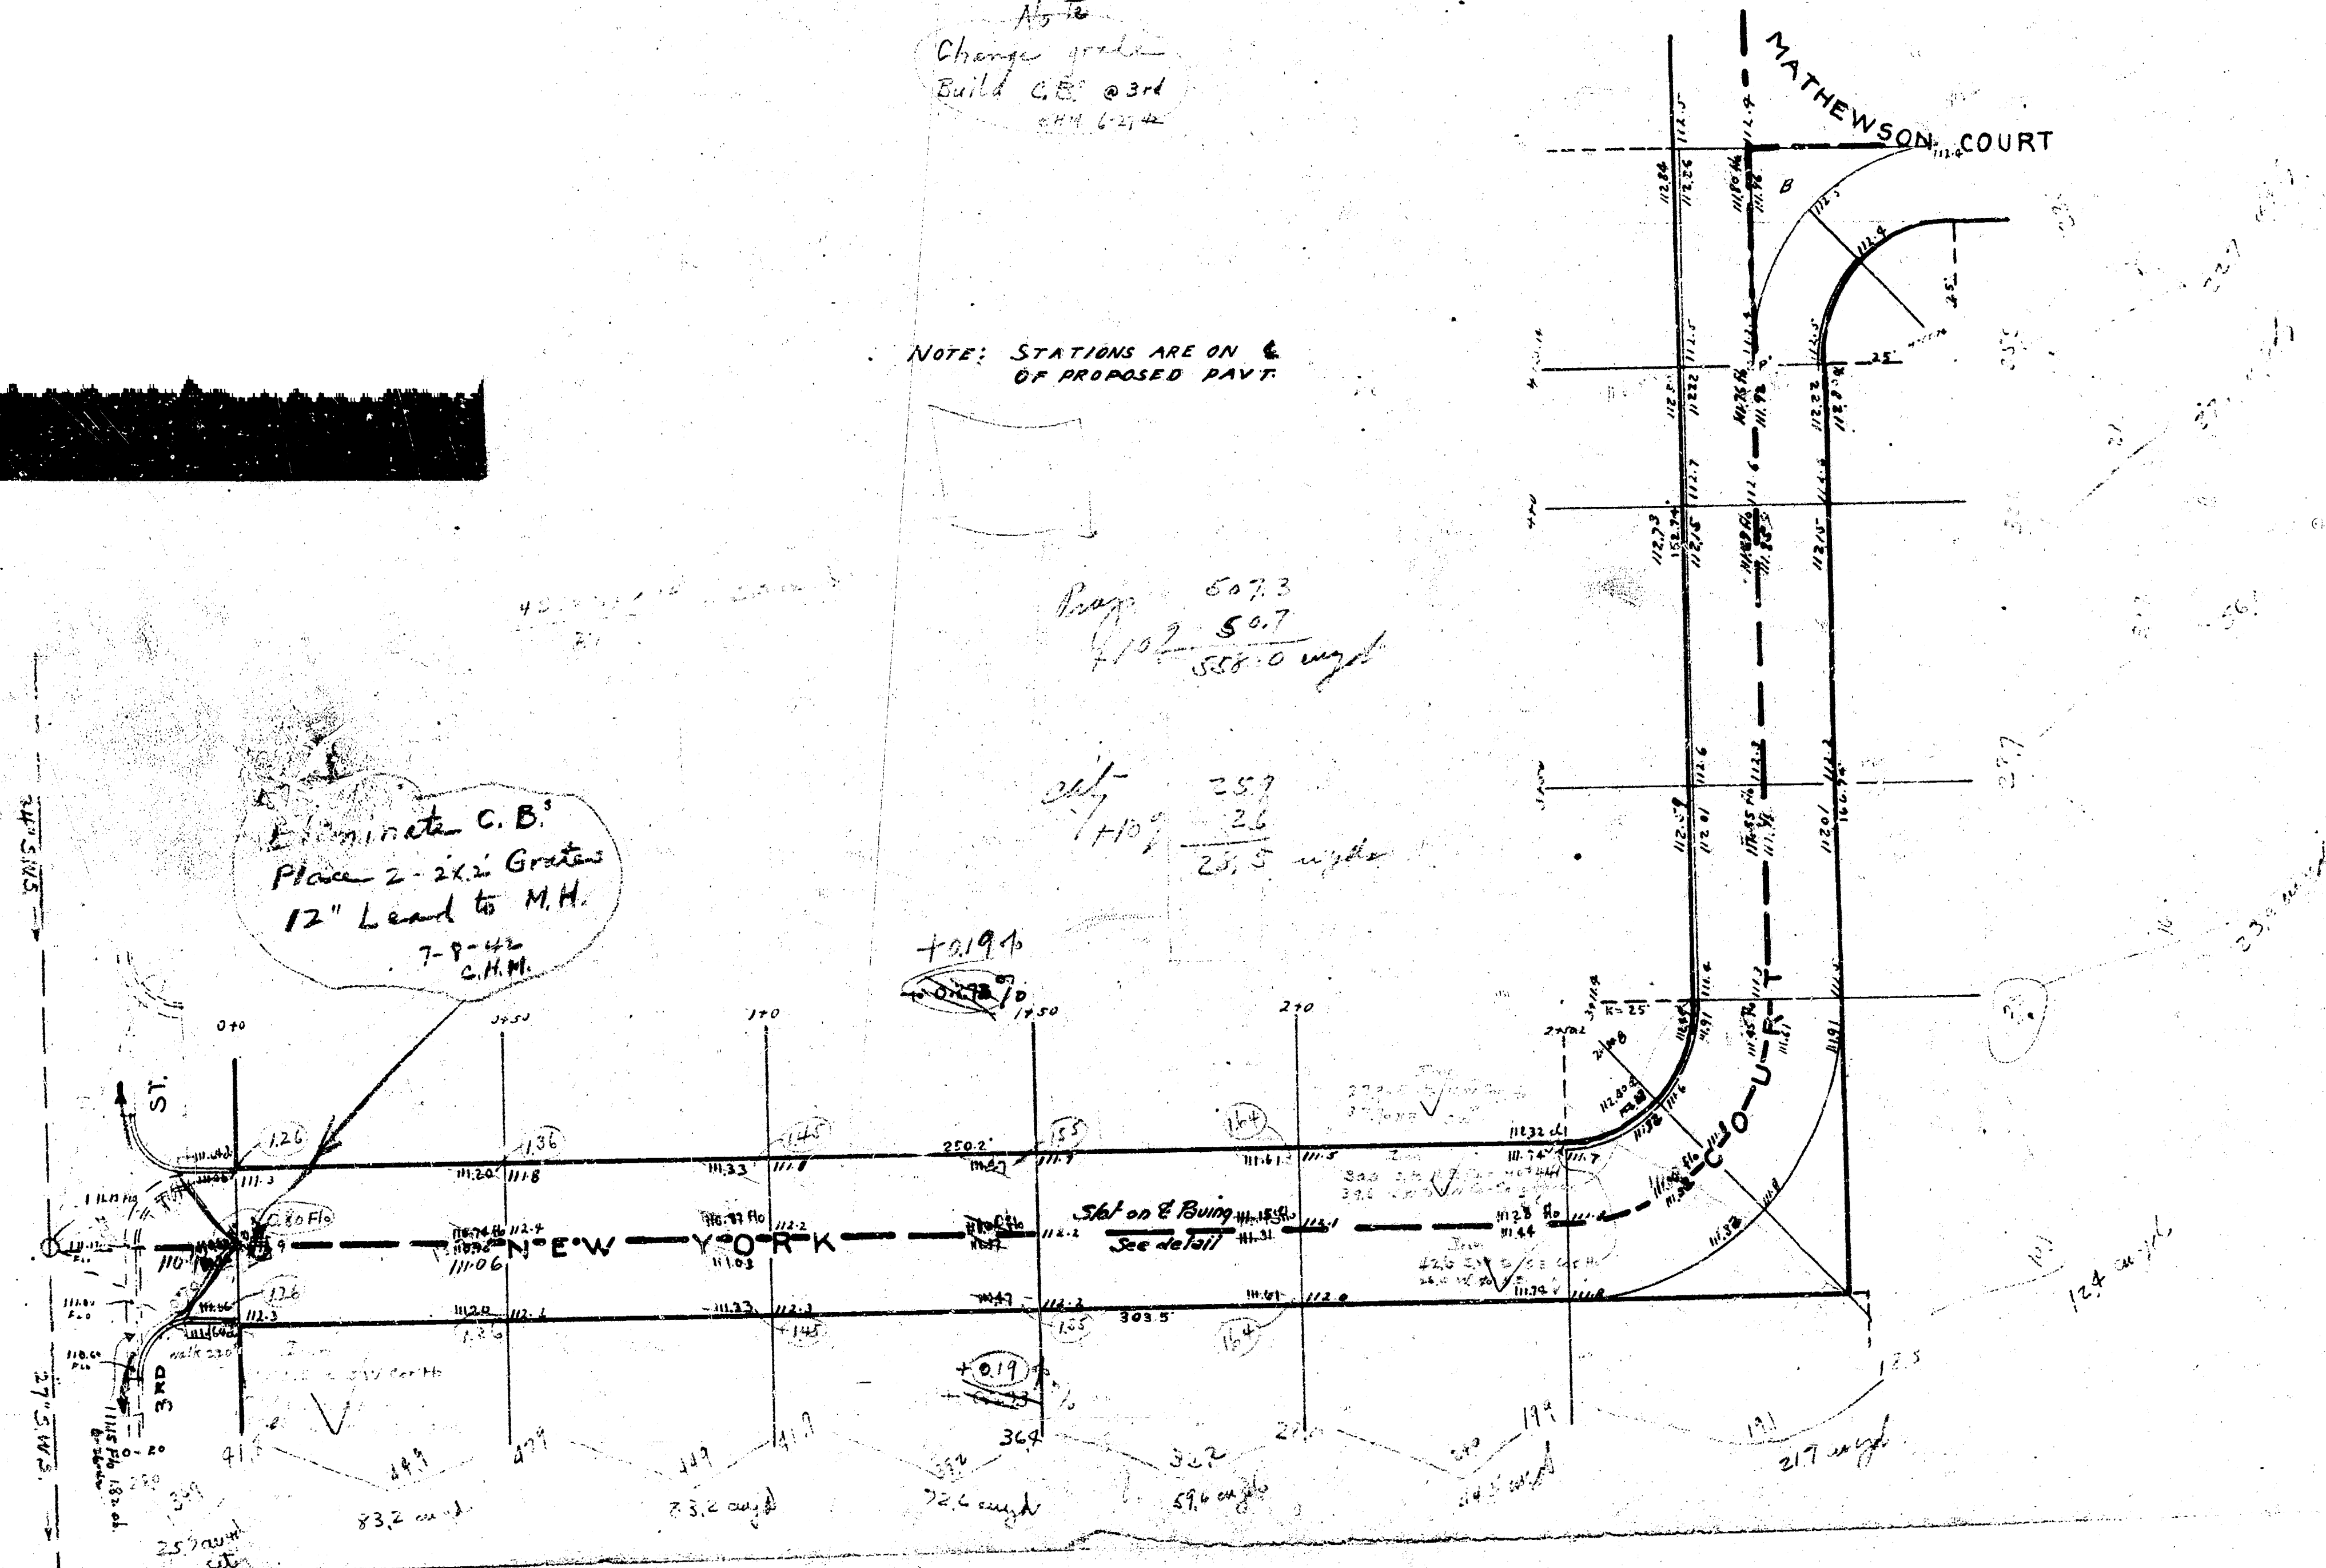

1942
 NEW YORK COURT - N.L. THIRD TO & LOT 5-BLOCK-B
 28-C.I.
 27' Corb. to Corb.

NOTE: STATIONS ARE ON E
 OF PROPOSED PAVT.

Prop 607.3
 50.7
 558.0 mpt

21- 257
 26
 21.5 mpt

B.M. 111.80' K' IN KEELER FRT OF MR. No. SE cor N.Y. + 3rd

