


OHIO AVE. SL. MURDOCK to SL. FRANCISCO R.W. 7" CONCRETE.

Book 35 P.C.  
C.M.  
Rail. E.L.W.

Note Contact Chart before setting & determine S13 & Location of Facility on Blotter

27' Slab  
1' Gravel base  
11.15 Top, 11.15 Bottom, 11.15 Top, 11.15 Bottom

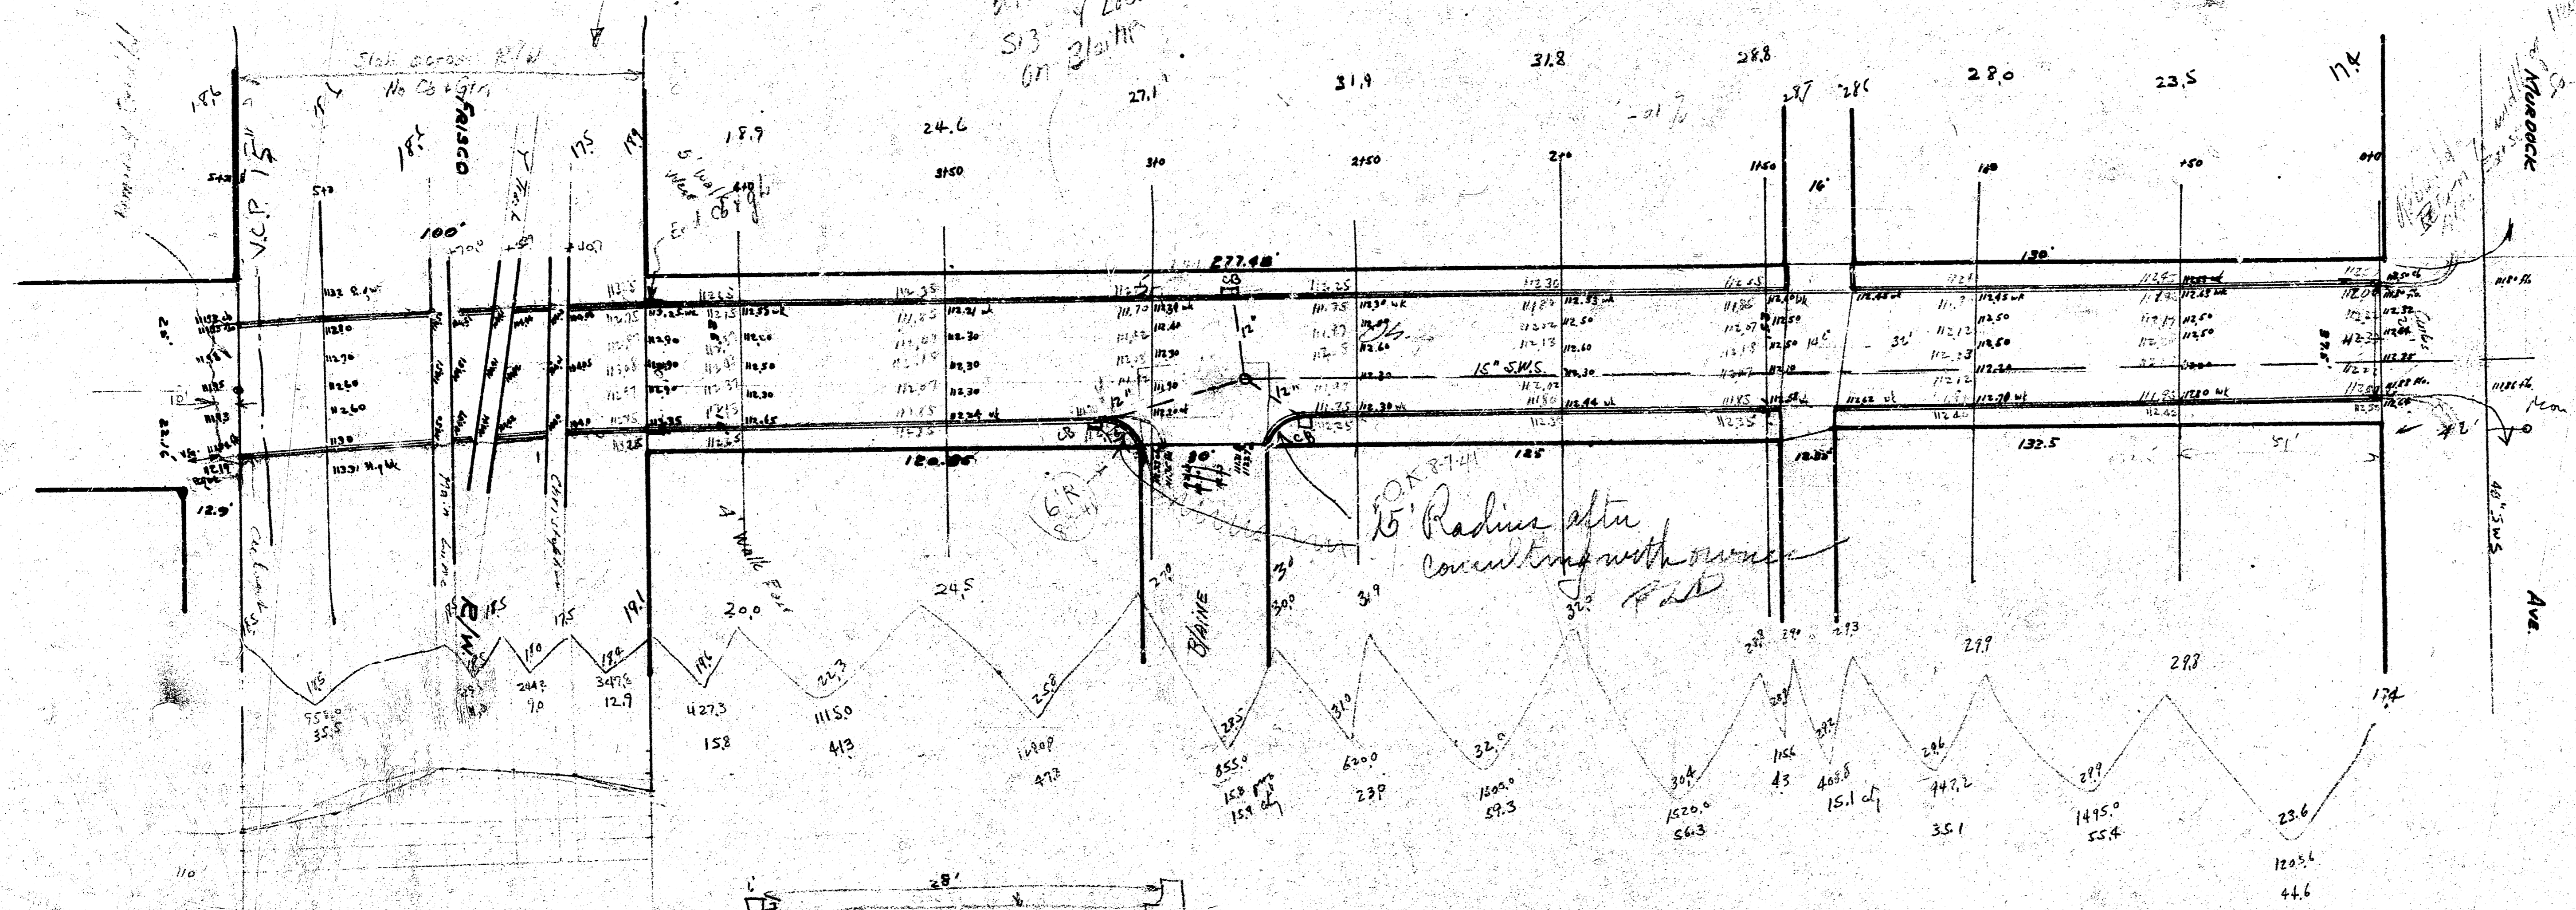

15' Radius after  
Construction with  
Concrete

467.1  
467  
Comp 513.8' orig  
31.0  
31  
31.1' orig

MURDOCK Ave.  
FRANCISCO Ave.