


B.M. 124.39'± in Globe Court Old Manor, N. Kinkaid

Stationing on S. curb

ELEVATION
1396.6
+10' 1397.7
1536.3

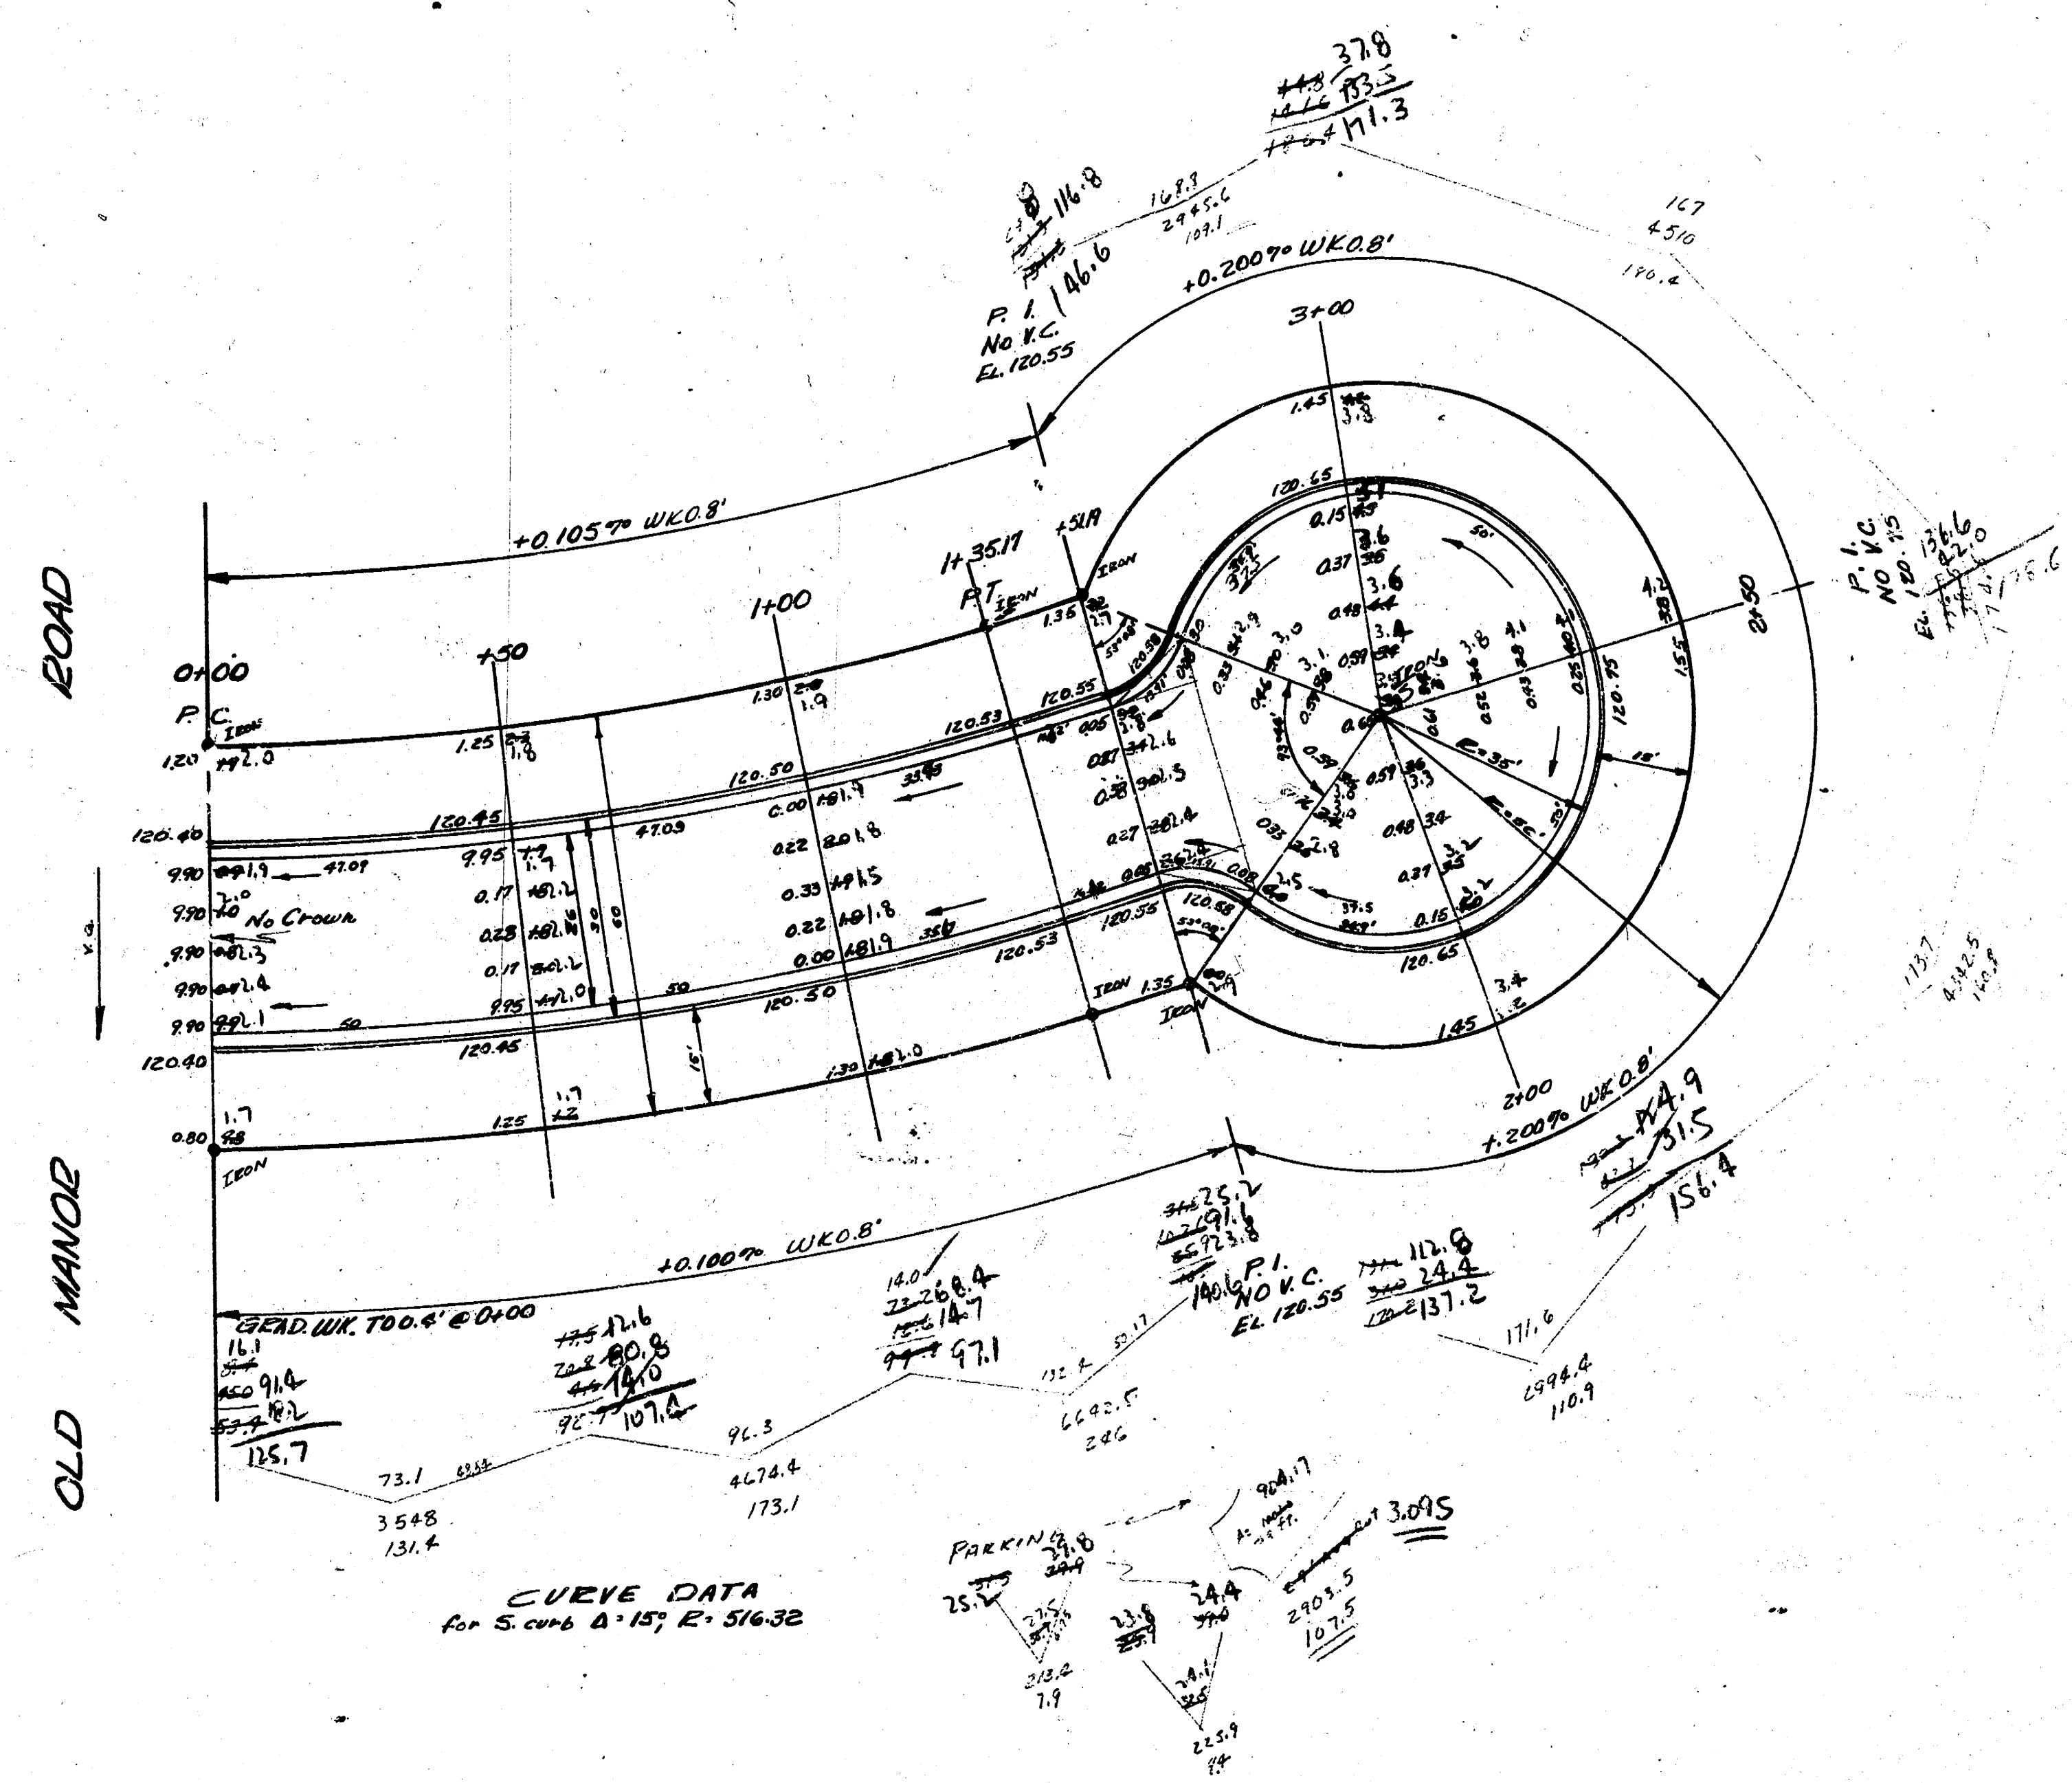

Surveyed by
Plan
Exc.
City Engineer

OLD MANOR COURT
26-2-30 AC.
CITY OF WICHITA, KAN.
B.E. SMITH
DEC. 1952
CITY ENGINEER
PROV. NO. 012-66

