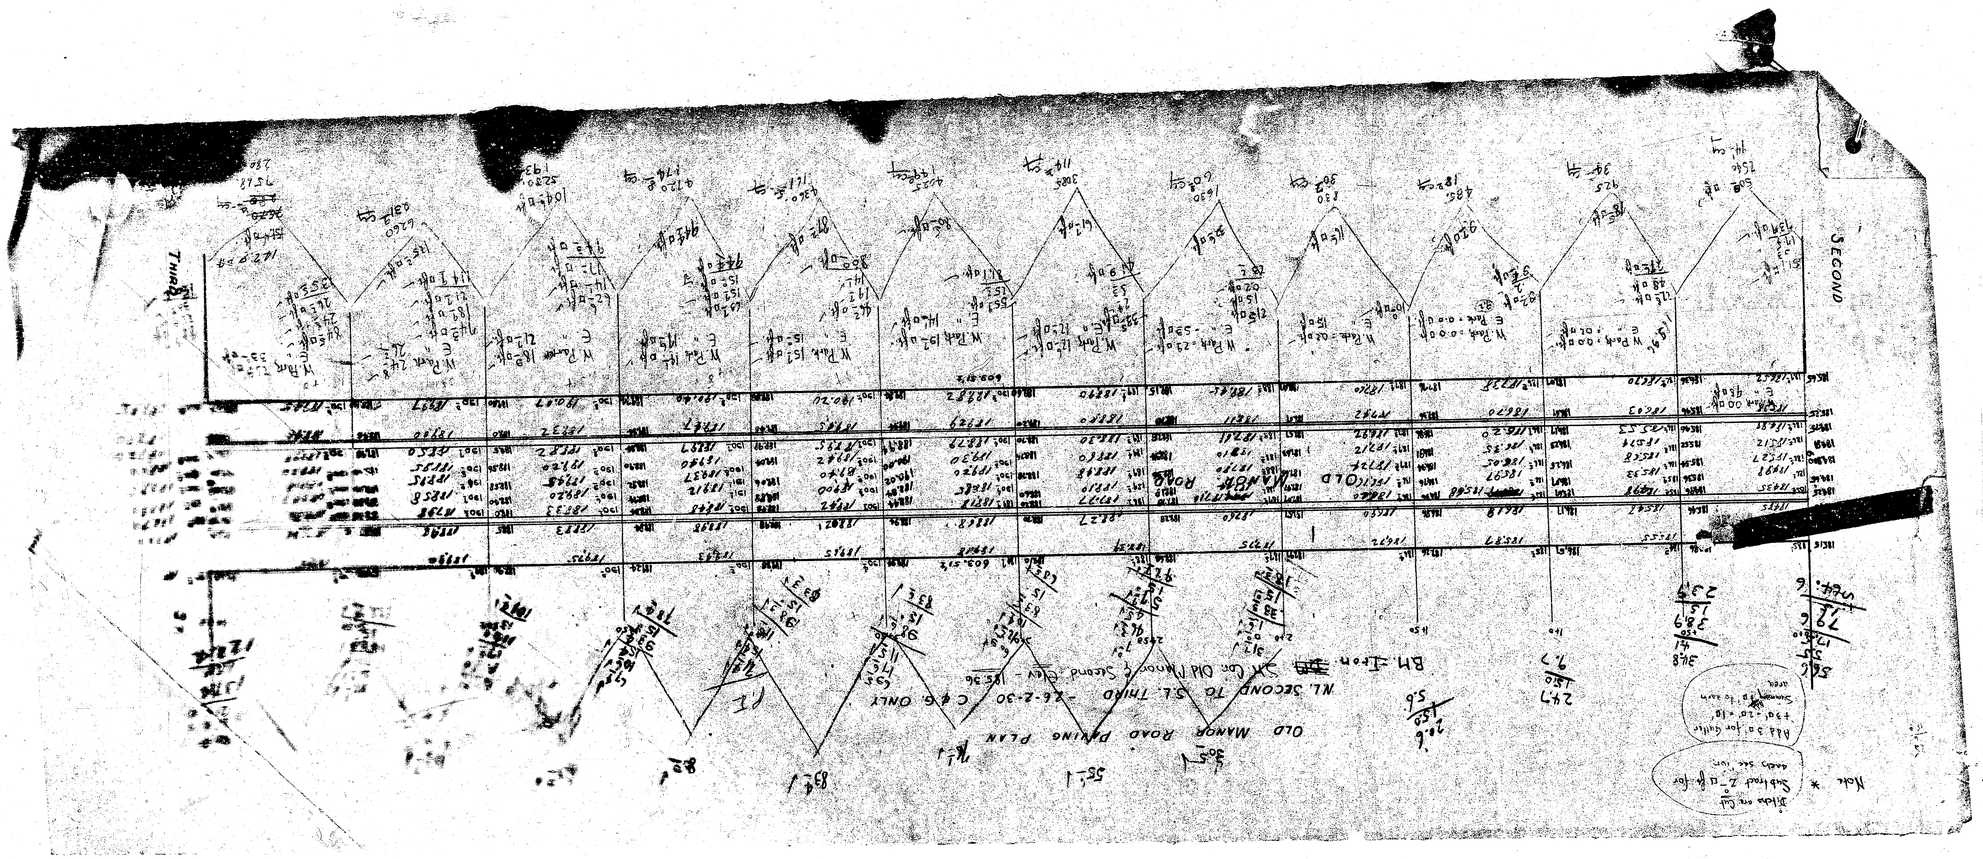

OLD MANOR ROAD PAVING PLAN
N.L. SECOND TO S.L. THIRD - 26-2-30 C & G. ONLY
B.M. - Iron ~~BM~~ S.W. Cor. Old Manor & Second Elev. - 185.36
Note * Ditchs are Cut Subtract 2.0 sq. ft. for each section
Add 3.0 for Gutter +3.0 - 2.0 = 1.0 Summary 1.0 to each area
OLD MANOR ROAD
SECOND
THIRD
P.I.
603.51
W. Park 0.0 oft. E. " 0.0 oft.
W. Park 2.9 oft. E. " 5.3 oft.
W. Park 12.0 oft. E. " 12.0 oft.
W. Park 19.0 oft. E. " 14.0 oft.
W. Park 15.0 oft. E. " 15.0 oft.
W. Park 14.0 oft. E. " 19.0 oft.
W. Park 16.0 oft. E. " 21.0 oft.
W. Park 24.0 oft. E. " 26.0 oft.
W. Park 29.0 oft. E. " 33.0 oft.

OLD MANOR ROAD
N.L. 2ND TO N.L. 3RD

26' CONCRETE

B.M. Elev. 184.98 E. in S. Globe W. of Old Manor SL 2nd

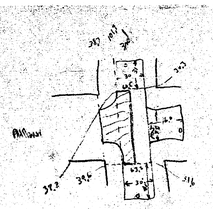

Chk
Set back 1.0' from curb guide on intersection for integral curb

N.B. Omit intersection entirely P.J.P.

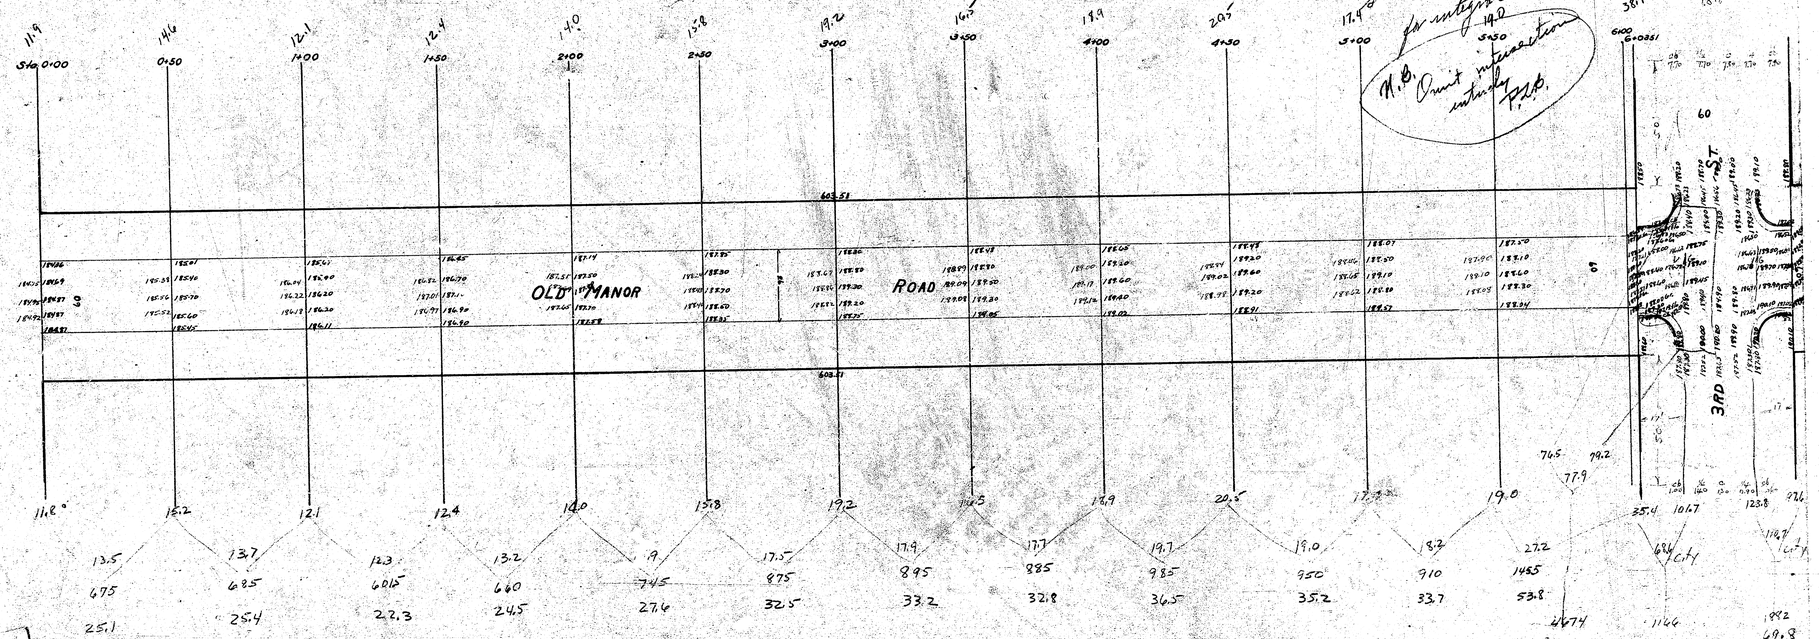

Property 382.60 + 38.8 = 420.9
City 285.9 + 28.6 3.14.5
733.4 Cu Yds Total