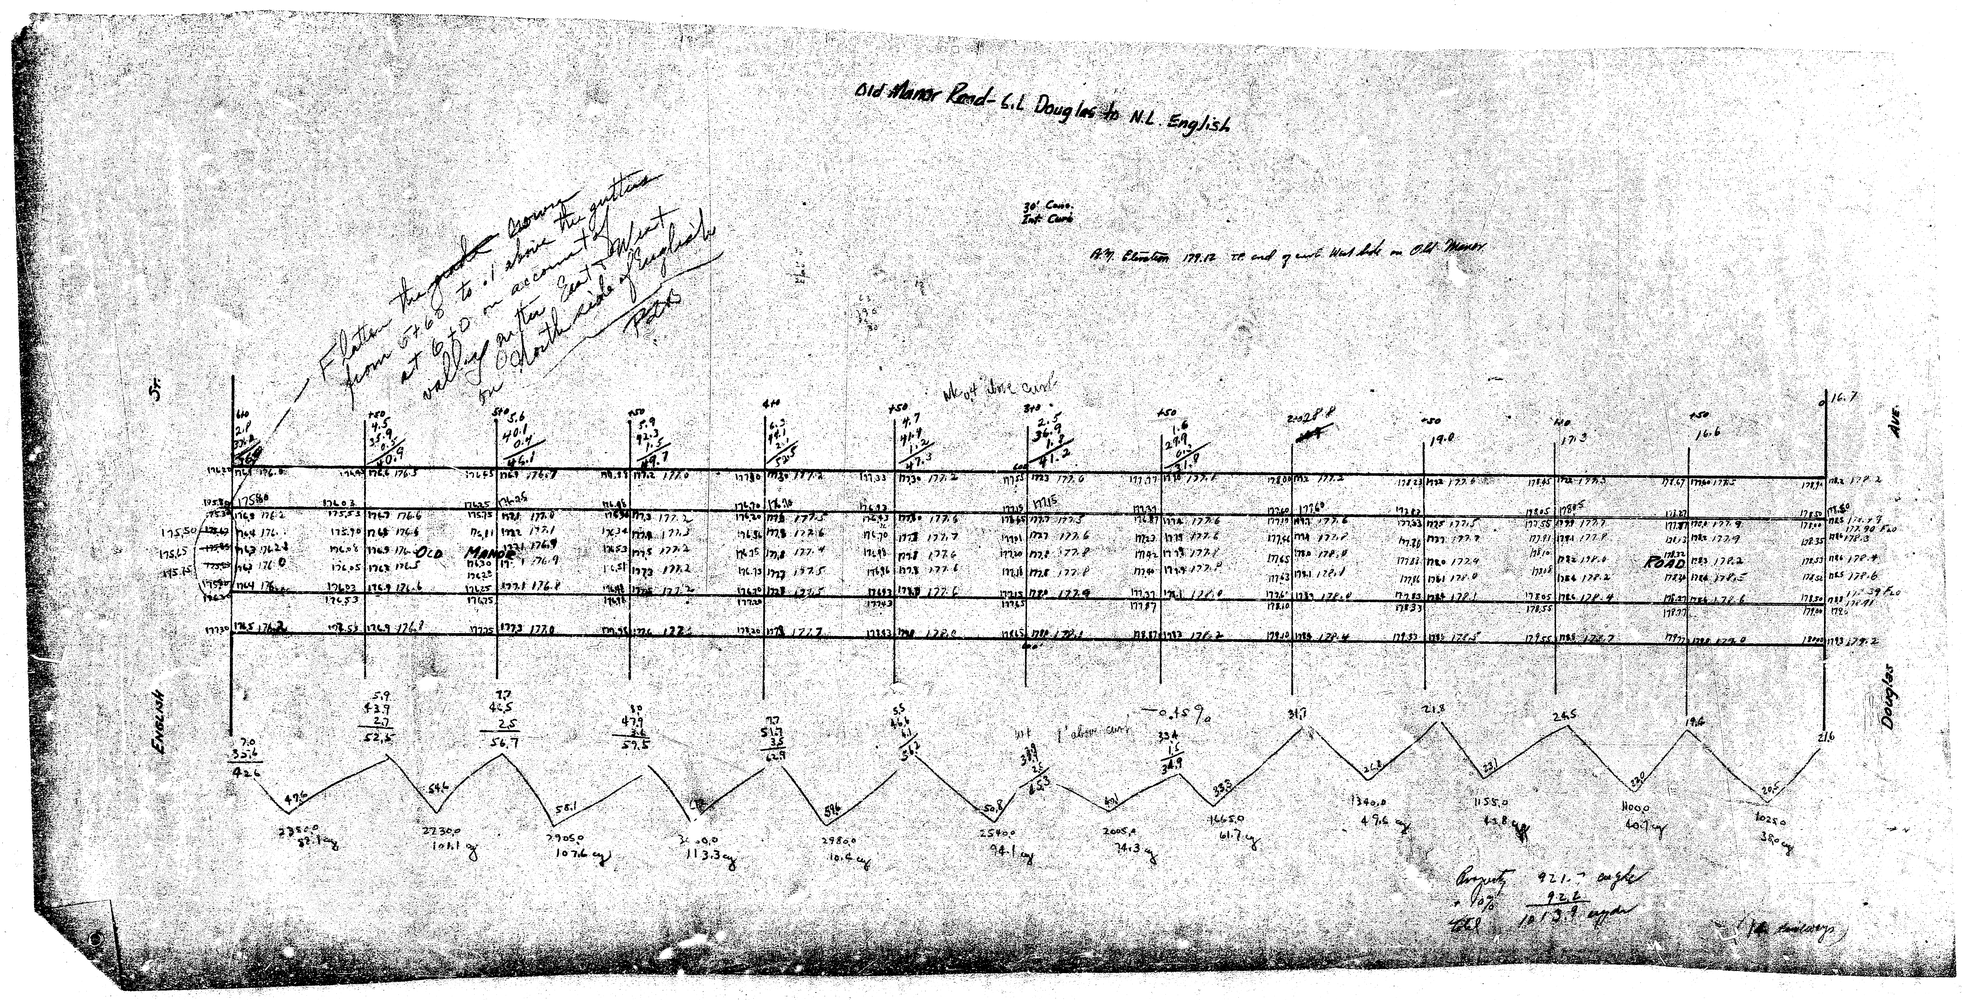Old Manor Road - G.L. Douglas to N.L. English