



ENR 18744 6" IN GLOBE N. CO. PINECREST & SL. CENTRAL

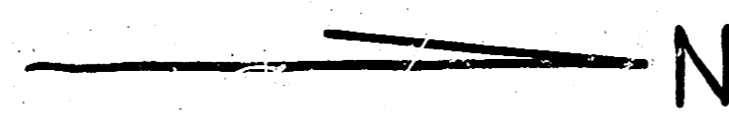

90
 26.9
 27.0
 26.9
 24.6
 114.4
 125.8

4.1
 4.5

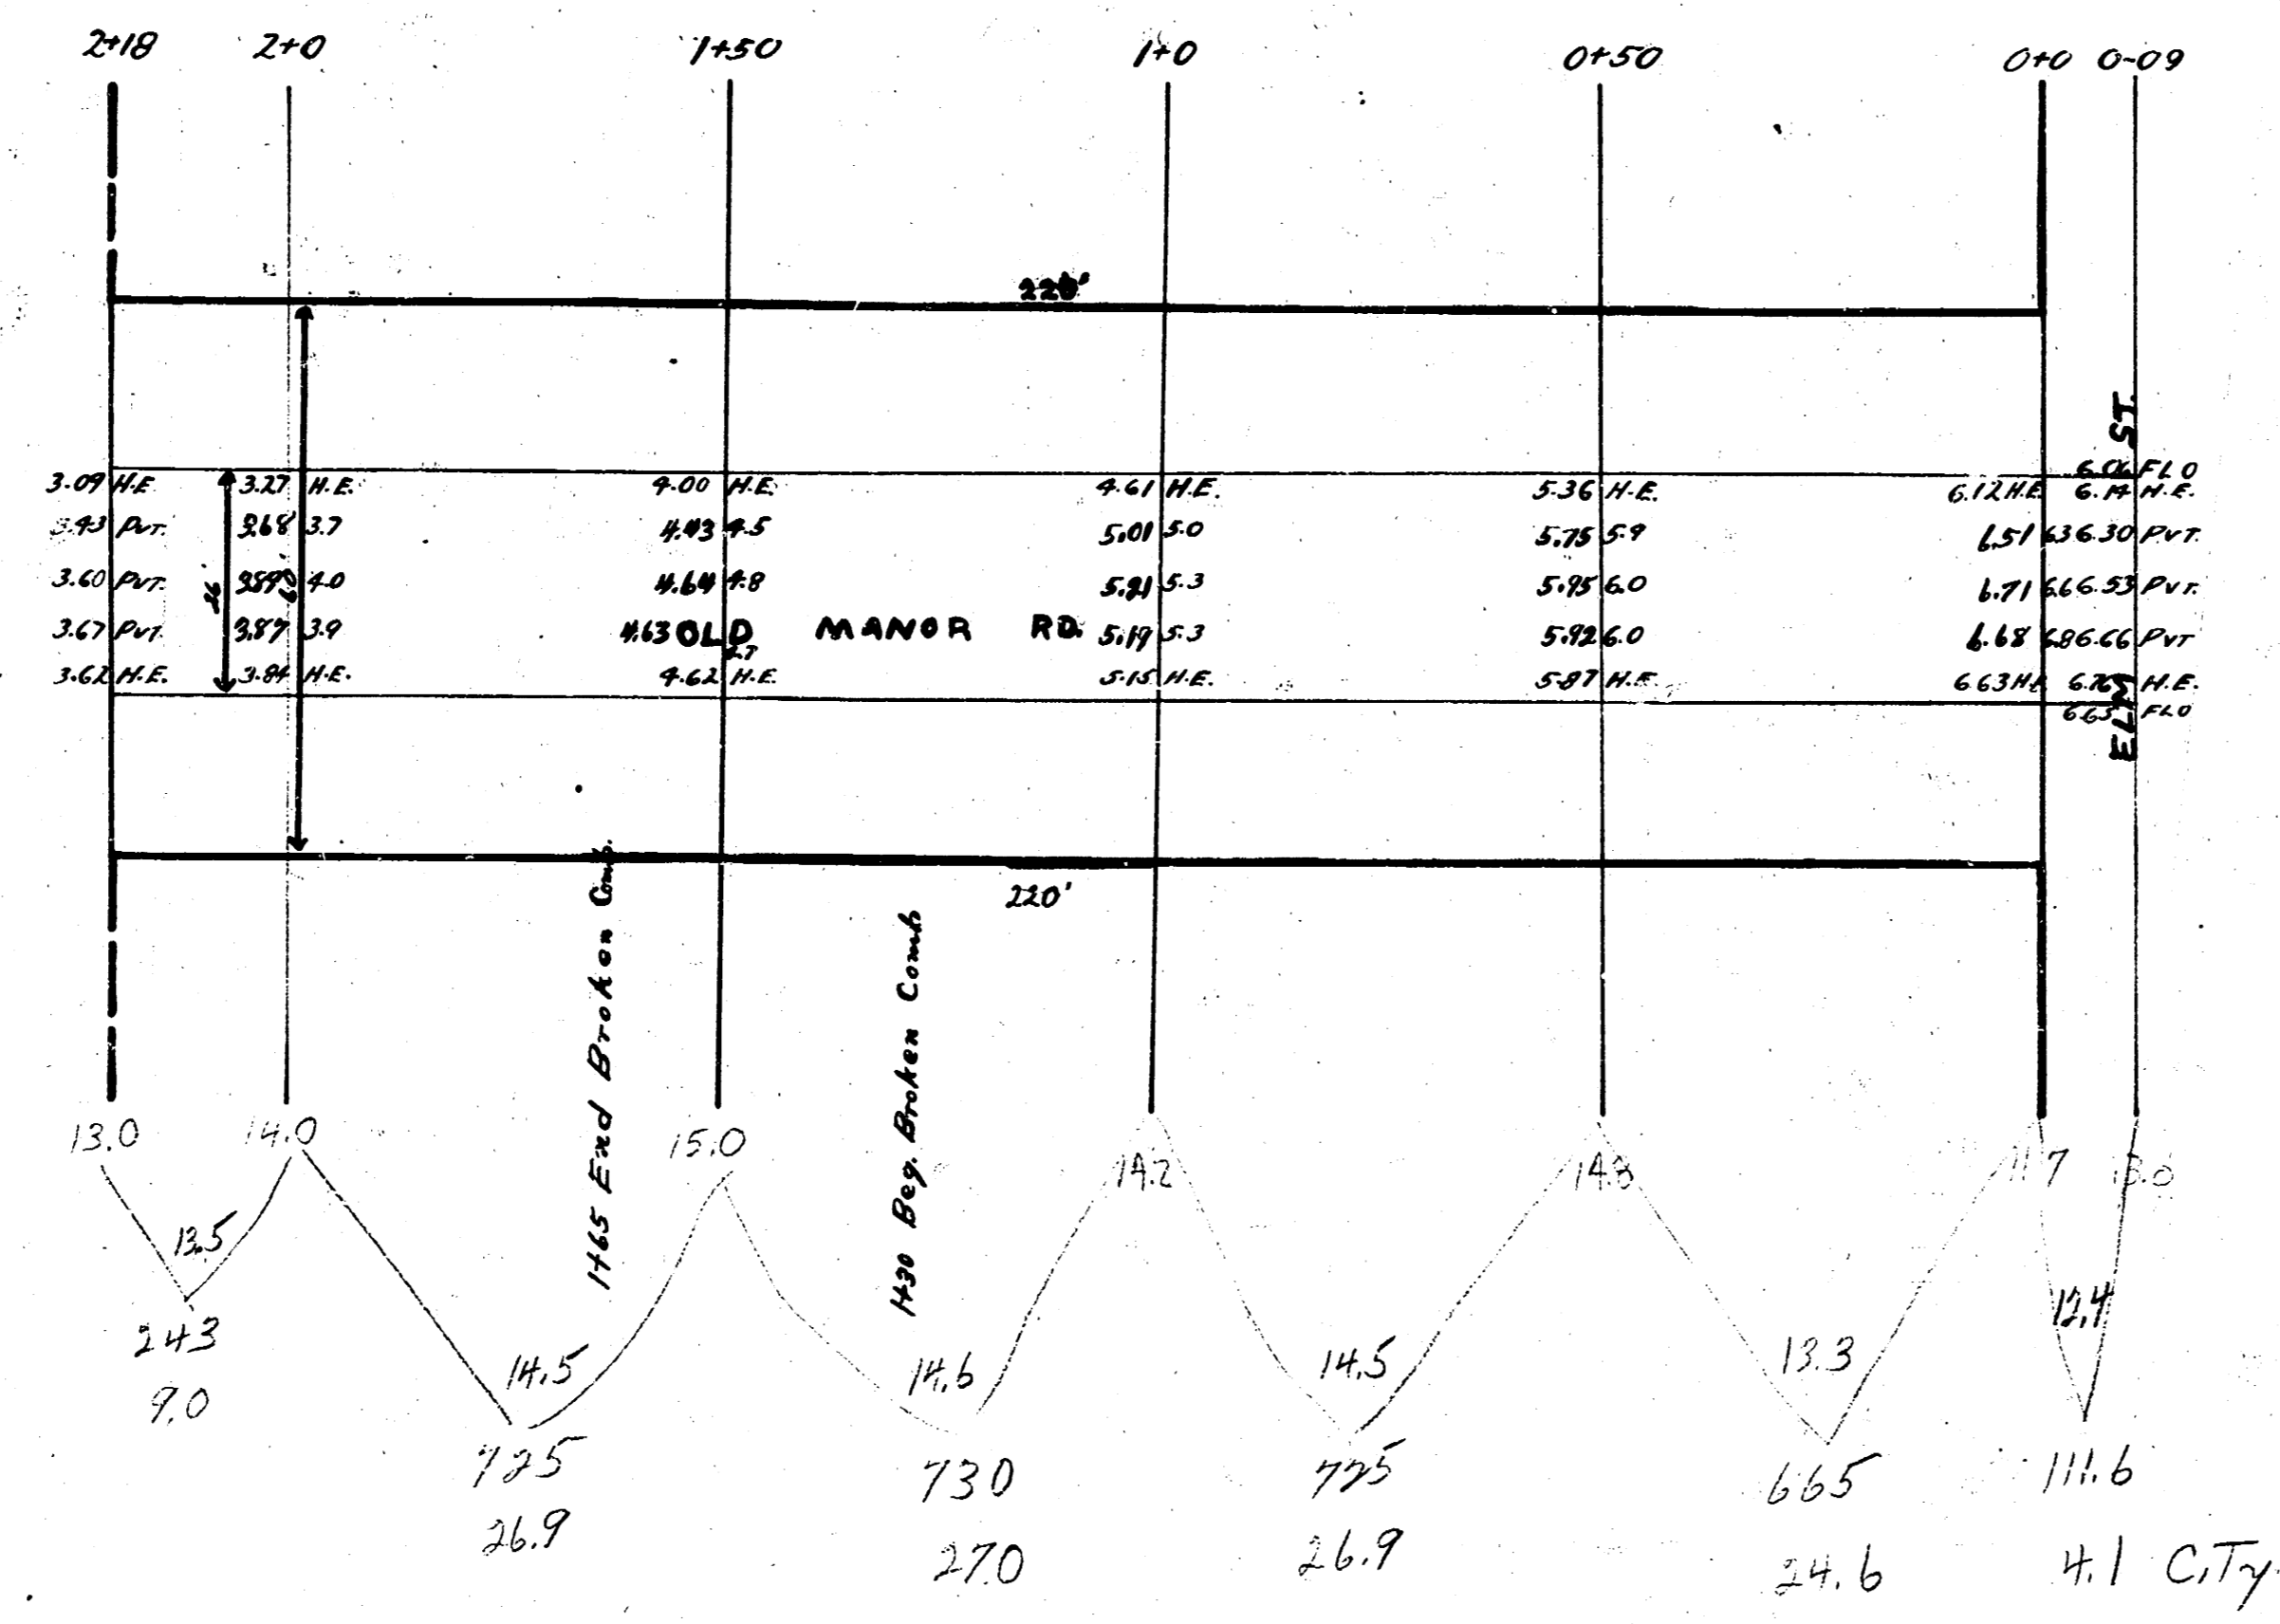

OLD MANOR RD.
 S.L. ELM. 60' N. AL. CENTRAL
 26' Conc
 City of Wichita, Kansas
 L.K. WHITE City Engineer
 September 1907

4 15 4 8