
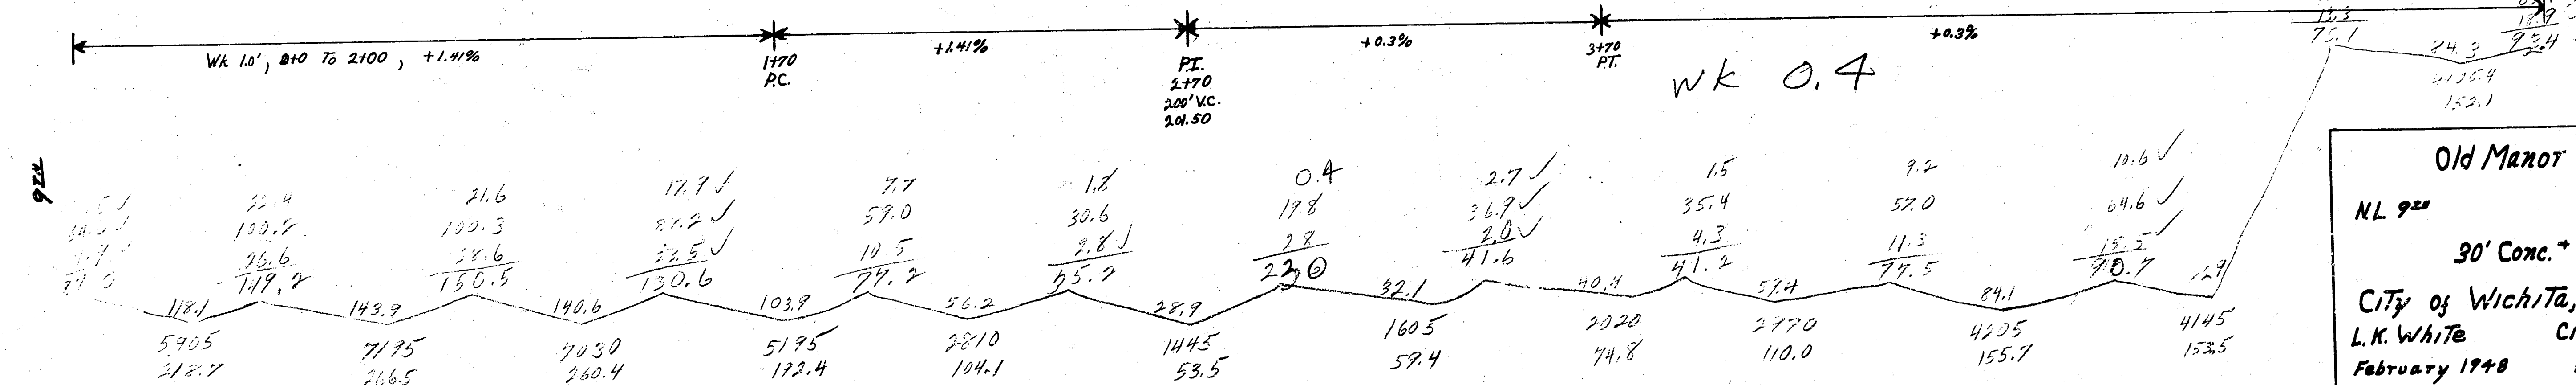


B.M. 200.53 N.E. Cor. Patch House S.W. Old Manor ~ 9th
 B.M. 202.50 Iron S.W. Old Manor ~ 10th

Property
 218.7
 266.5
 250.4
 192.4
 104.1
 53.2
 59.4
 70.0
 110.0
 155.7
 155.5
 152.1
 181.1
 112.1 6%


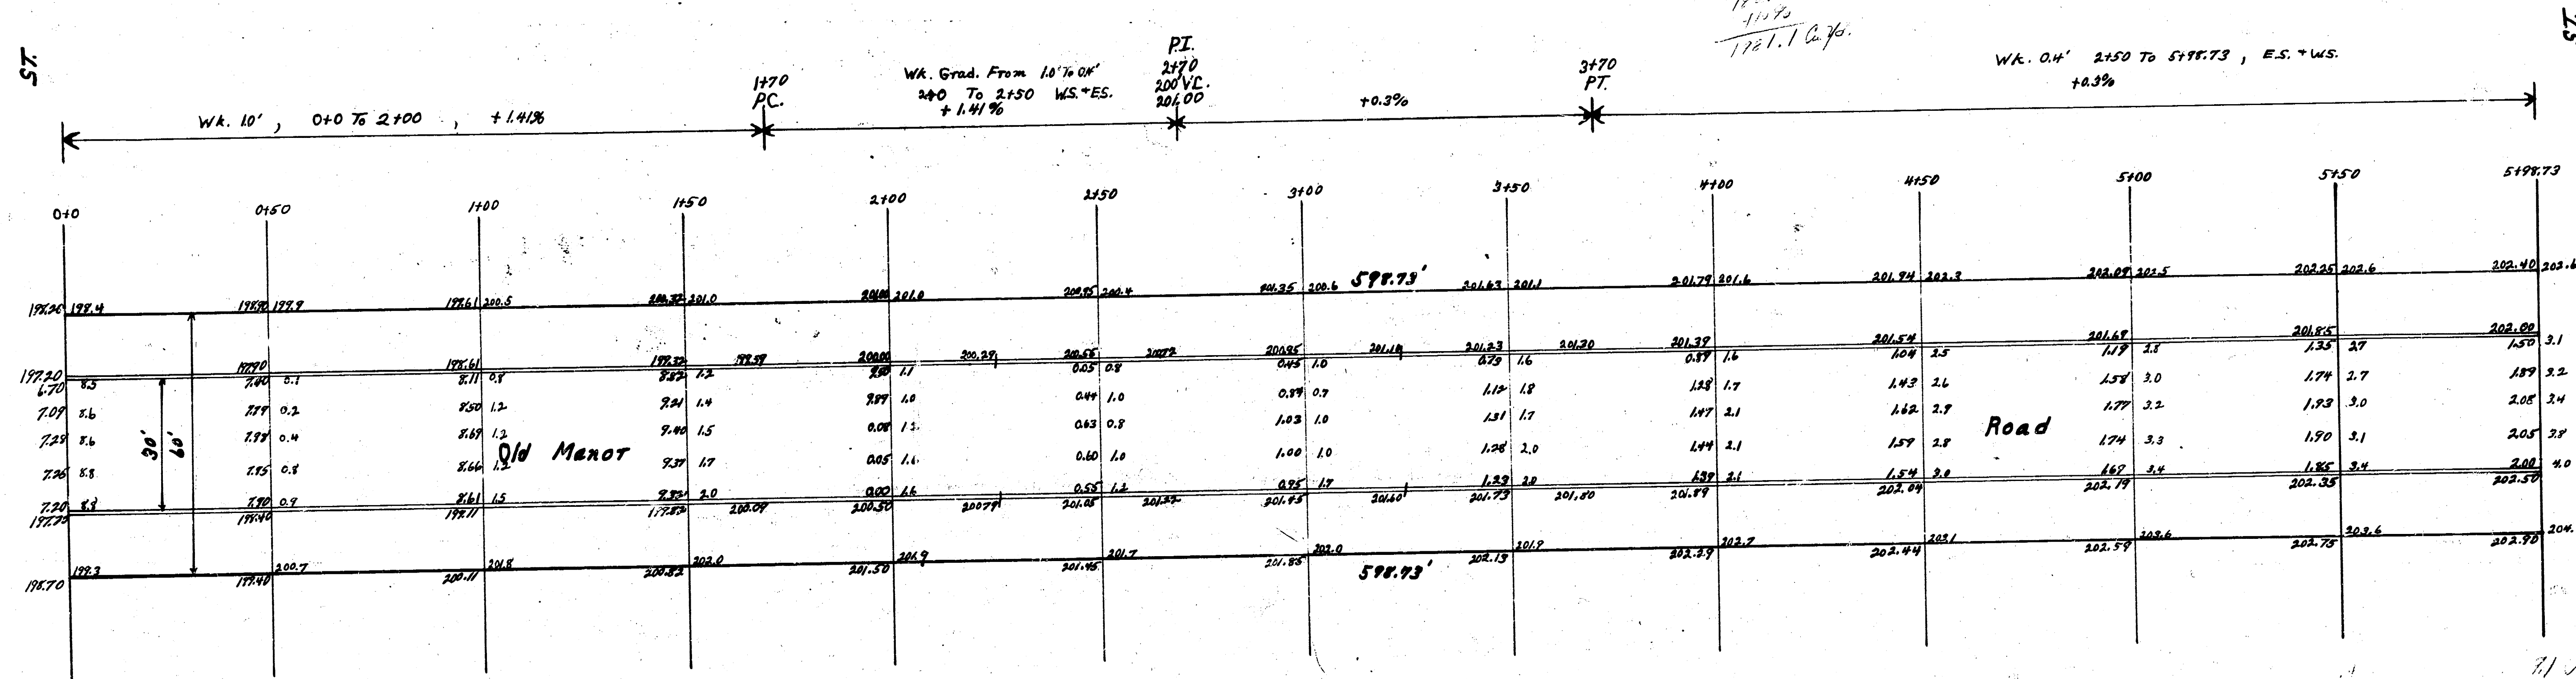

Old Manor Road
 NL 9th S.L. 10th
 30' Conc. + Cb.
 City of Wichita, Kansas
 L.K. White City Engineer
 February 1948 Project C18-4

4 15 4