

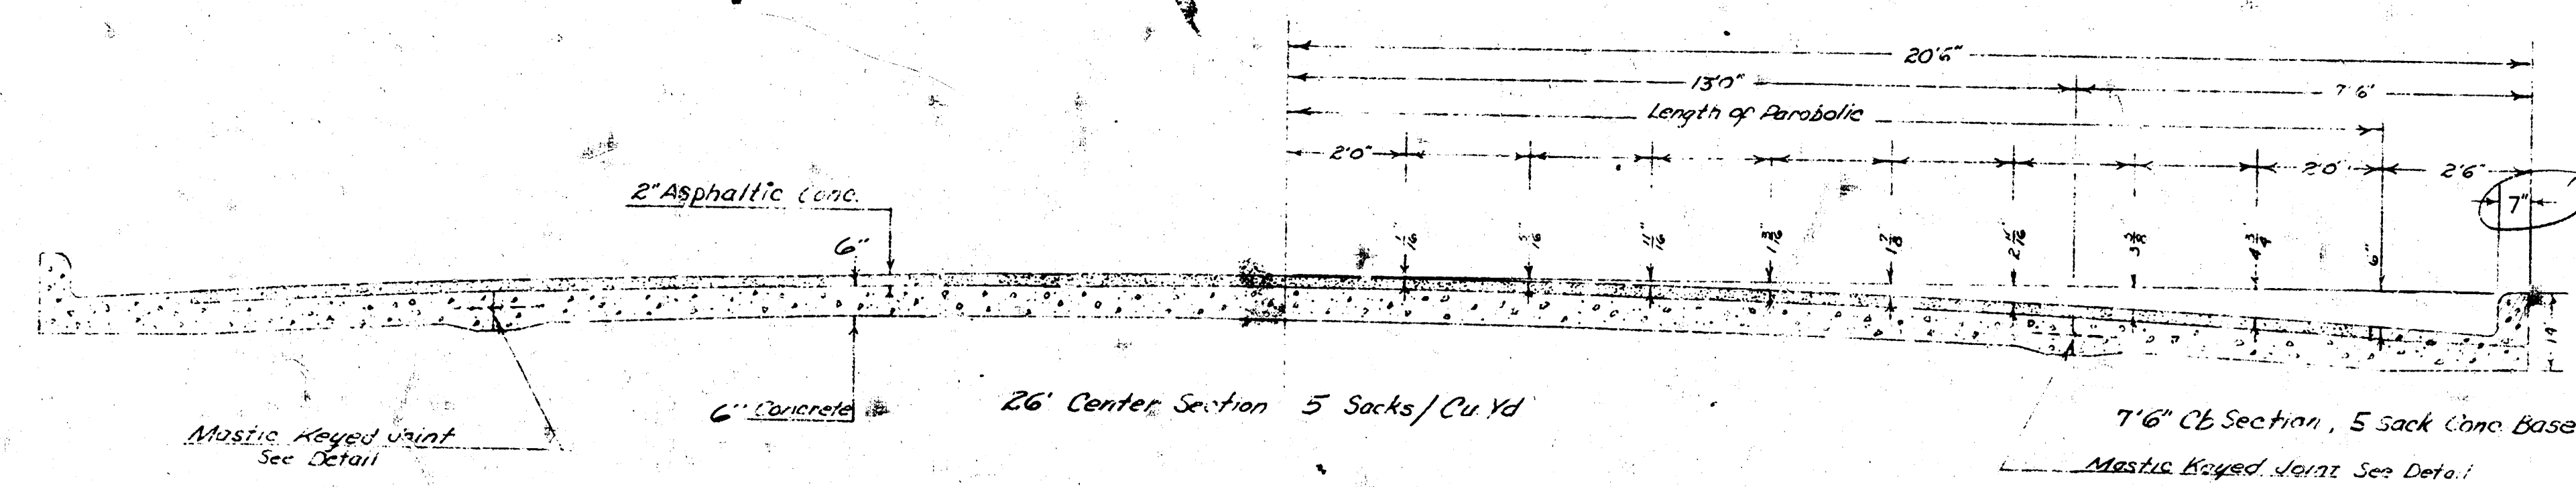


SPEUCE
 N.L. INDUSTRIAL TO E.L. MADISON

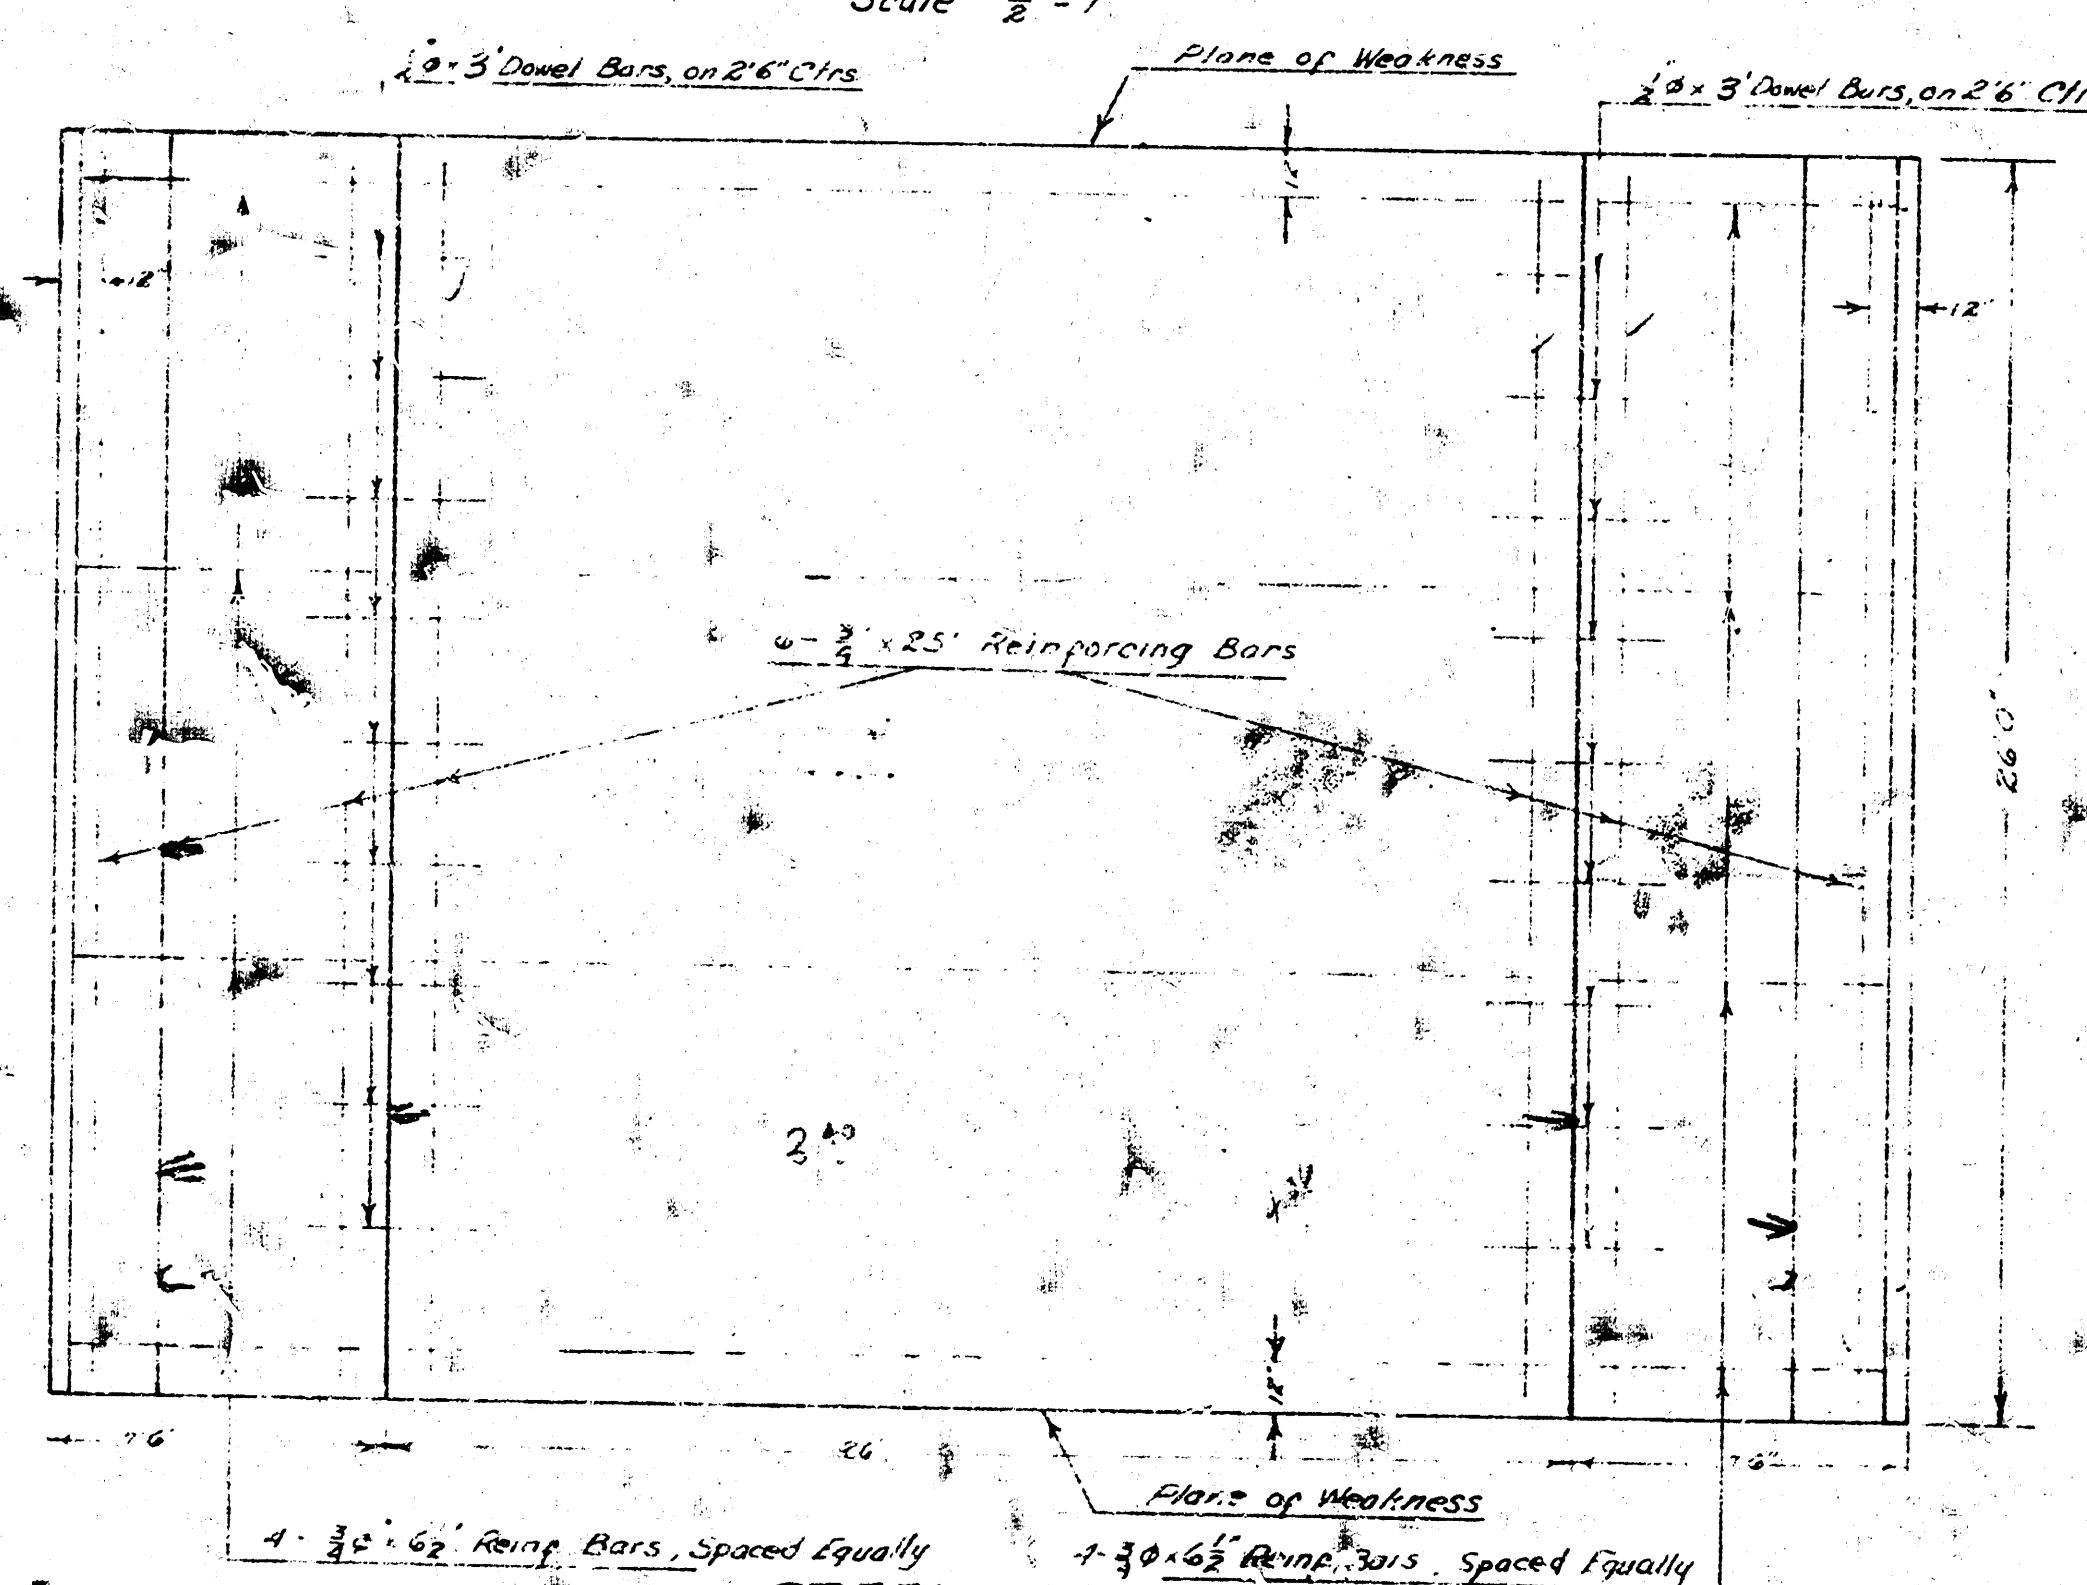


TYPICAL SECTION

Scale $\frac{1}{2}" = 1'$

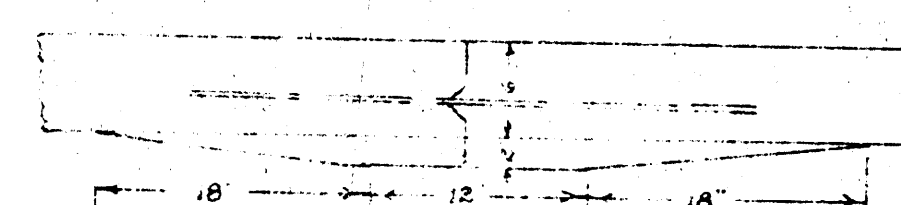


STEEL PATTERN

Scale $\frac{1}{4}" = 1'$

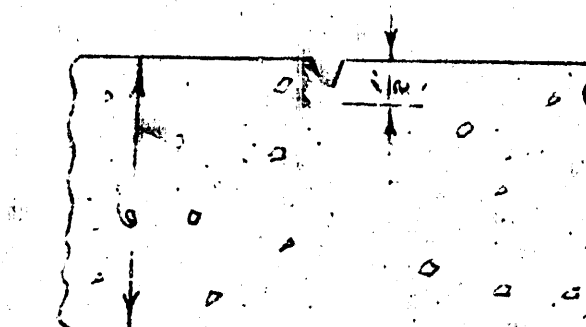

NOTE: STATIONING IS ON E

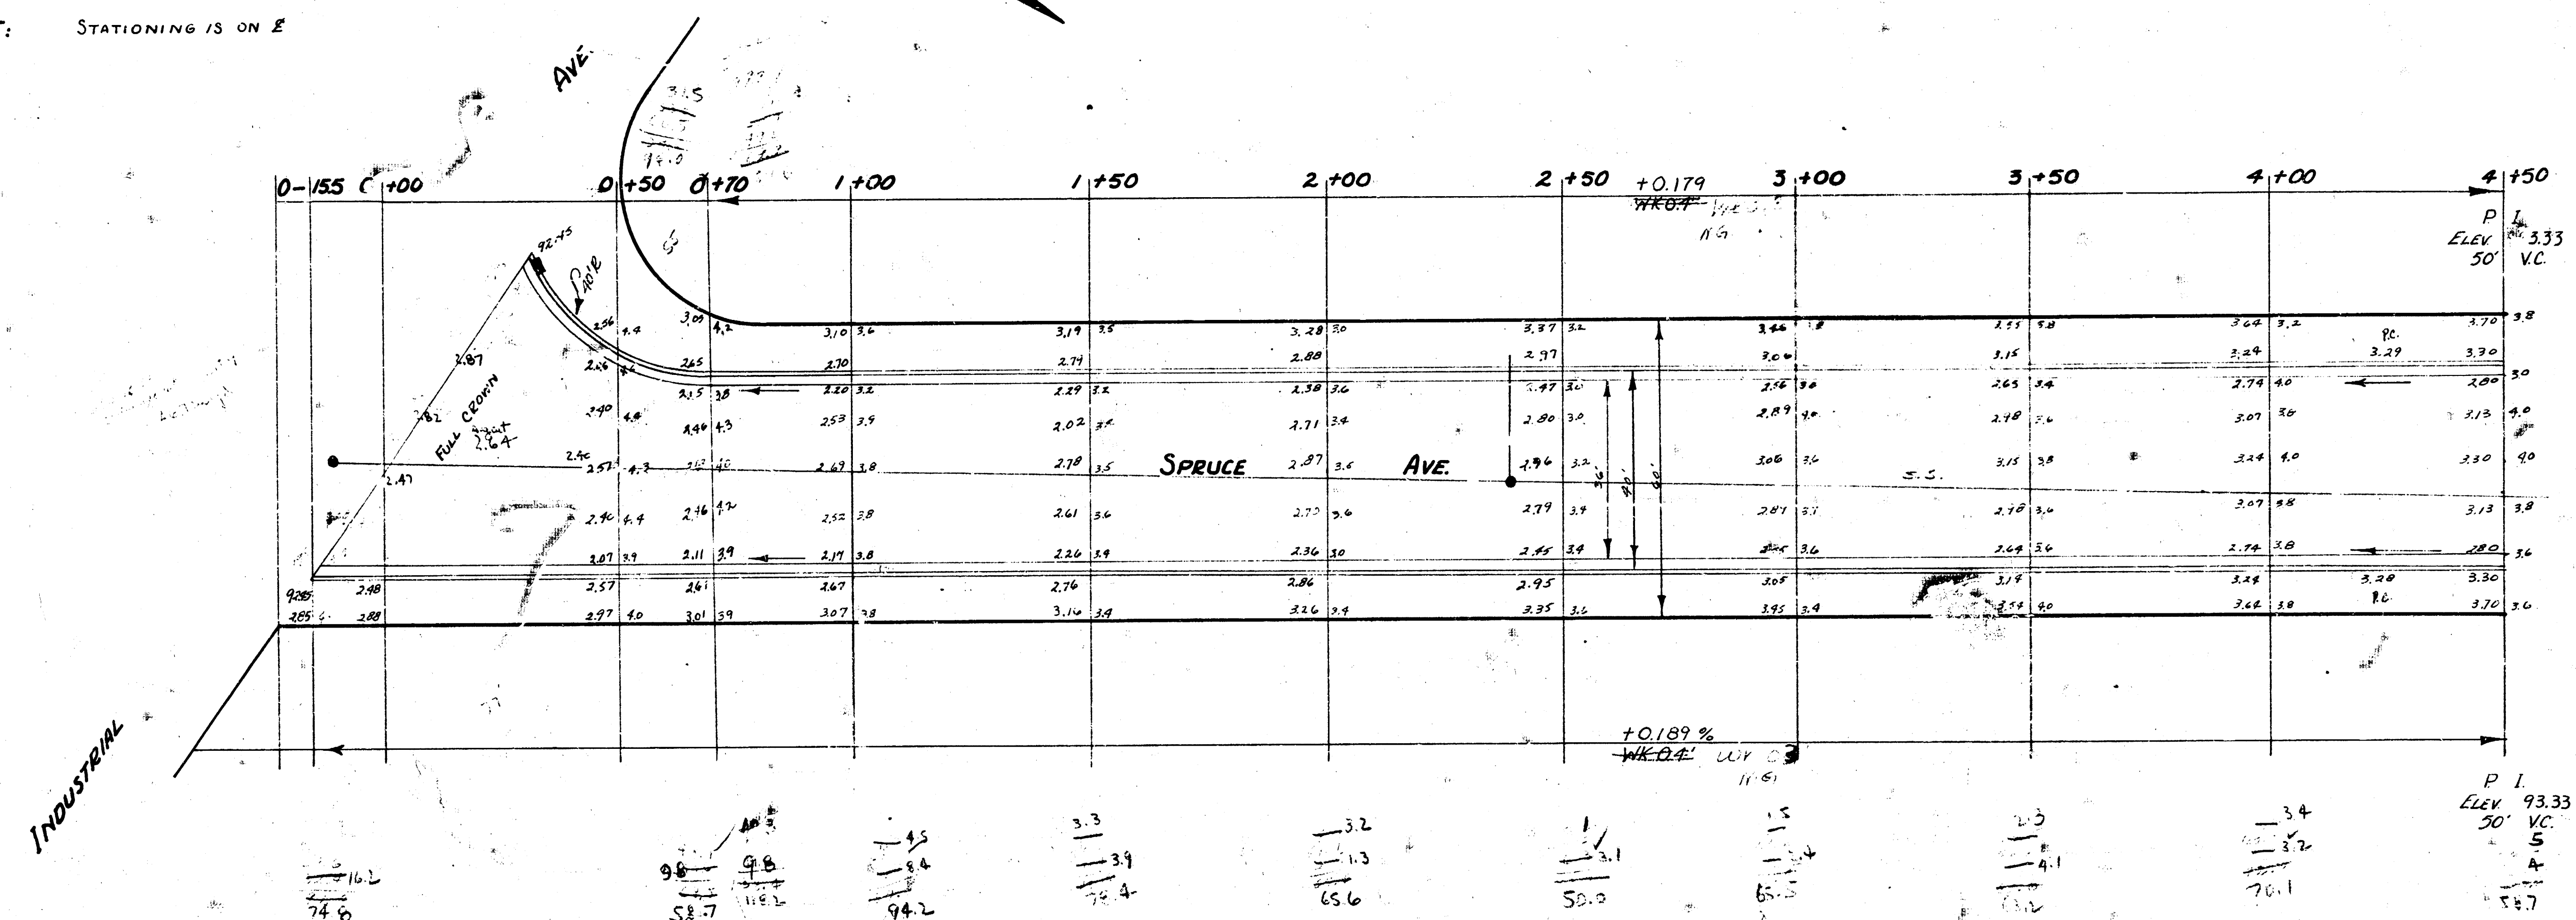

SPRUCE AVE.
N.L. INDUSTRIAL TO EL MADISON
36'-2'-40 AC.
CITY OF WICHITA KANSAS
L.K. WHITE CITY ENGINEER
SEPT 1952 PROJ. NO. C-12-119

