


B.M. 11823 Top W. end conc. pipe N.S. Frisco RR. @ W.S. Grove.  
 B.M. 11542 6" in Globe ctr wk.E. back of cb. S.E. corner Spruce & Murdock.

Prop.  
 27.9  
 32.8  
 56.7  
 41.1  
 52.3  
 42.1  
 254.9  
 - 13.0  
 241.9 cu. yds.

City  
 18.1  
 8.0  
 5.0  
 32.2  
 + 12.70  
 30.1 cu. yds.

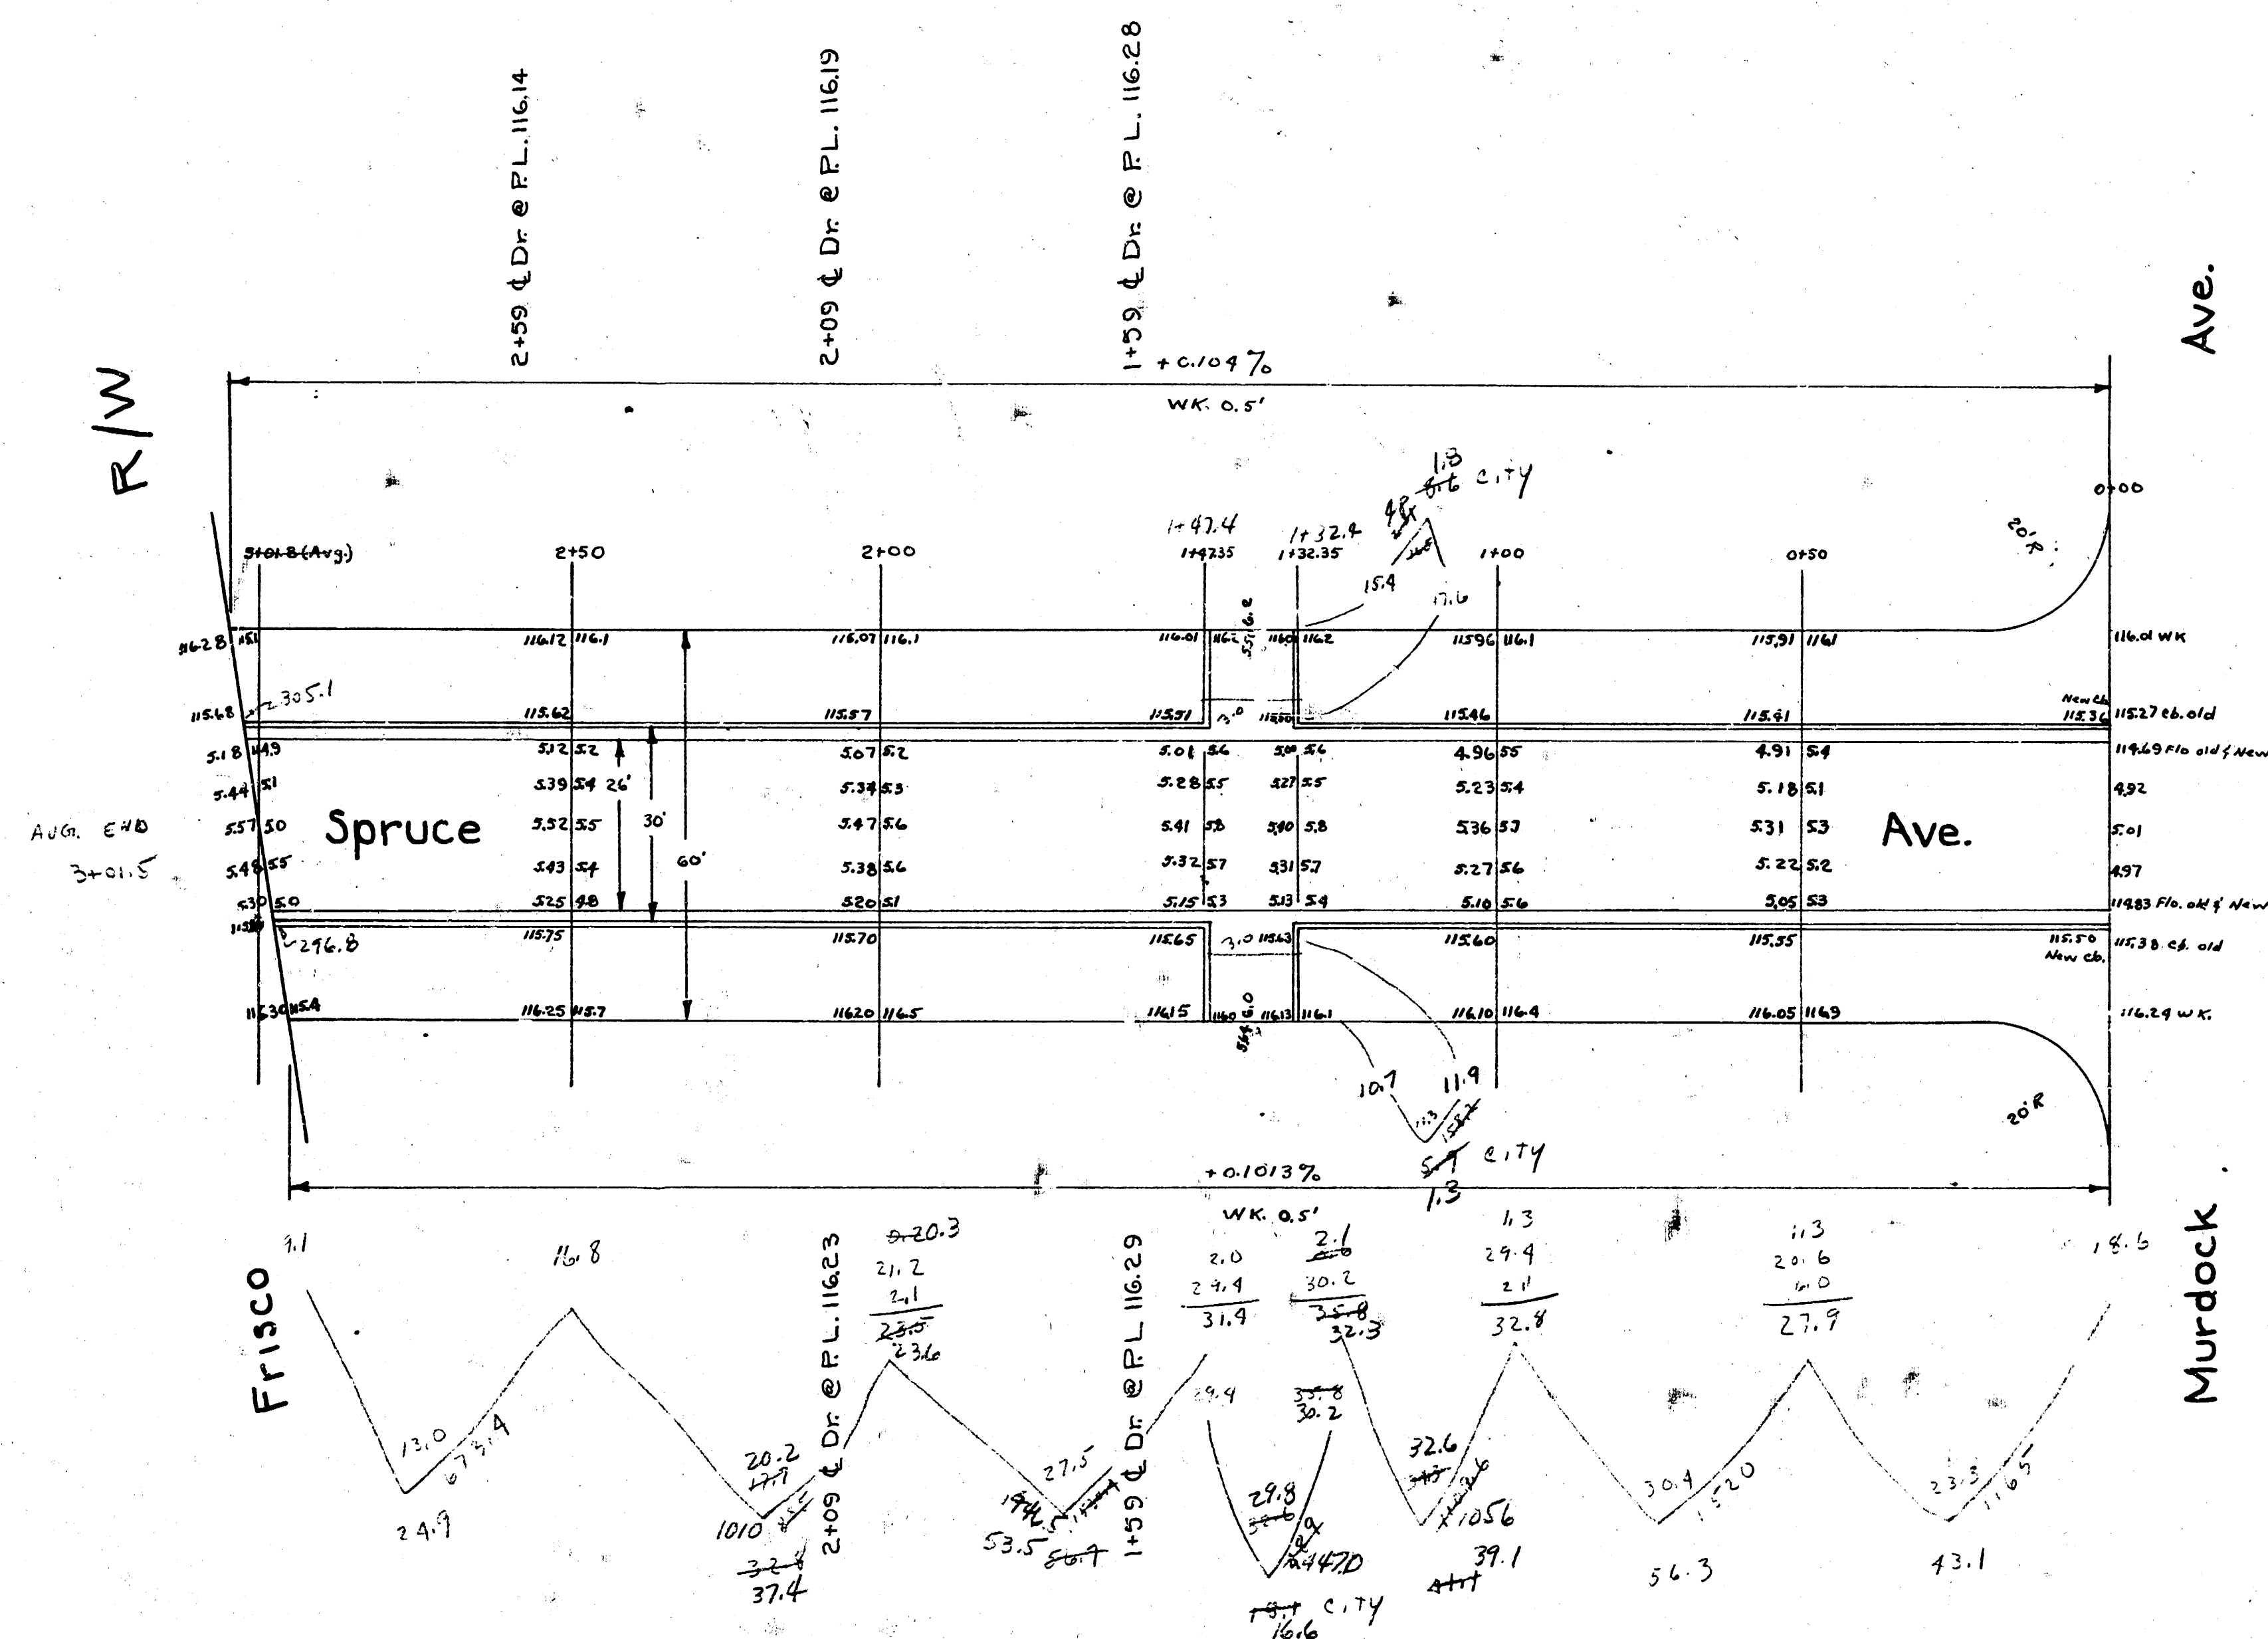

Spruce Ave.  
 S.L. Murdock - N.L. Frisco R/W  
 26'-2'-30' A.C.  
 City of Wichita, Kansas  
 L.K. White - City Engineer  
 March 1949 Proj. # C-19-33