
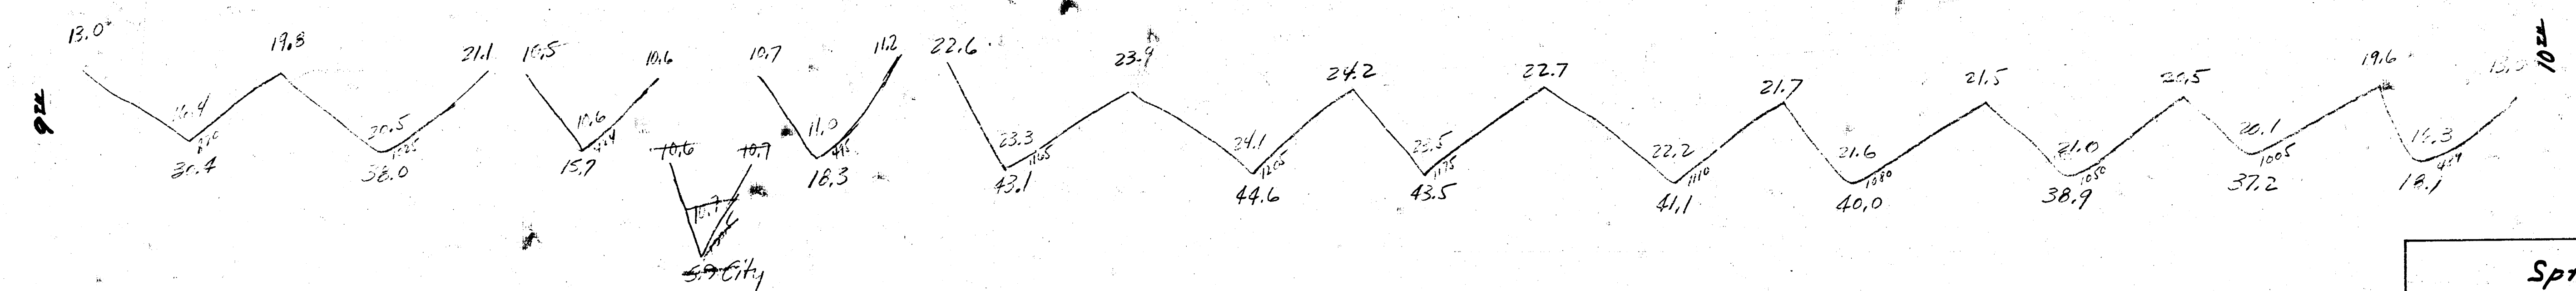


B.M. 118.76 "H" in H.I. Co. 25 Center W.H. W. N.M. Cor. 2nd & Spruce
 B.M. 118.02 "O" in Gable W. End. N.W. Cor. 1st & Spruce

Prop.
 30.8
 38.0
 15.7
 18.3
 43.1
 44.6
 43.2
 41.1
 40.0
 38.9
 37.4
 16.1
 12.0
 24.2
 44.8
 470.4 cu Yds.

City
 5.9
 6.1
 12.0
 +10%
 Total 13.2 cu Yds.

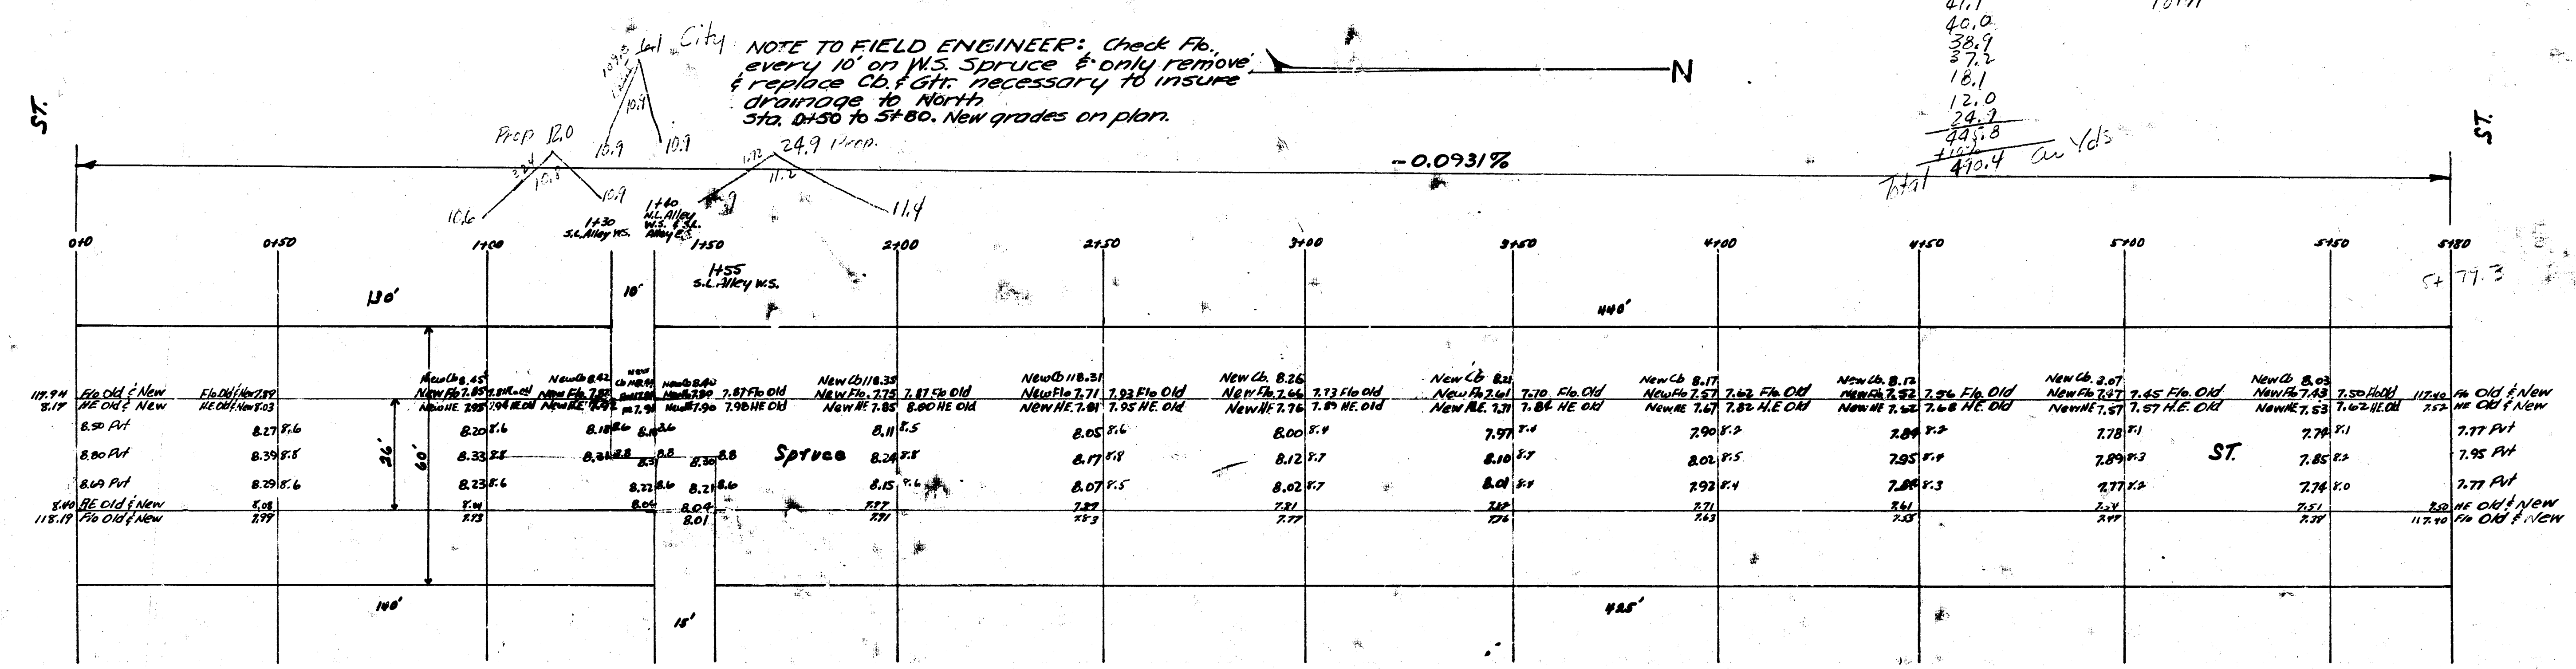


Spruce ST.
 N.L. 9" — S.L. 10"
 21' Conc.
 City of Wichita, Kansas
 L.H. White City Engineer
 May 1948 Project 018-54

1942
 SPRUCE ST - N.L. 9TH TO S.L. 10TH
 CB + GTR ONLY

NOTE: PAVE ALLEY
 INTERSECTIONS

NOTE: PAVE 10TH ST
 INTERSECTION

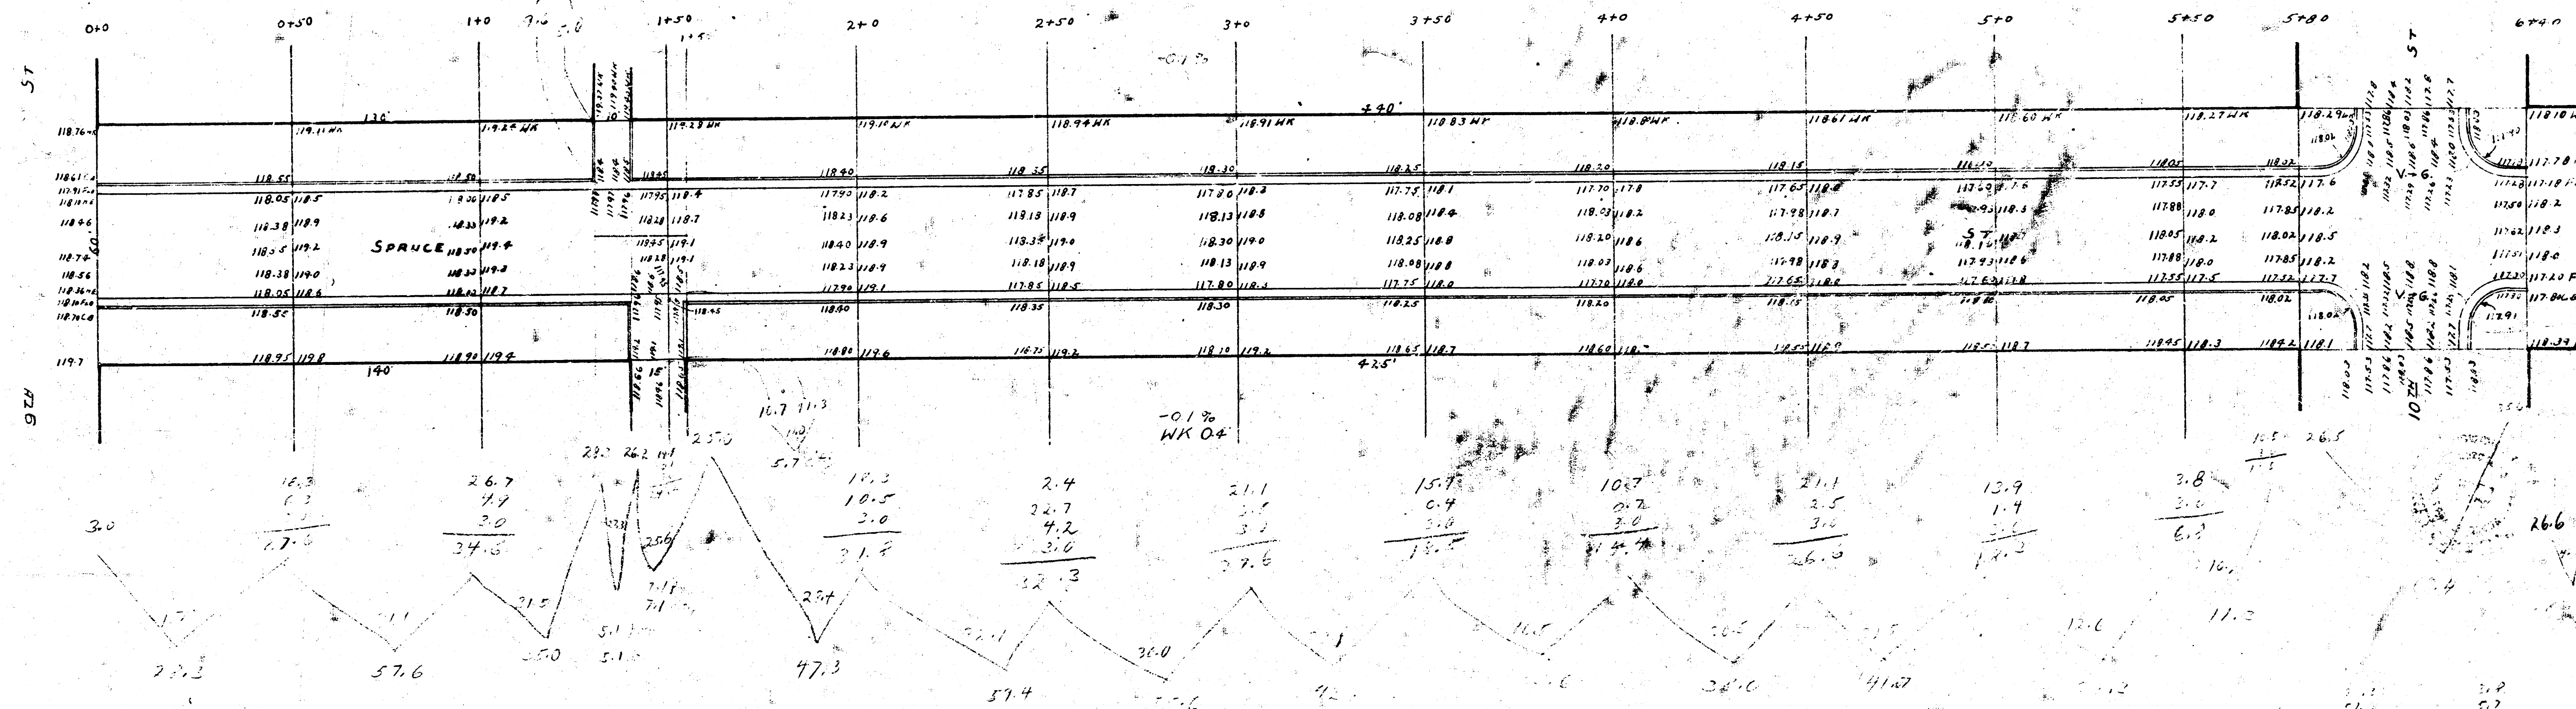

B.M. 118.05 C IN CAMPBELL SS INT D N.W. 10TH + SPRUCE
 B.M. 118.77 S IN STEELE, B.M. N.W. N.W. 9TH + SPRUCE