

B.M. "C" IN RITCHIE TOP COR. N.E. HOODSON W.S. MINNESOTA 98.26
 B.M. "N" IN MUGLER. P.P. N.W. COR. MINNESOTA & STAFFORD 99.32


TOTALS

PROP.	WIDENING
491.4	294.6
+10% 540.5	+10% 324.1
CU. YDS. Exc.	CU. YDS. Exc.


Note: Field Engr

Exc. Intersection to match pavt.
 on Swan & Stafford. X-section for exc.
 install C.B. & lead to M.H.

SCALE: 1"=20'

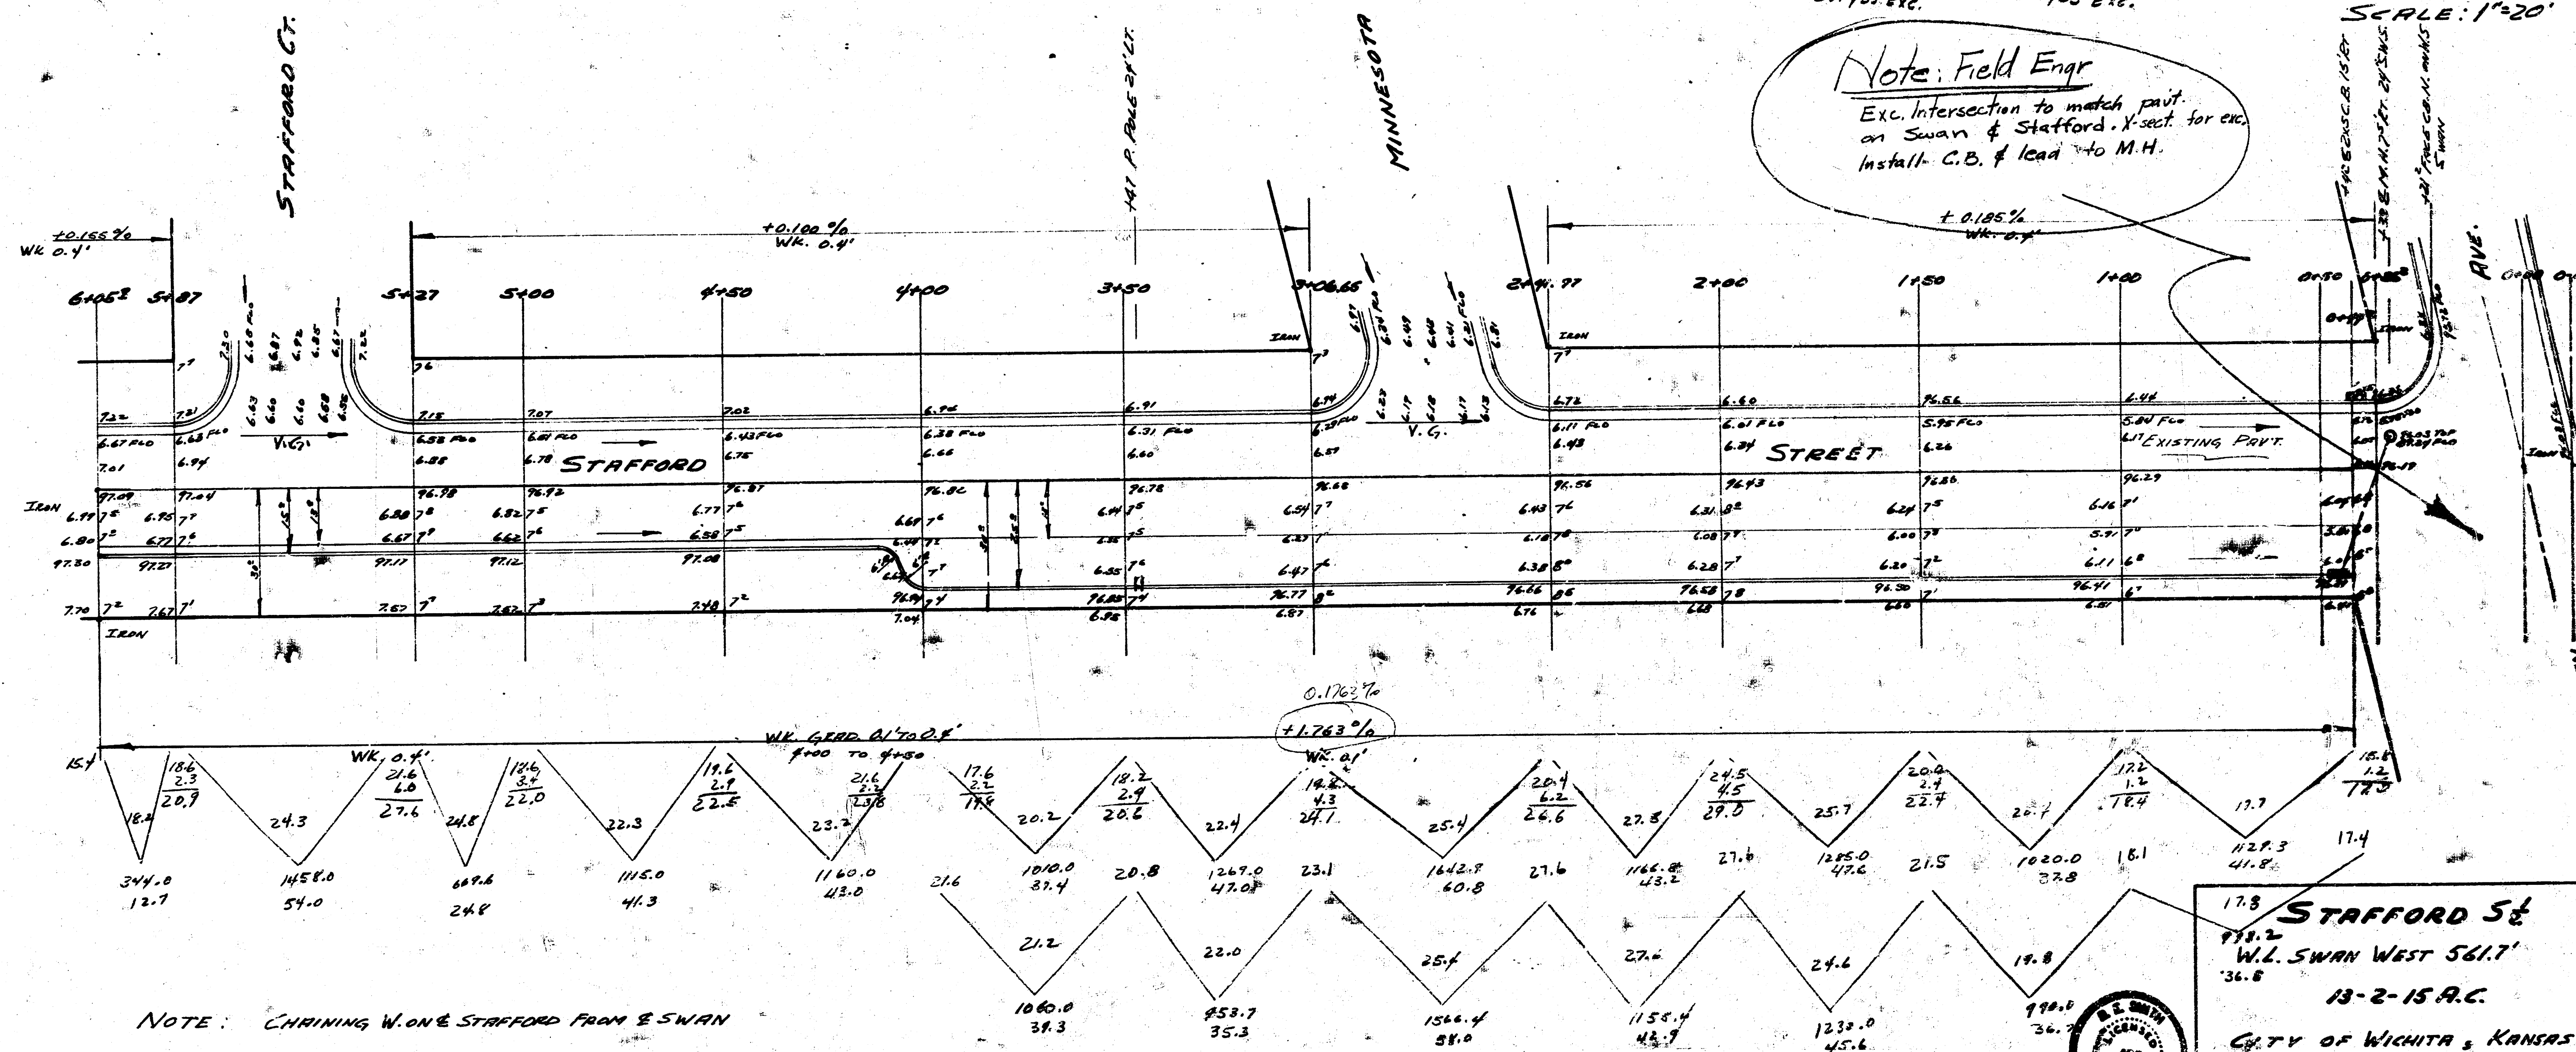

STAFFORD St
 W.L. SWAN WEST 561.7'
 13-2-15 A.C.
 CITY OF WICHITA, KANSAS
 L.K. WHITE CITY ENGINEER
 JULY 1952 PRIVATE

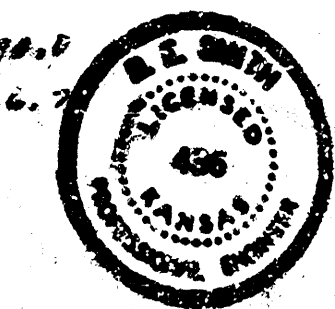

1 5 5 3