


BM 10794 SPIKE N.S. H.P. SE SENECA & STILLWELL
 BM 10599 STEP BENCH N.S. H.C.R. S.S. STILLWELL MIDWAY BET WALNUT & HAZLET
 B.M. 10341 6" IN GROUND TOP OF W. END RET. S.S. STILLWELL & W.L. OSAGE
 BASE LINE ON 4' BET IRON 20 SENECA & IRON 20 OSAGE

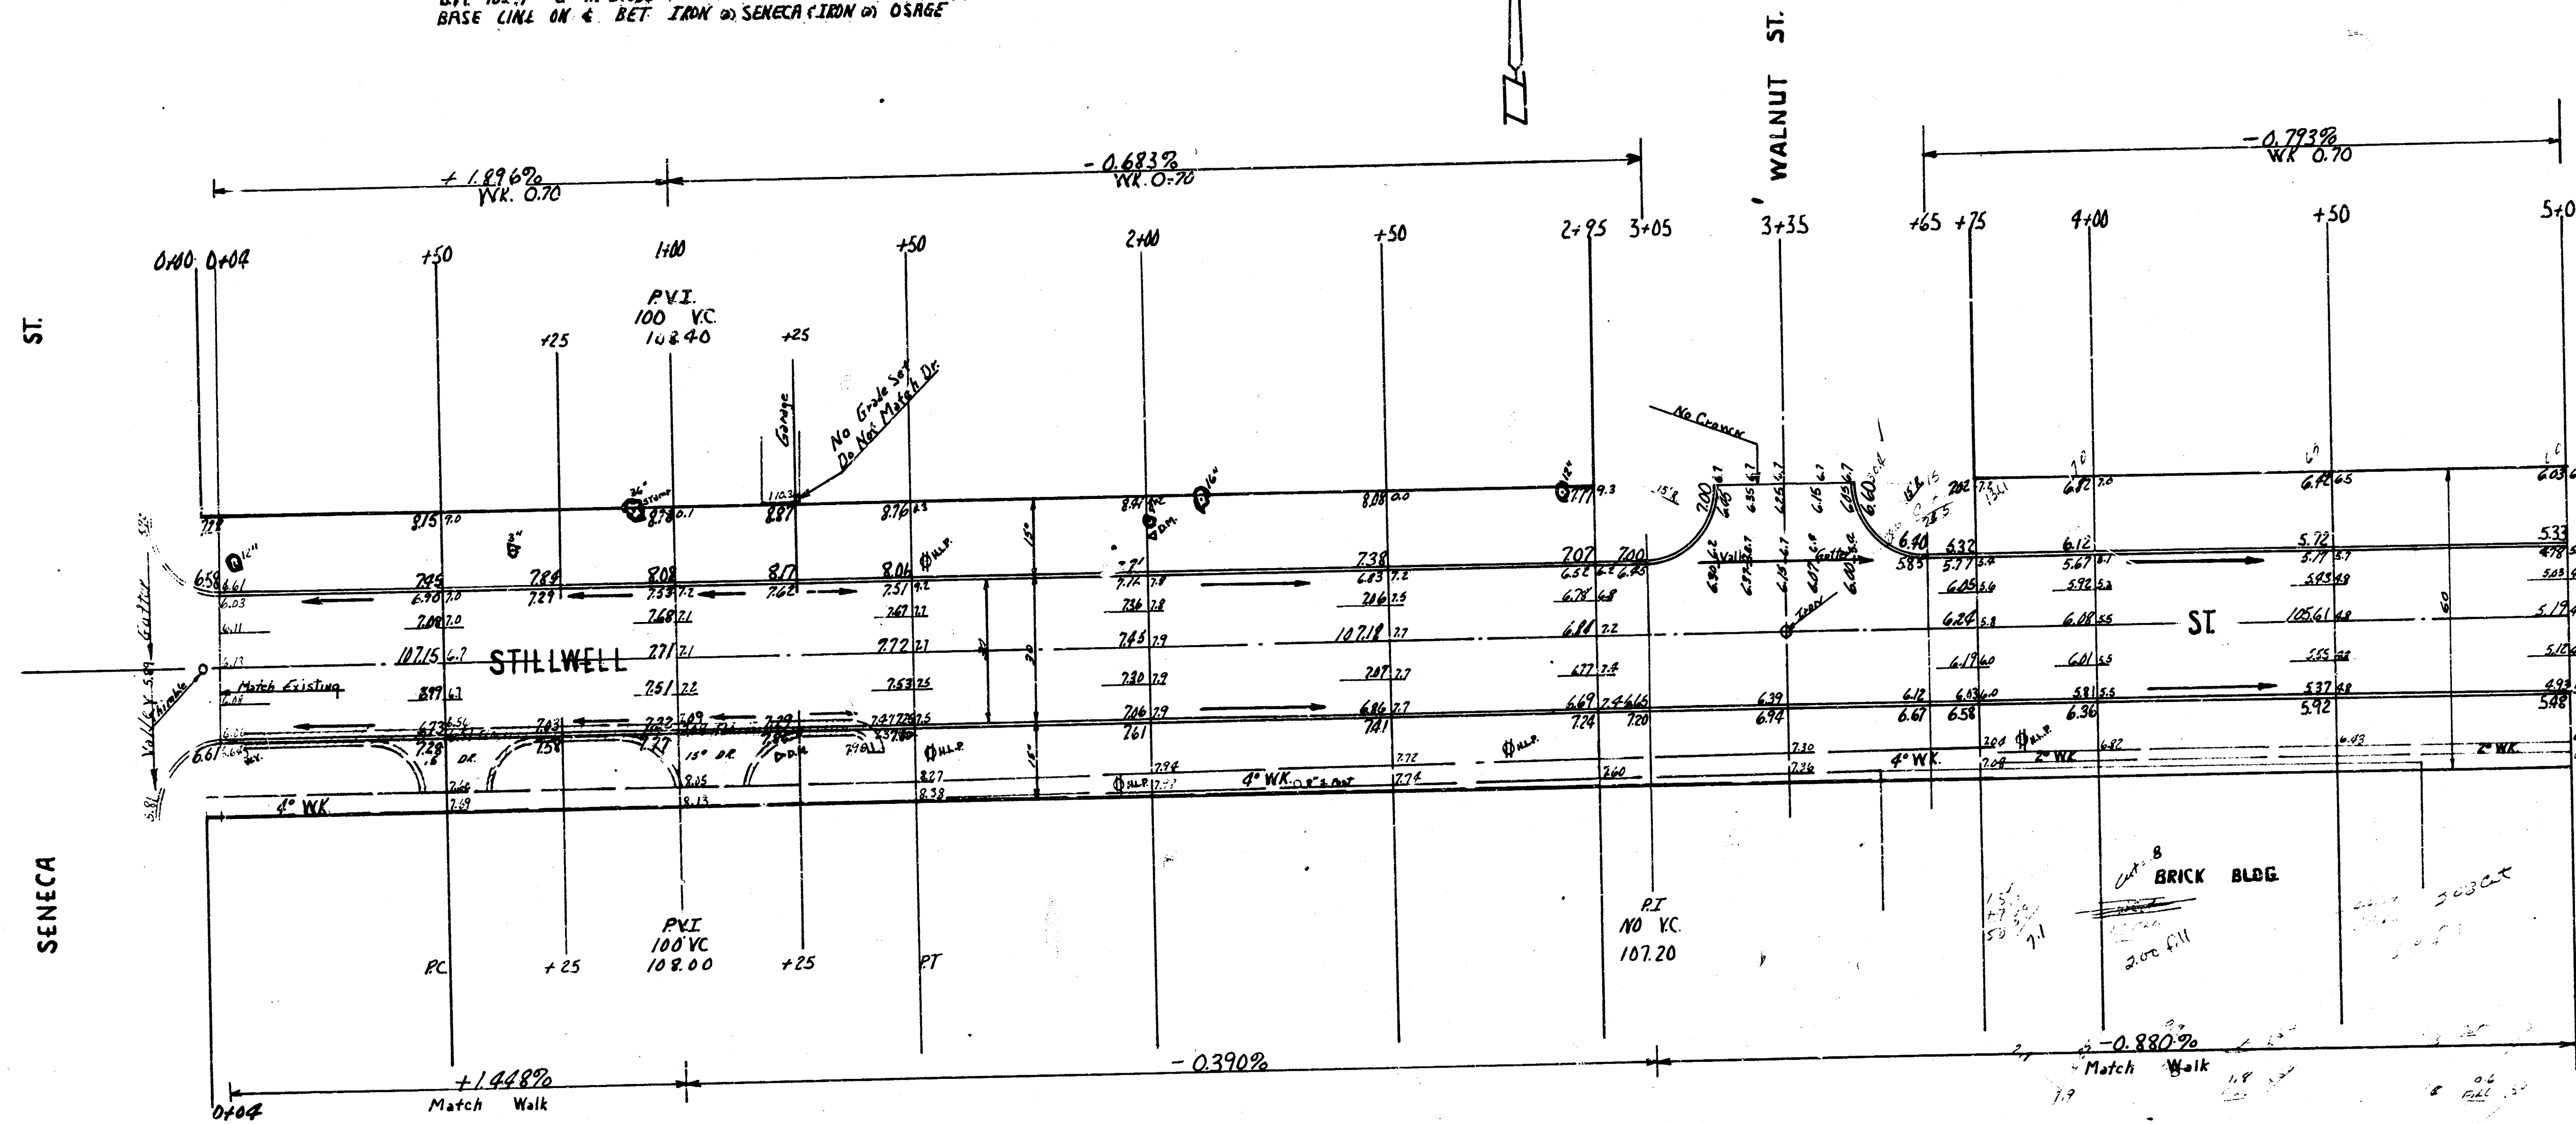

Notes to Contractor:
 All Entrance Pipes Are to Be Disposed Of In Accordance With
 Instructions Of City Dirt Checker

Prop	City	Total
6357	117.2	6474.2
103.636	17	120.636
1993	182	2175.2



STILLWELL ST.
 EL. SENECA W.L. OSAGE
 30' CONC. CB.
 CITY OF WICHITAKAN.
 B.E. SMITH CITY ENGINEER
 DATE Aug. 1939 PROJ. NO C-19-39


County Parking Day Stillwell - Seneca to Walnut

Bill of Materials	Price	Cost
30 Yds 6" Conc Pavt	241.6	3.15
30 Yds 8" Conc Pavt	44.4	4.10
Lin Ft Int Curb	210.0	0.63
Lin Ft Sep Curb	97	0.80
Sp Ft 6" Walk	80.6	0.45
Lin Ft Expansion Jt	2000	0.80
Lin Ft Manhole Jt	233.0	0.80
Lin Ft Street	146.0	0.16
Sp Ft 6" x 6" Wire Mesh	400.0	0.05
Per Yds Excavation	104.9	1.10
Total		1531.93


* Note: Prices as bid on paving Proj. No. C-19-39.
 Stillwell - Seneca to Walnut, except for 8" CONC
 PAVT, MASTIC JT & 6" WIRE MESH. PRICES FOR
 EXCAVATIONS AS OBTAINED FROM EDWARD STEWART
 OF GLOBE CONST. CO.

Measured by Glantz
 Finalized by J. Jones

County Parking Day Stillwell Street Seneca to Walnut PROJ. NO. C-19-39

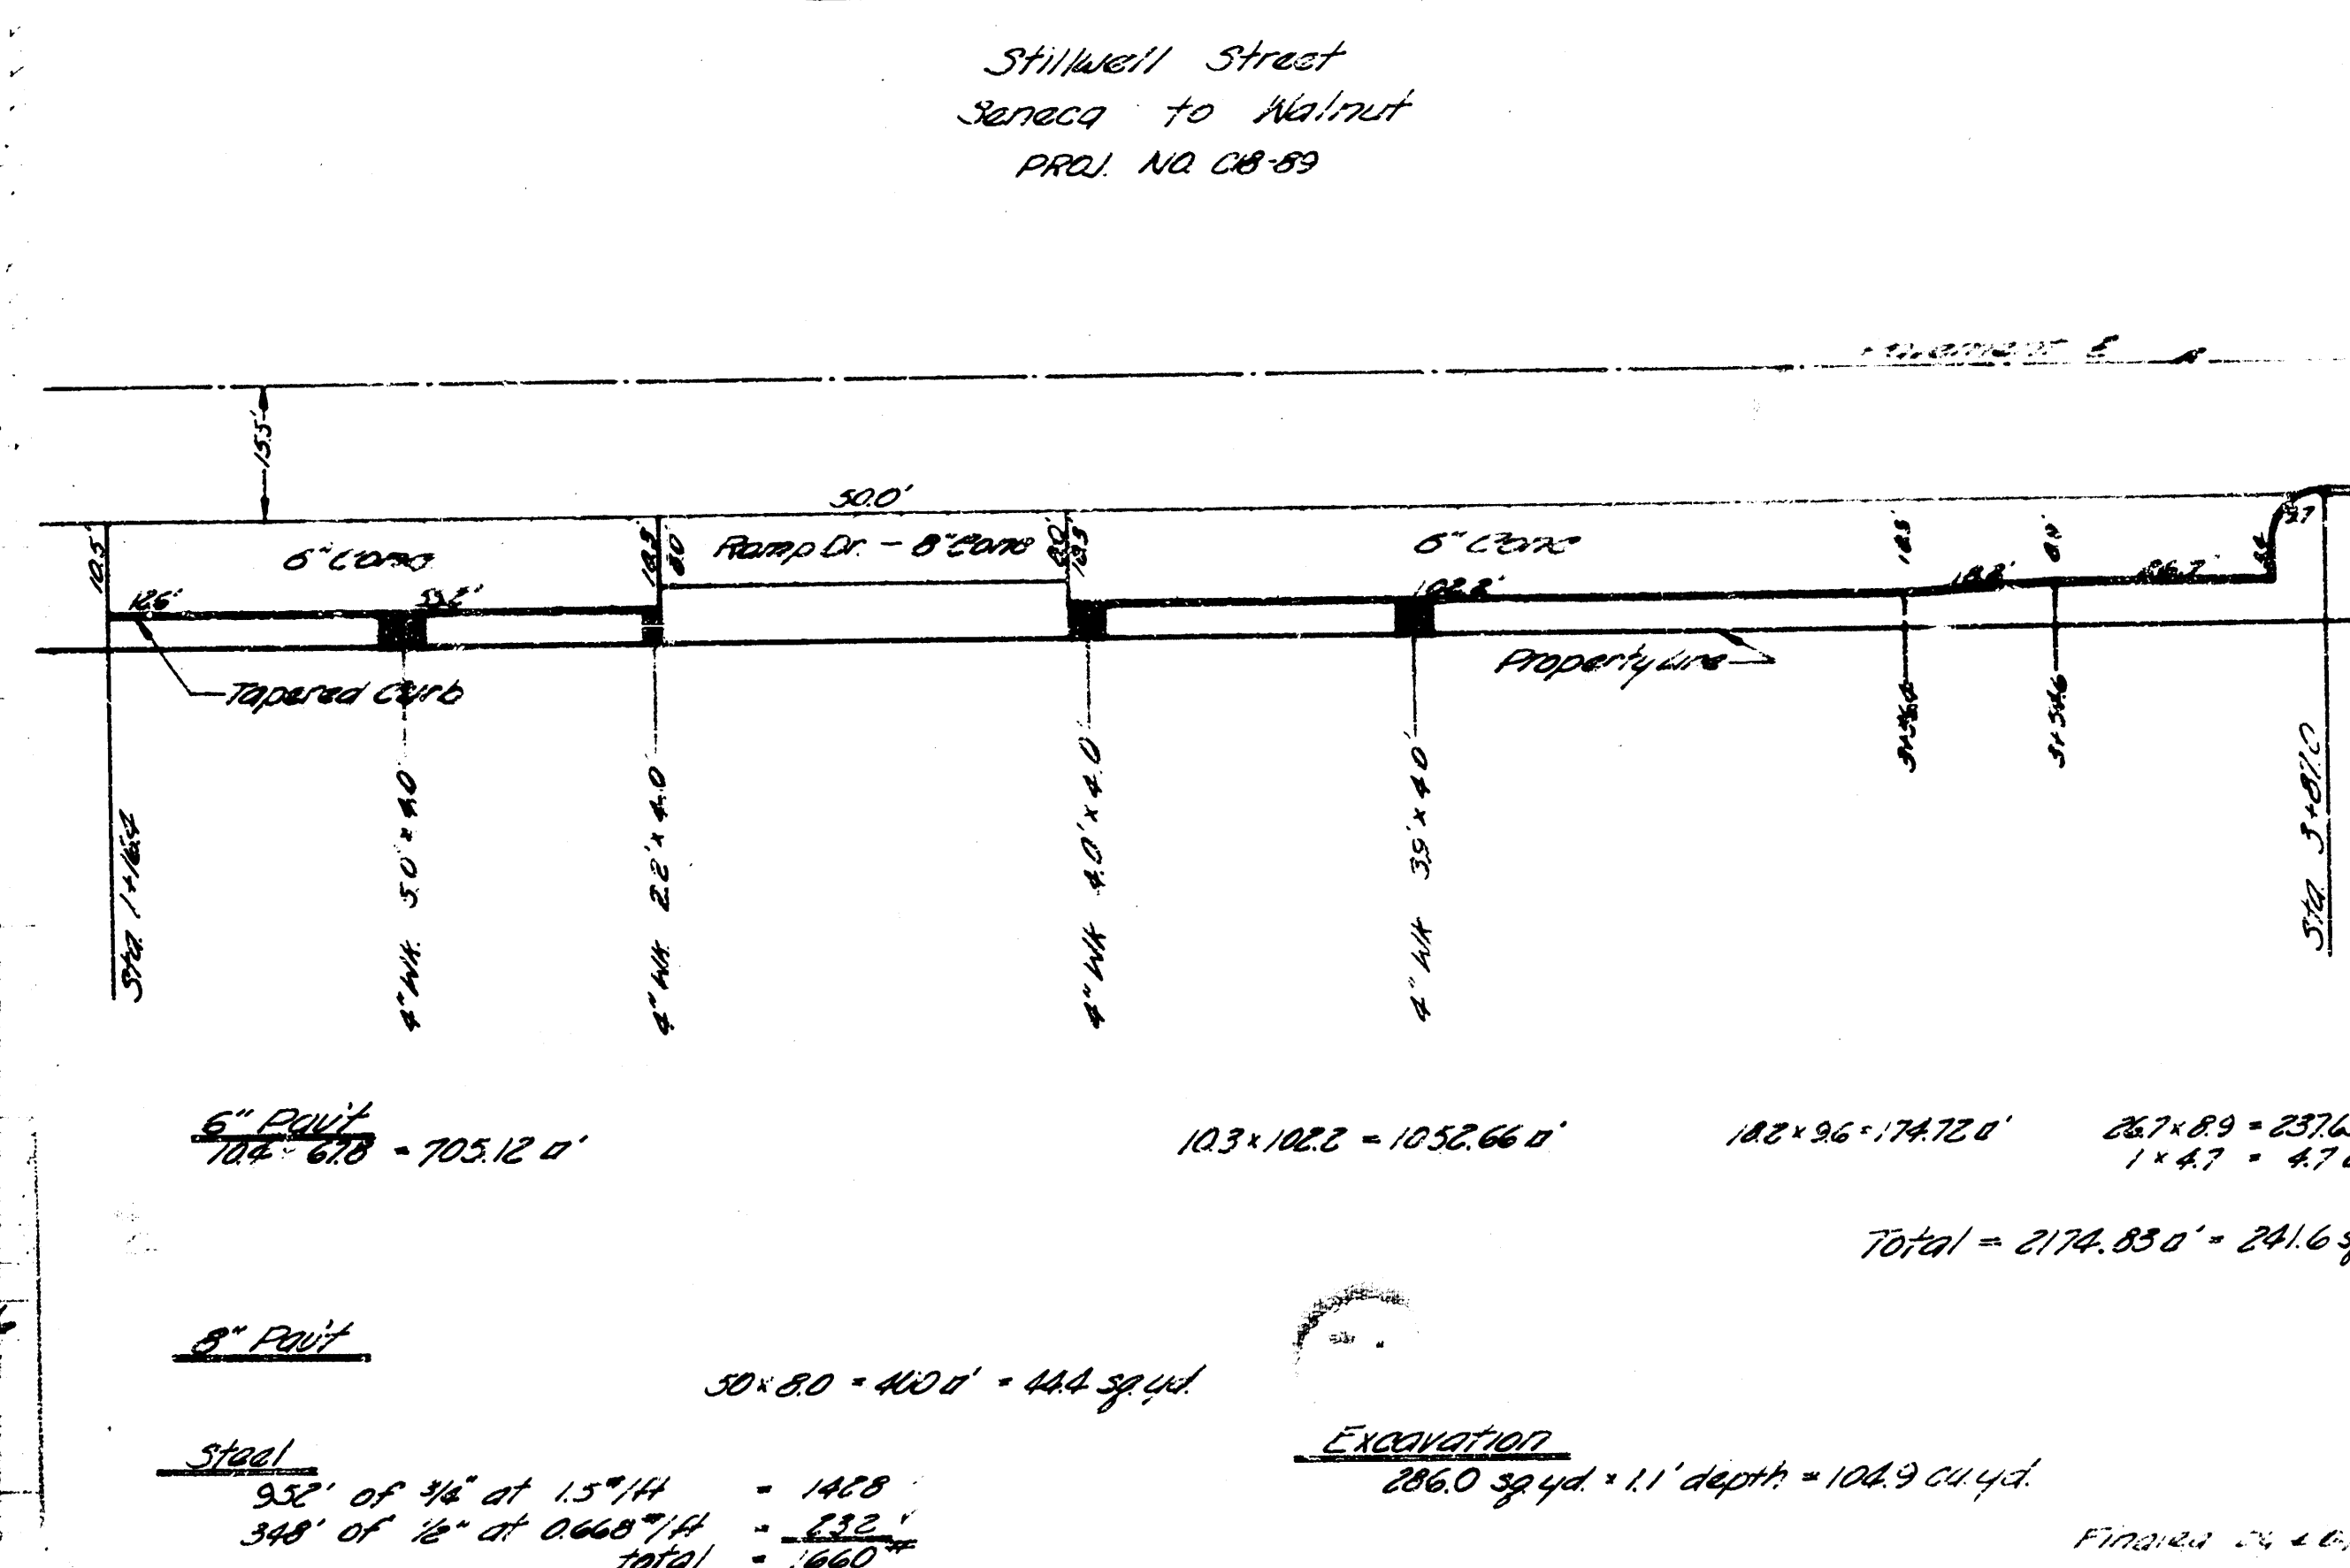

October, '39

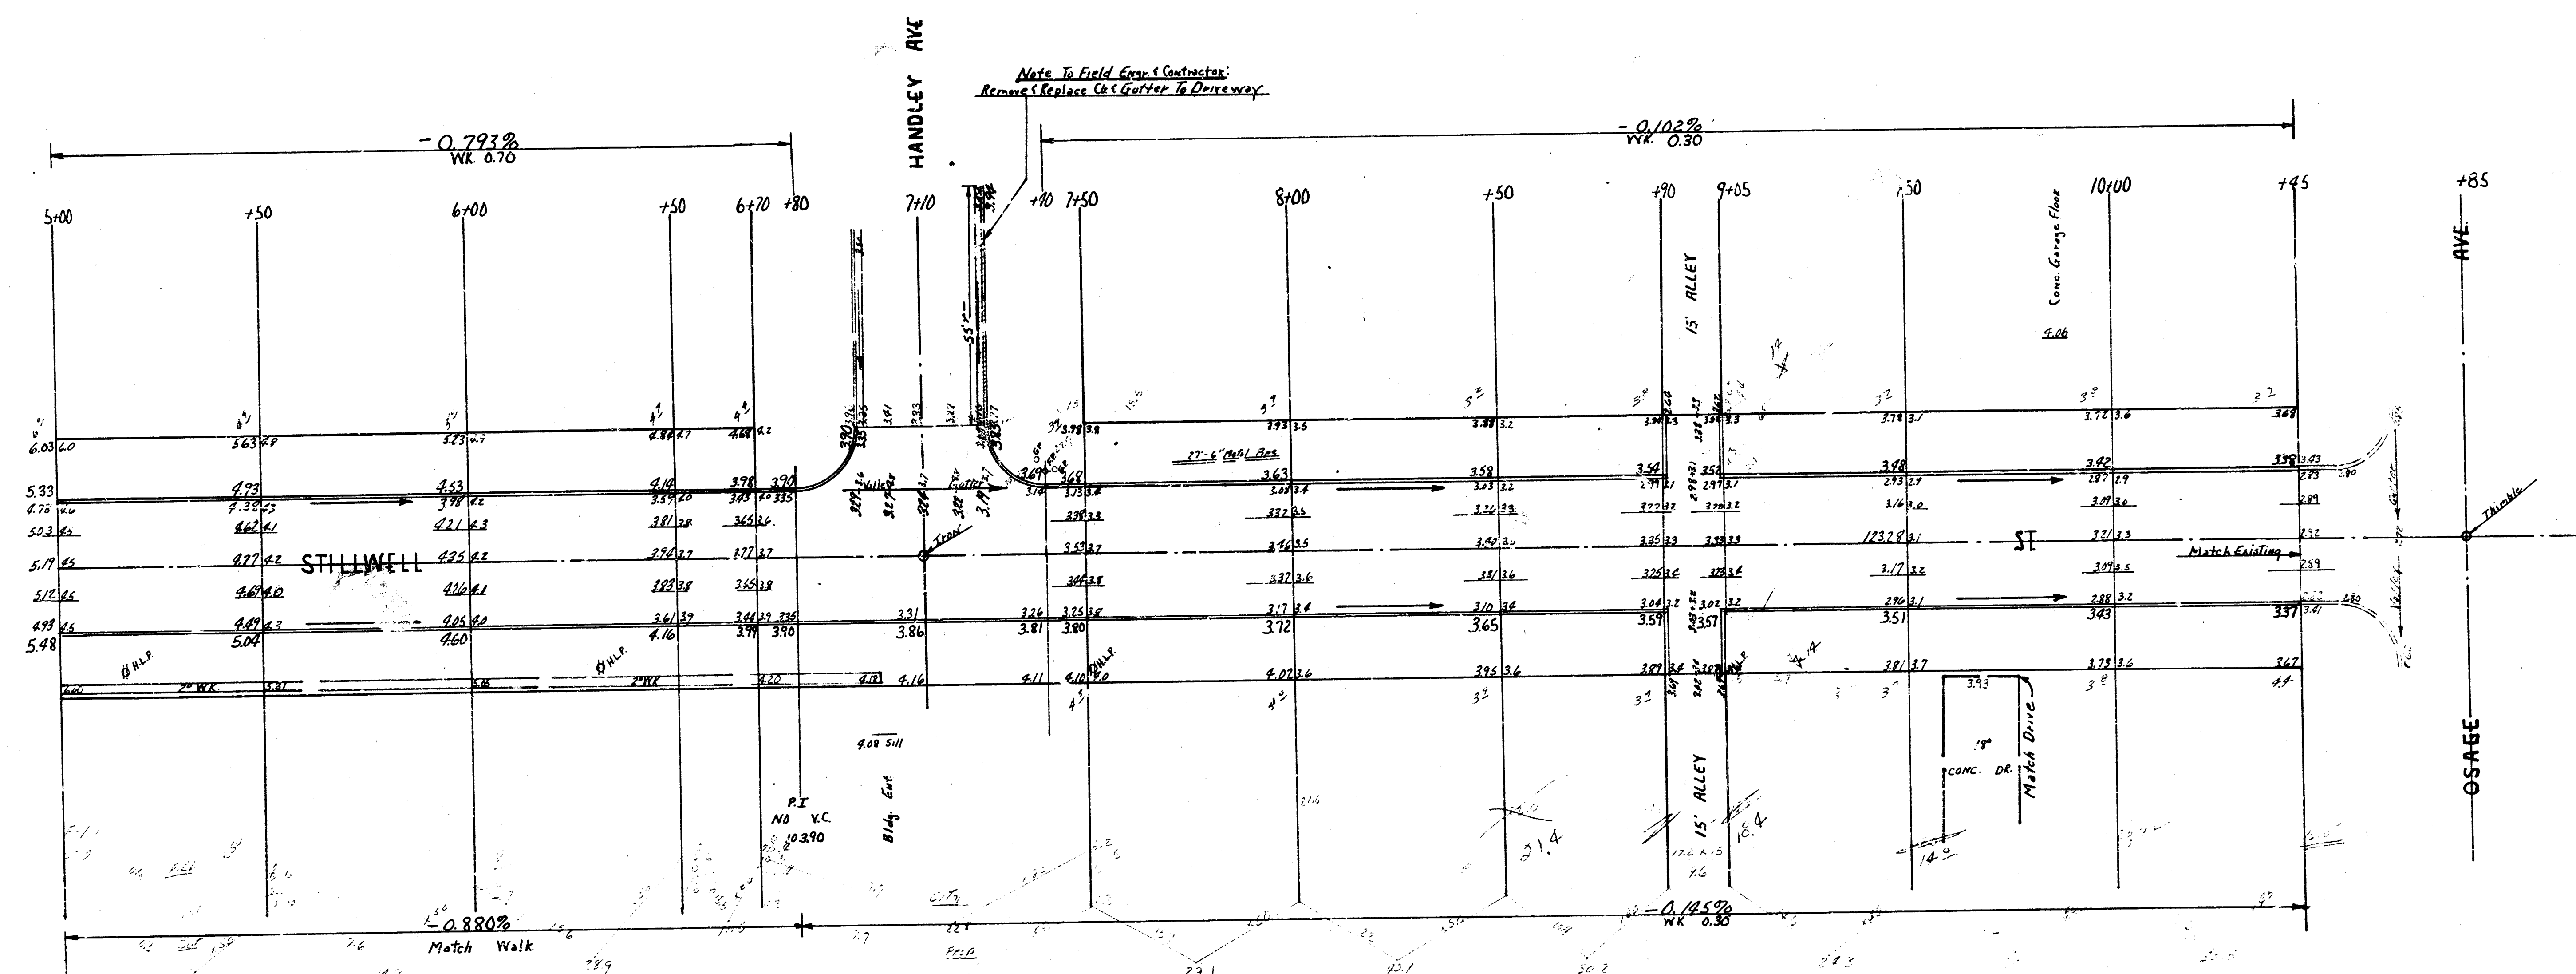

STILLWELL ST
EL SENeca W.L. OSAGE
C-11-29

2/3