


B.M. 152.75 "G" in Globe, W. End ch. ret., N.W. Cor. Sylvan & Orme
 B.M. 157.44 NE. Cr. Lower Step, E. Side House # 401 Beverly Drive
 Note: E.P.L. of Sylvan Lane is Base line for X Section

Note: Starting 15 on E.

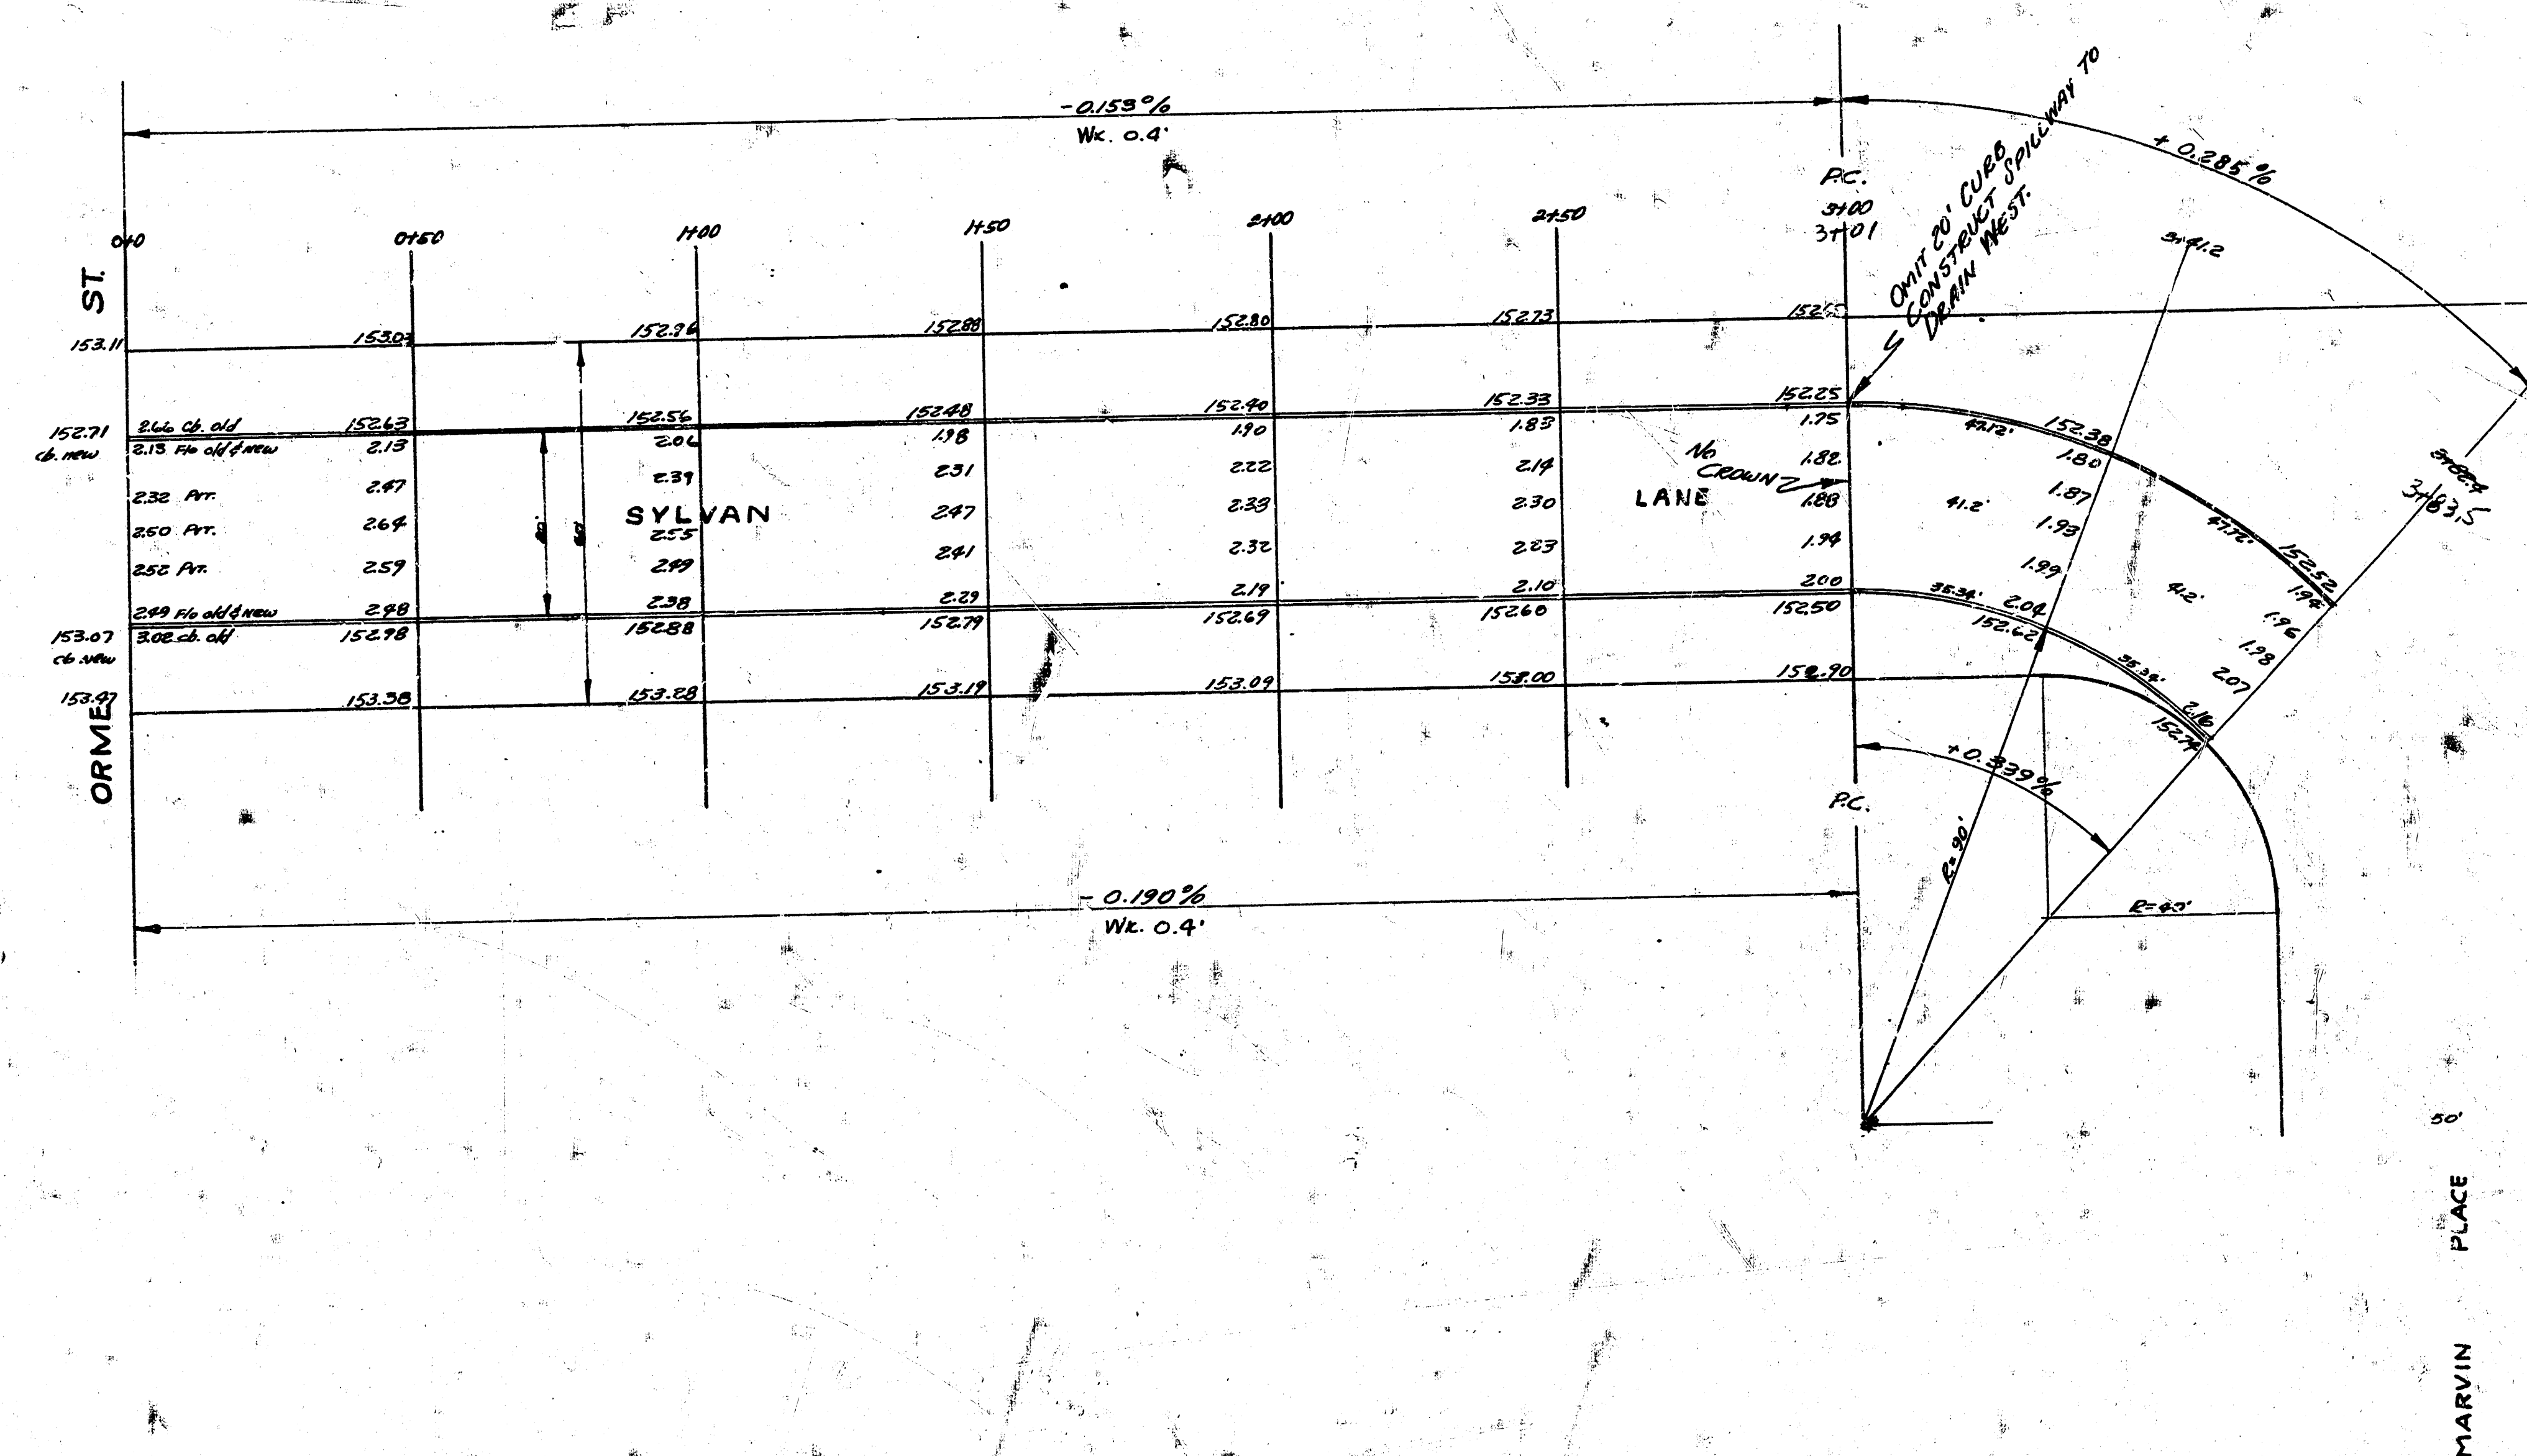

SYLVAN LANE
 NL. ORME to SL. MARVIN PL.
 30' CONC. & CB.
 CITY OF WICHITA, KANS.
 ** ENGINEERING DIV. **
 L.K. WHITE CITY ENGINEER
 JULY 1947